
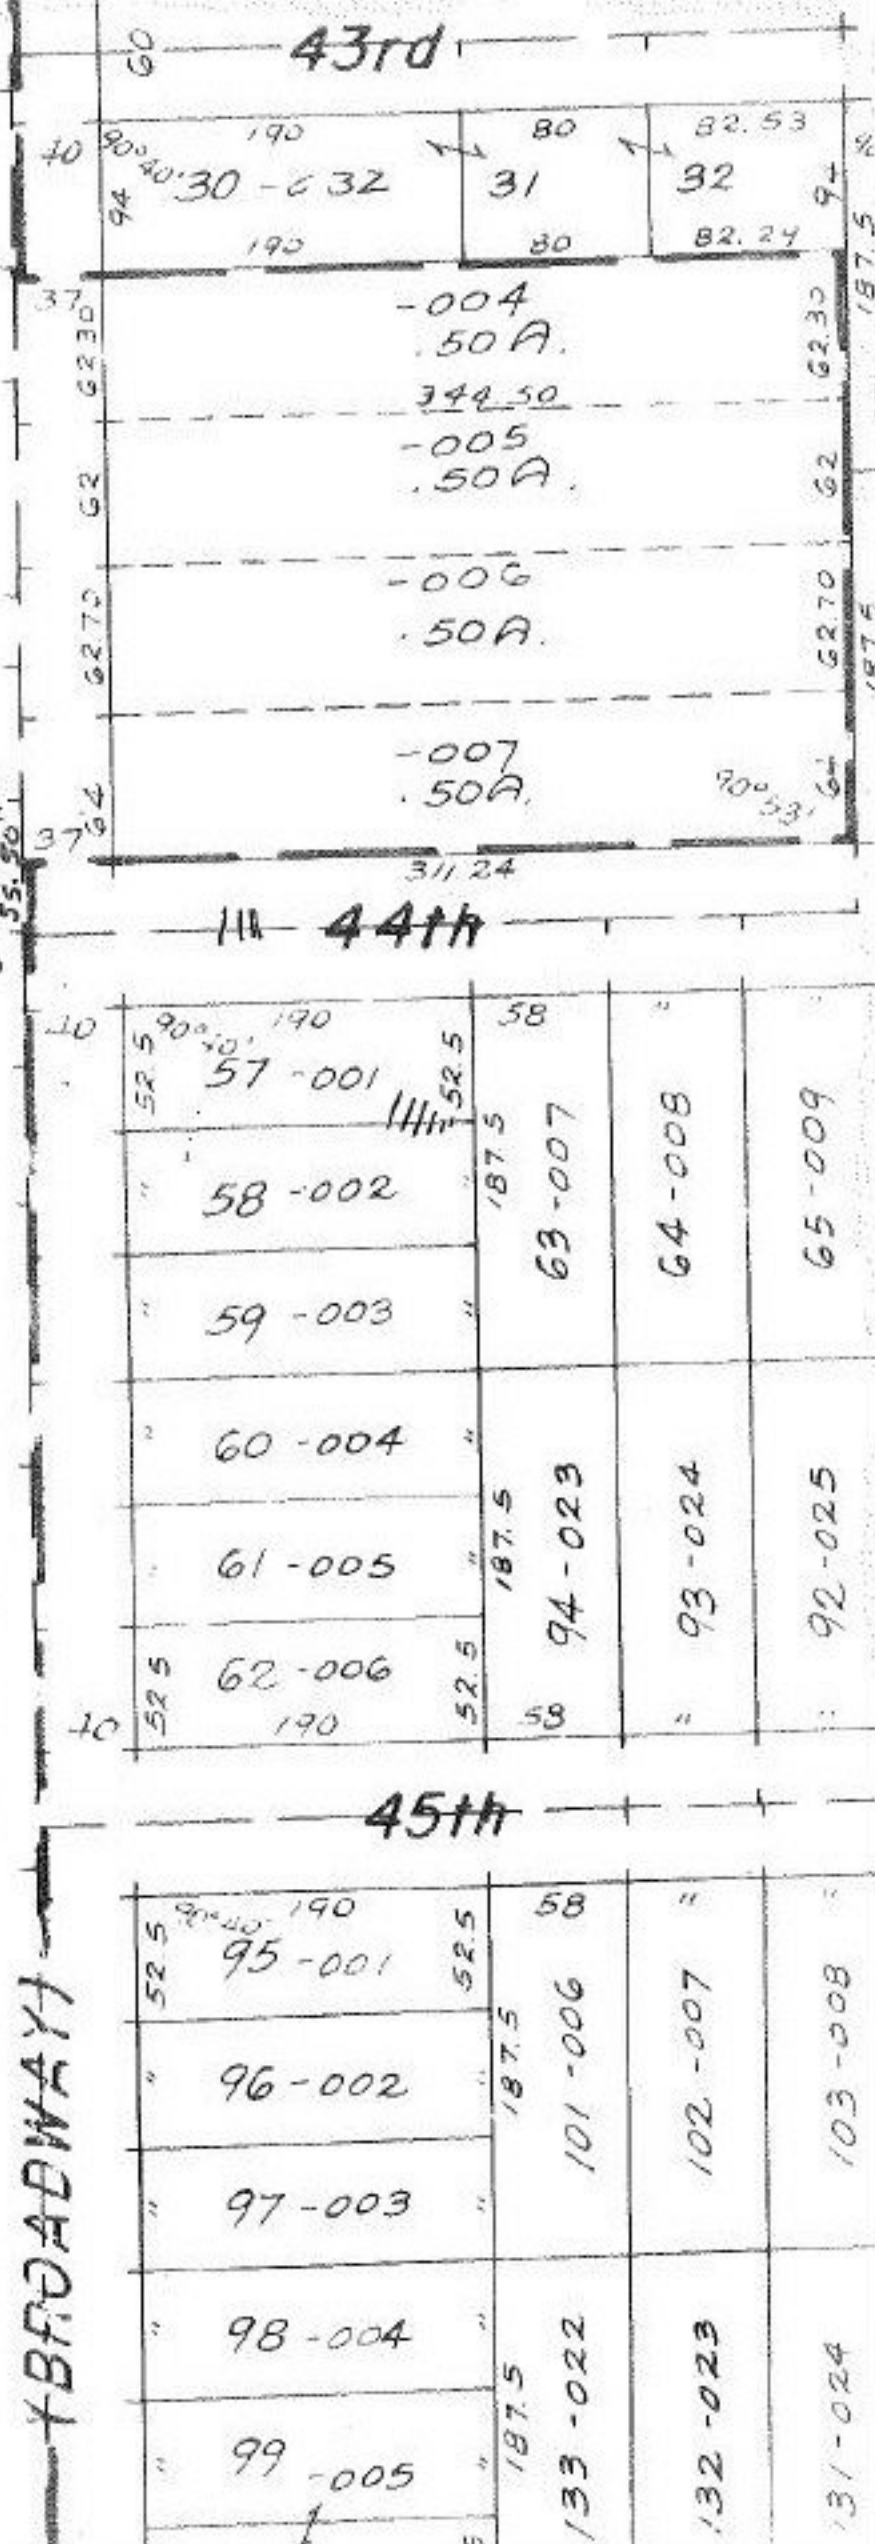


SEE 2-01-003

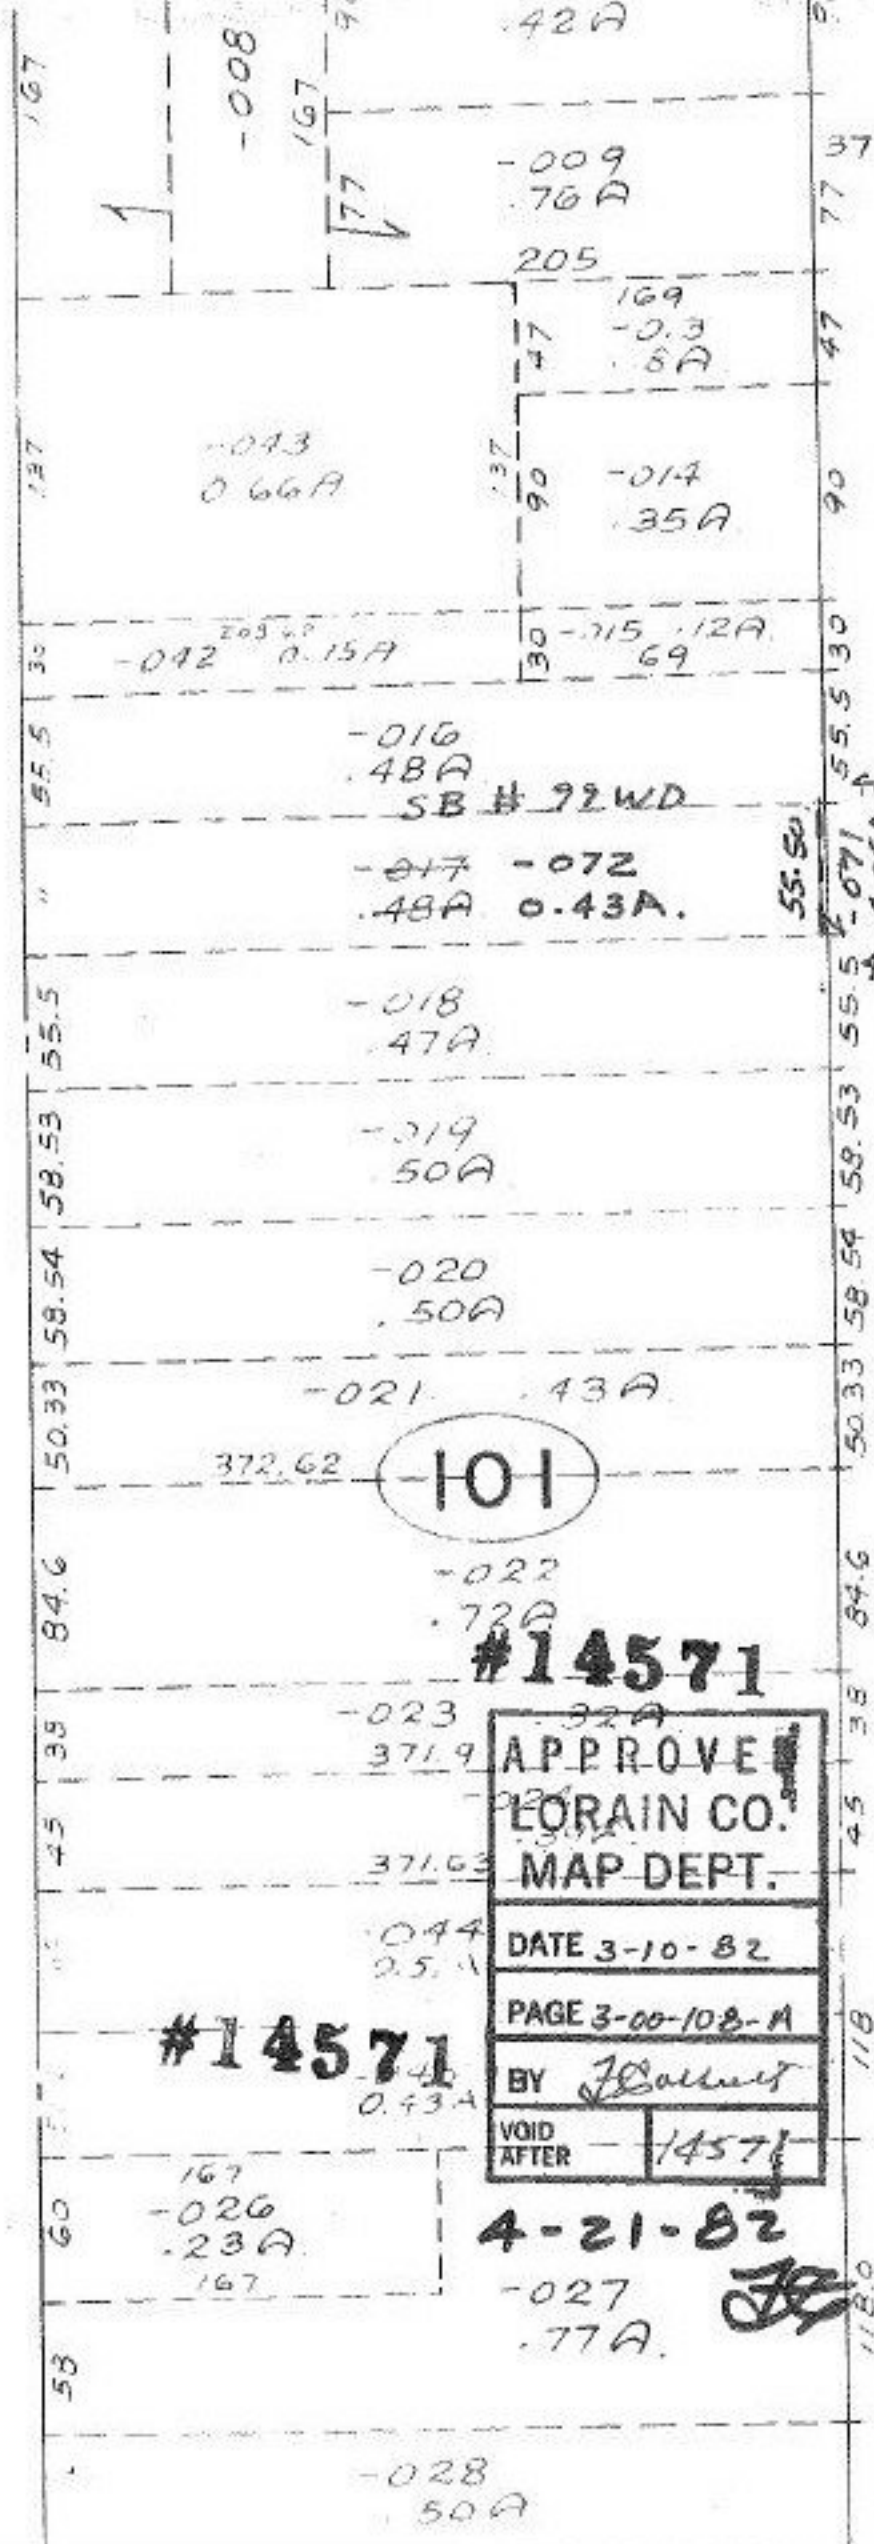

#14571

APPROVE
LORAIN CO.
MAP DEPT.

DATE 3-10-82

PAGE 3-00-108-A

BY *J. Balliet*

VOID AFTER - 14571

4-21-82

J. Balliet