

SEE 15-E

5.89°45'30"E



WEBSTER

195.34

150

1486.05

500

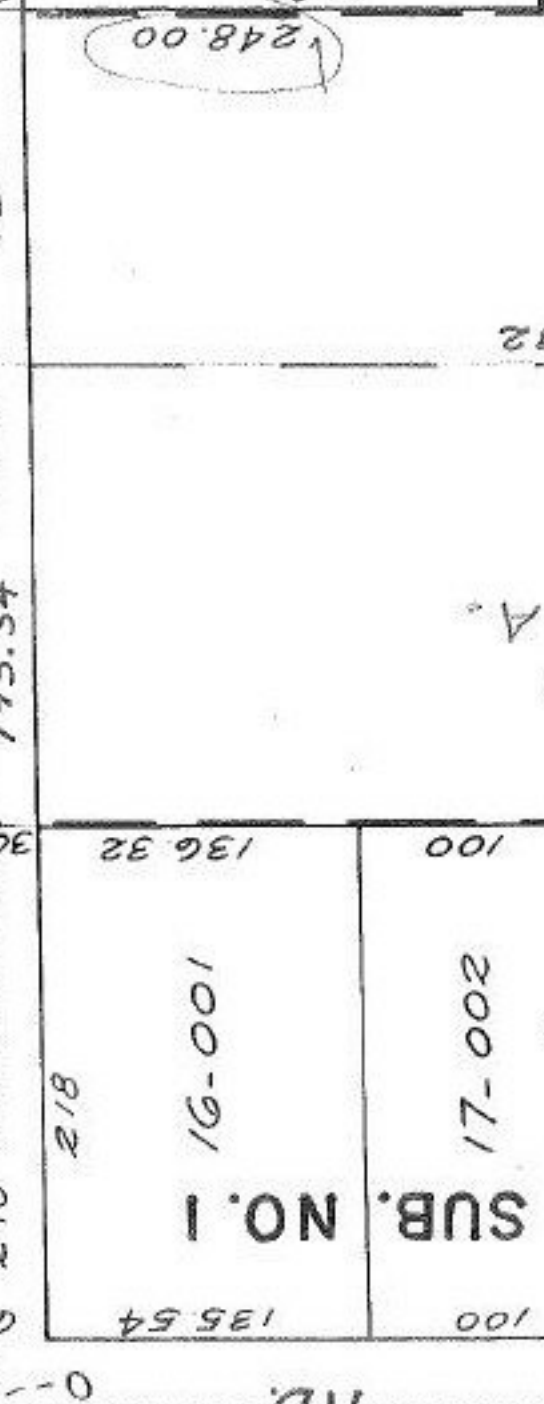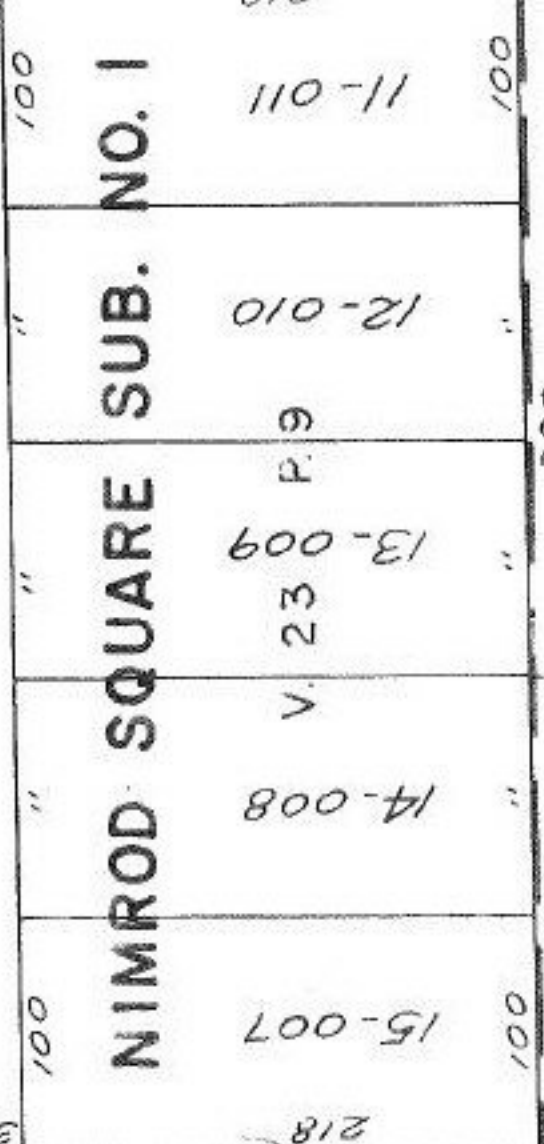

4.45A  
-040  
SURVEY BY G. PENFOUND

-038  
2.98A

2.54A  
-041

~~-039~~  
~~6.99A~~

FEB 25 1983

#14574

APPROVED

218

GRAIN CO.

DATE 3-10-82

BY 17-26-19

1.0619

VOID AFTER 500

393.34

300