


B

See Misc. Vol. 4 Pg 438 for Street Width.

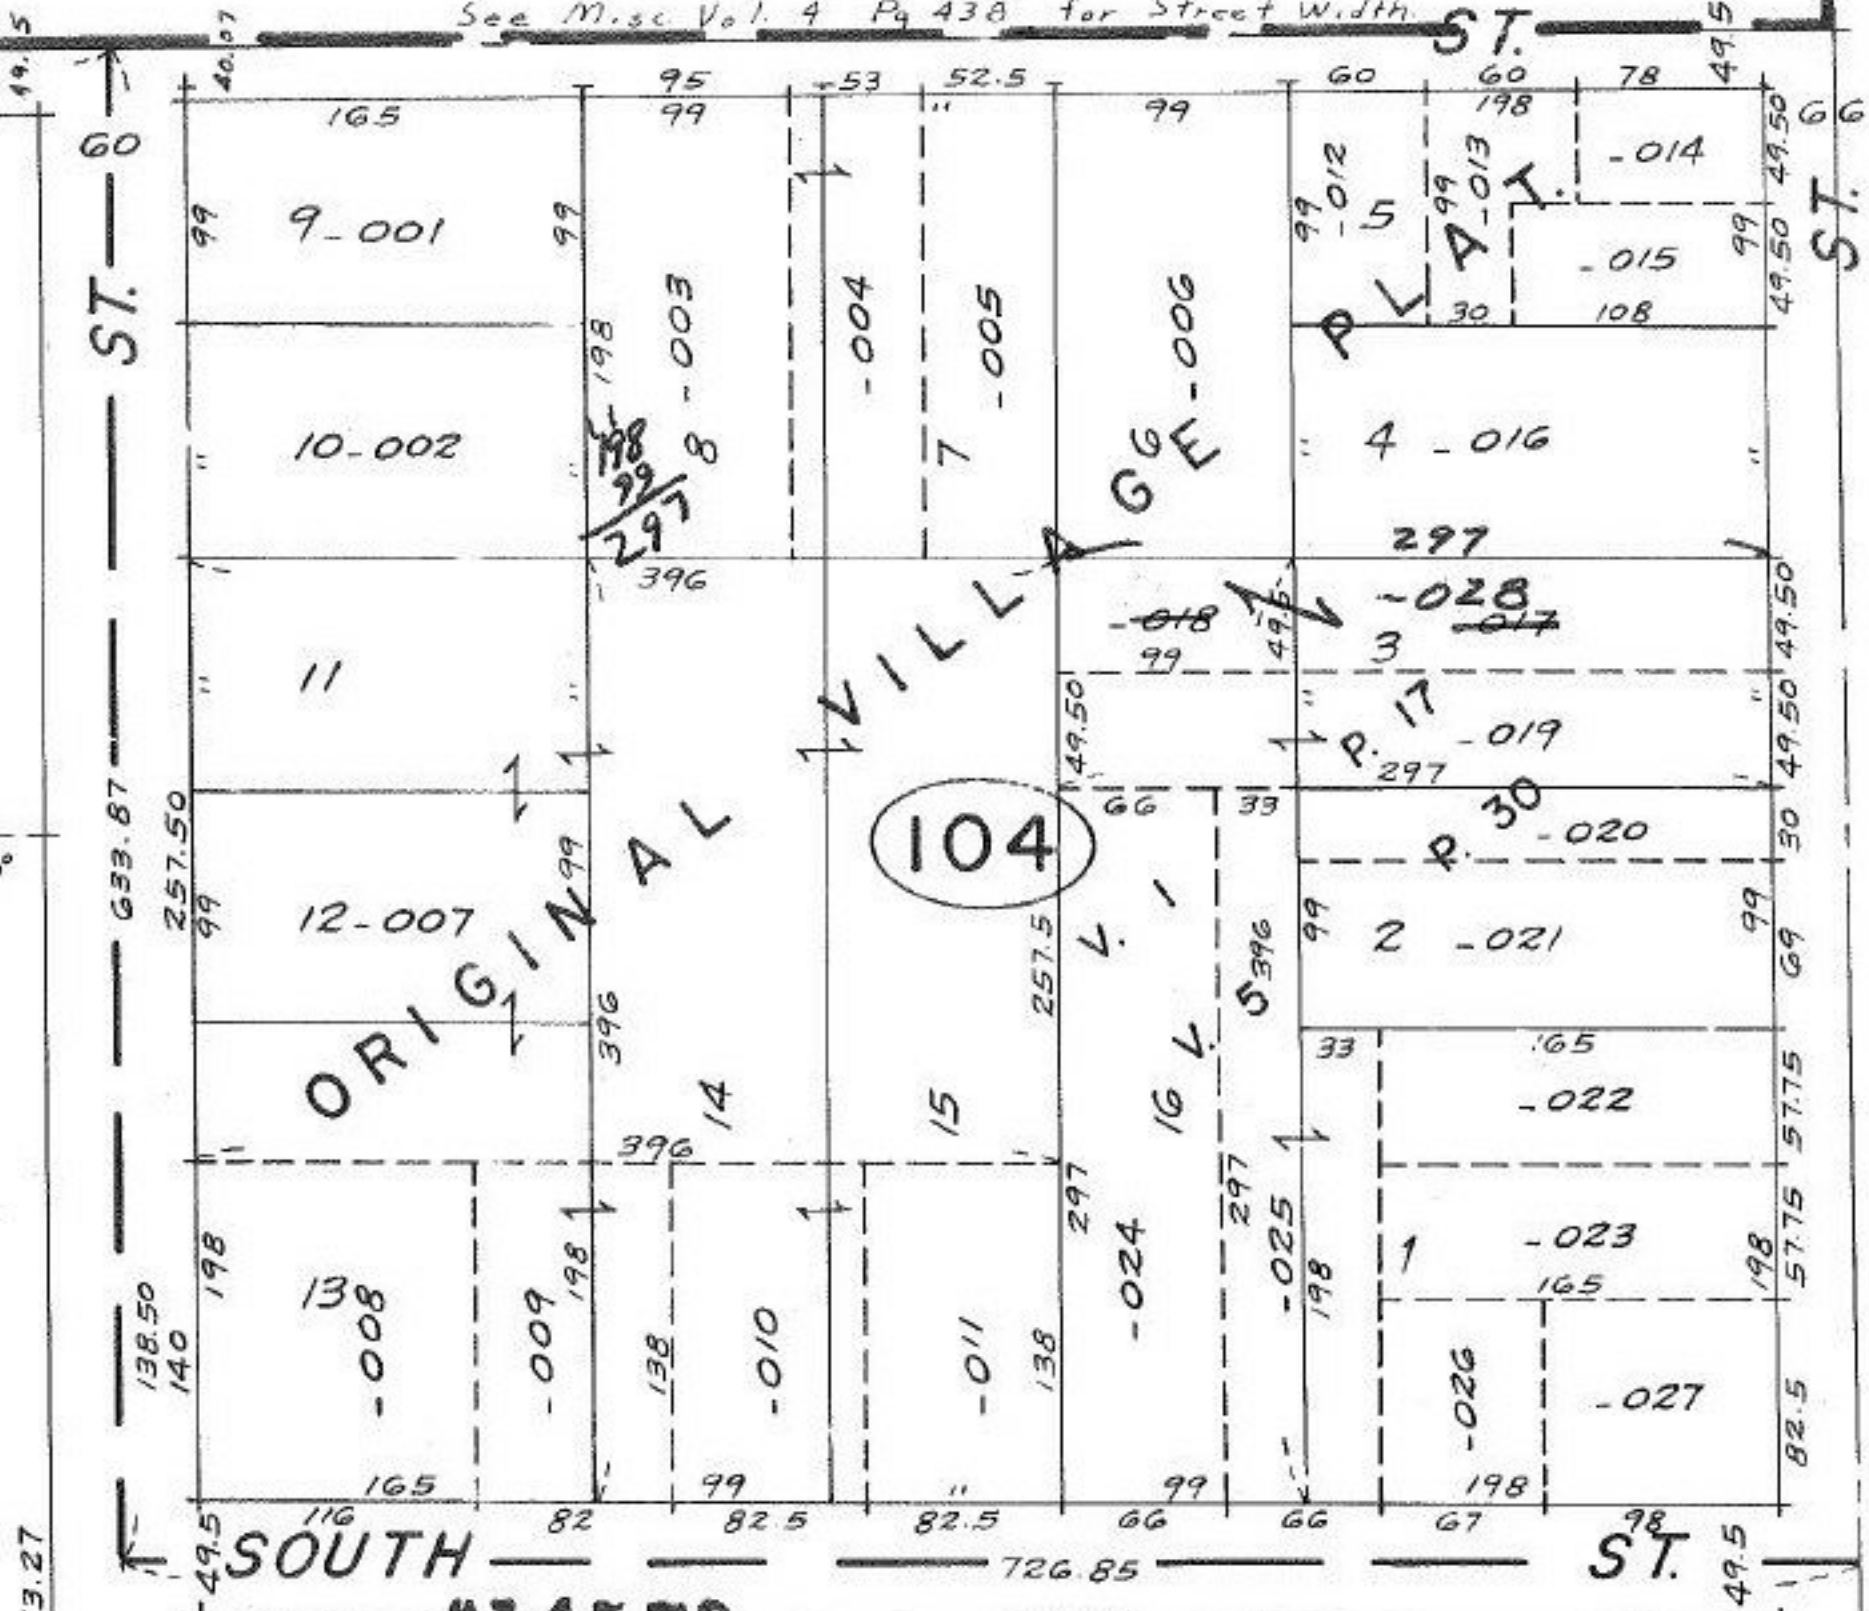

573.27

#14579

**#14579**

APPROVED  
LORAIN CO.  
MAP DEPT.

DATE 3-11-82

PAGE 9-00-025B

BY *[Signature]*

VOID AFTER 14579

105

JAN 14 1983

500

#14579

672.15  
-002  
1.30 FT.

672.36 R. 0.83R.

637.93

-005 1.14R.

667.18

316

95.78

84.82

92.34

33.76

84.85

233.75

49.5

138.50  
140

633.87

60

19.5

40.07

116

165

138

198

198

257.50

396

99

99

SOUTH

12-007

11

10-002

9-001

165

82

82.5

138

198

396

396

396

99

99

95

99

82.5

82.5

138

198

396

396

396

99

99

53

52.5

82.5

82.5

138

198

297

257.5

297

99

99

60

60

66

66

198

198

297

297

297

99

99

60

60

66

66

198

198

297

297

297

99

99

60

60

67

67

198

198

297

297

297

99

99

60

60

67

67

198

198

297

297

297

99

99

60

60

67

67

198

198

297

297

297

99

99

60

60

67

67

198

198

297

297

297

99

99

60

60

67

67

198

198

297

297

297

99

99

60

60

67

67

198

198

297

297

297

99

99

60

60

67

67

198

198

297

297

297

99

99

60

60

67

67

198

198

297

297

297

99

99

60

60

67

67

198

198

297

297

297

99

99

60

60

67

67

198

198

297

297

297

99

99

60

60

67

67

198

198

297

297

297

99

99

60

60