

#14593

APPROVED
LORAIN CO.
MAP DEPT.

DATE 3-17-82


PAGE 7-00-012-C

BY R. Carls

VOID
AFTER

1-21-83
[Signature]

-024
13.77 A.

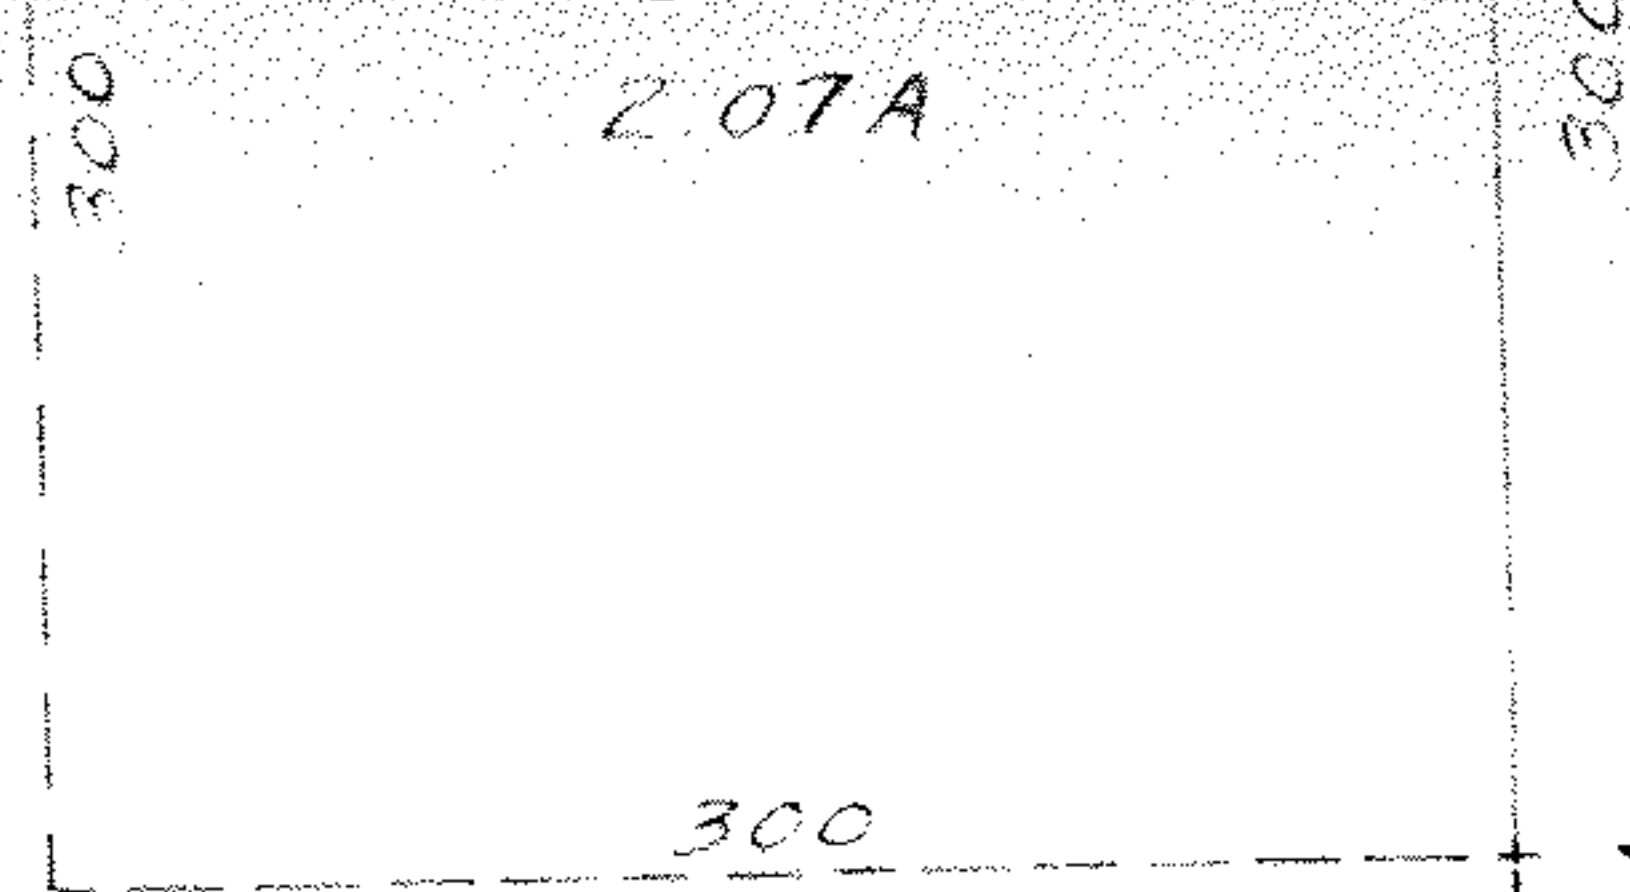

MAP CORRECTION ONLY

1057.3

SEE 7-G

101

1100

#14593

APPROVED
LORAIN CO.
MAP DEPT.

DATE 3-17-82

PAGE 7-00-012-C

BY T. McNeil

VOID
AFTER

THIS LINE WAS
ON THE LOT LINE
& WAS INCORRECT.


PER SURVEY
R. SIMON

-023
6.57 A.

260

MAP CORRECTION ONLY

1100

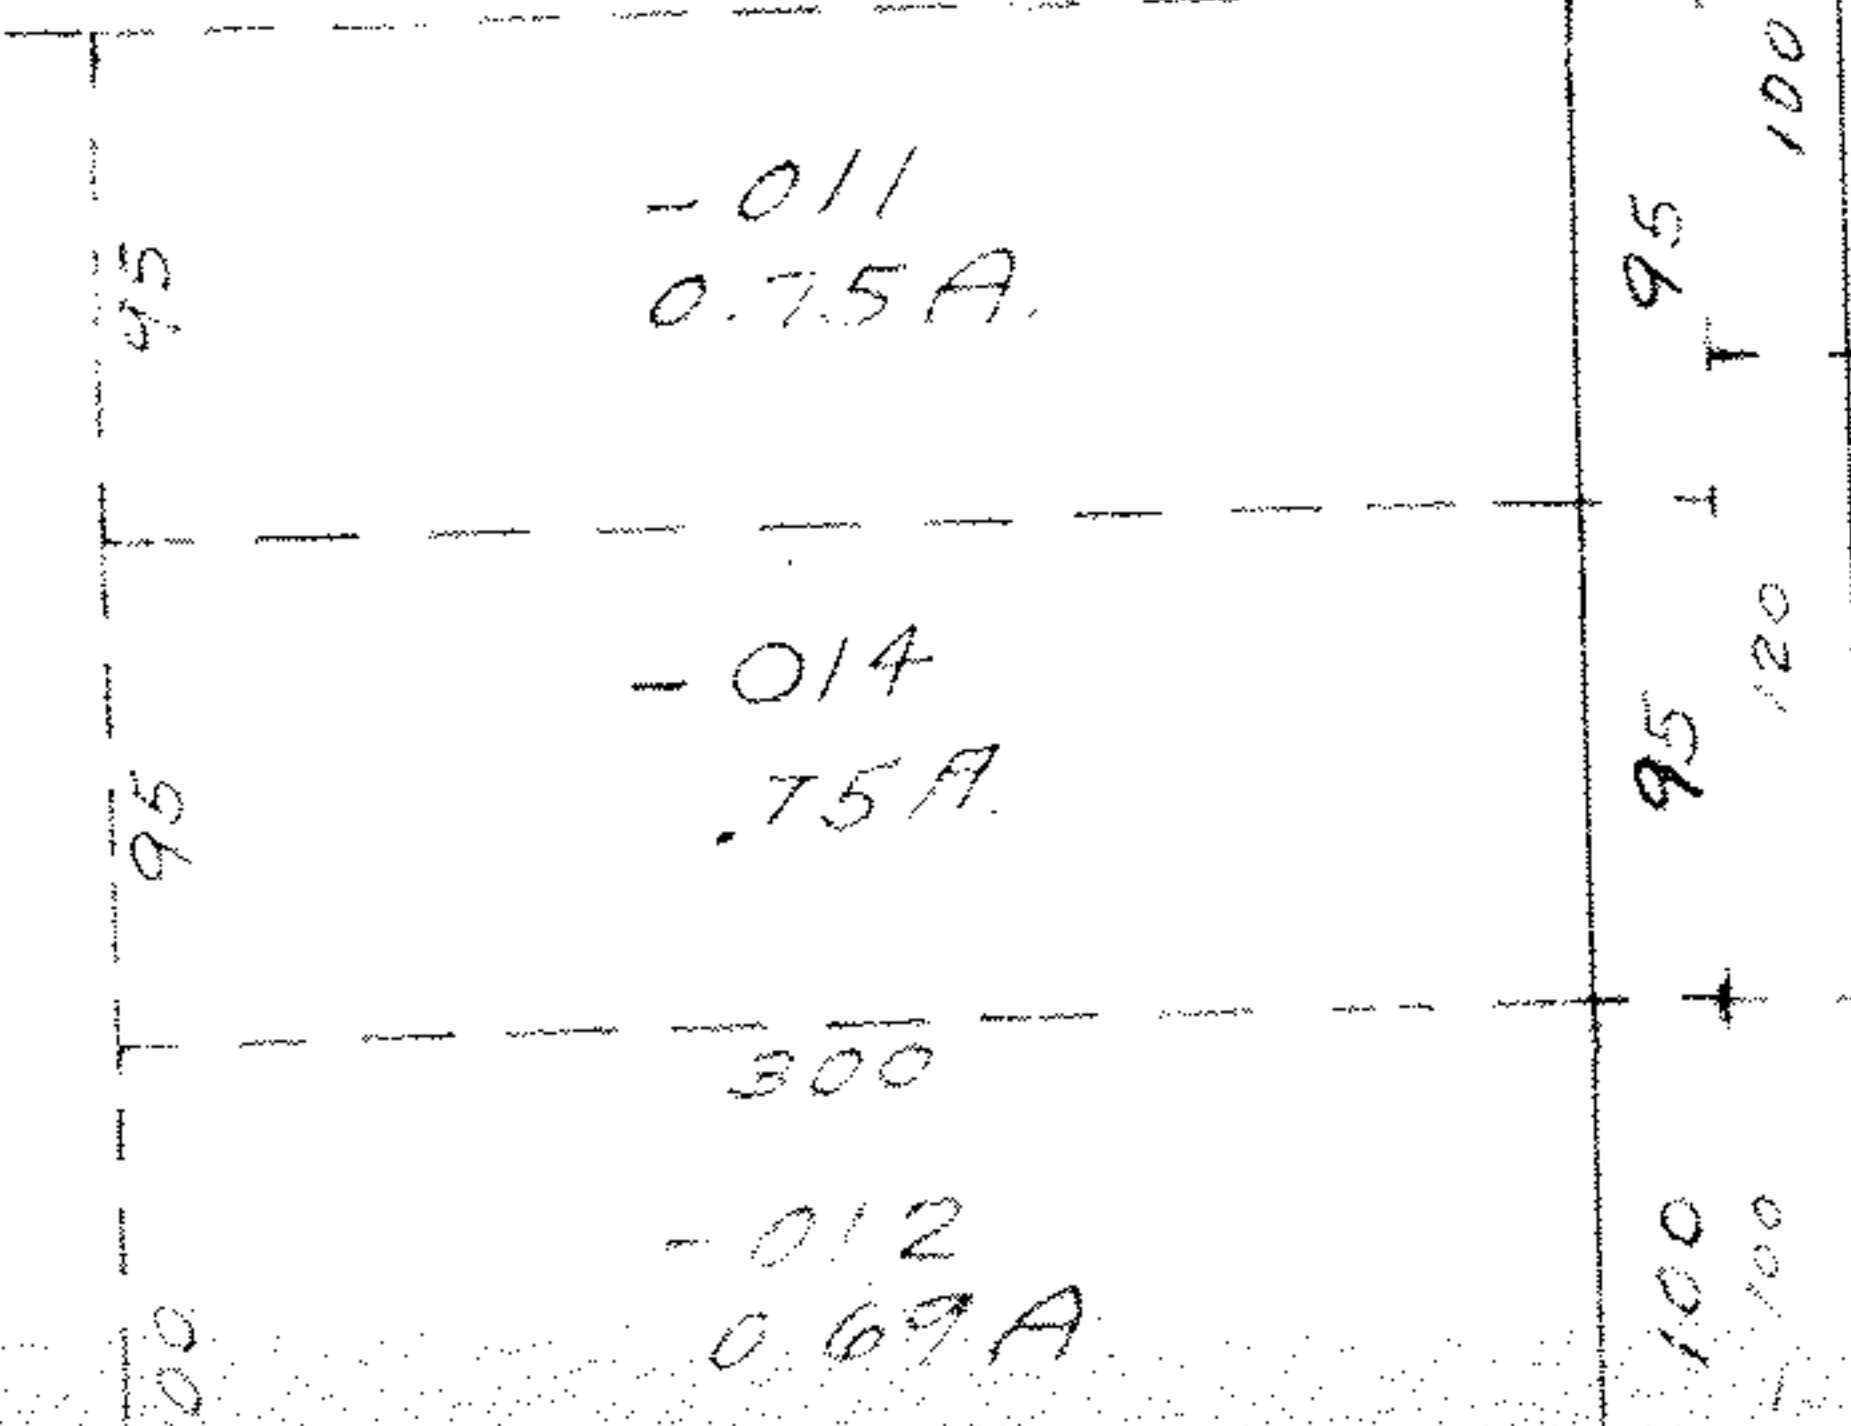

-011
0.75 A.

-014
.75 A.

-012
0.69 A.