


VACATION OF COVE AVE  
& ADD TO DUPLICATE

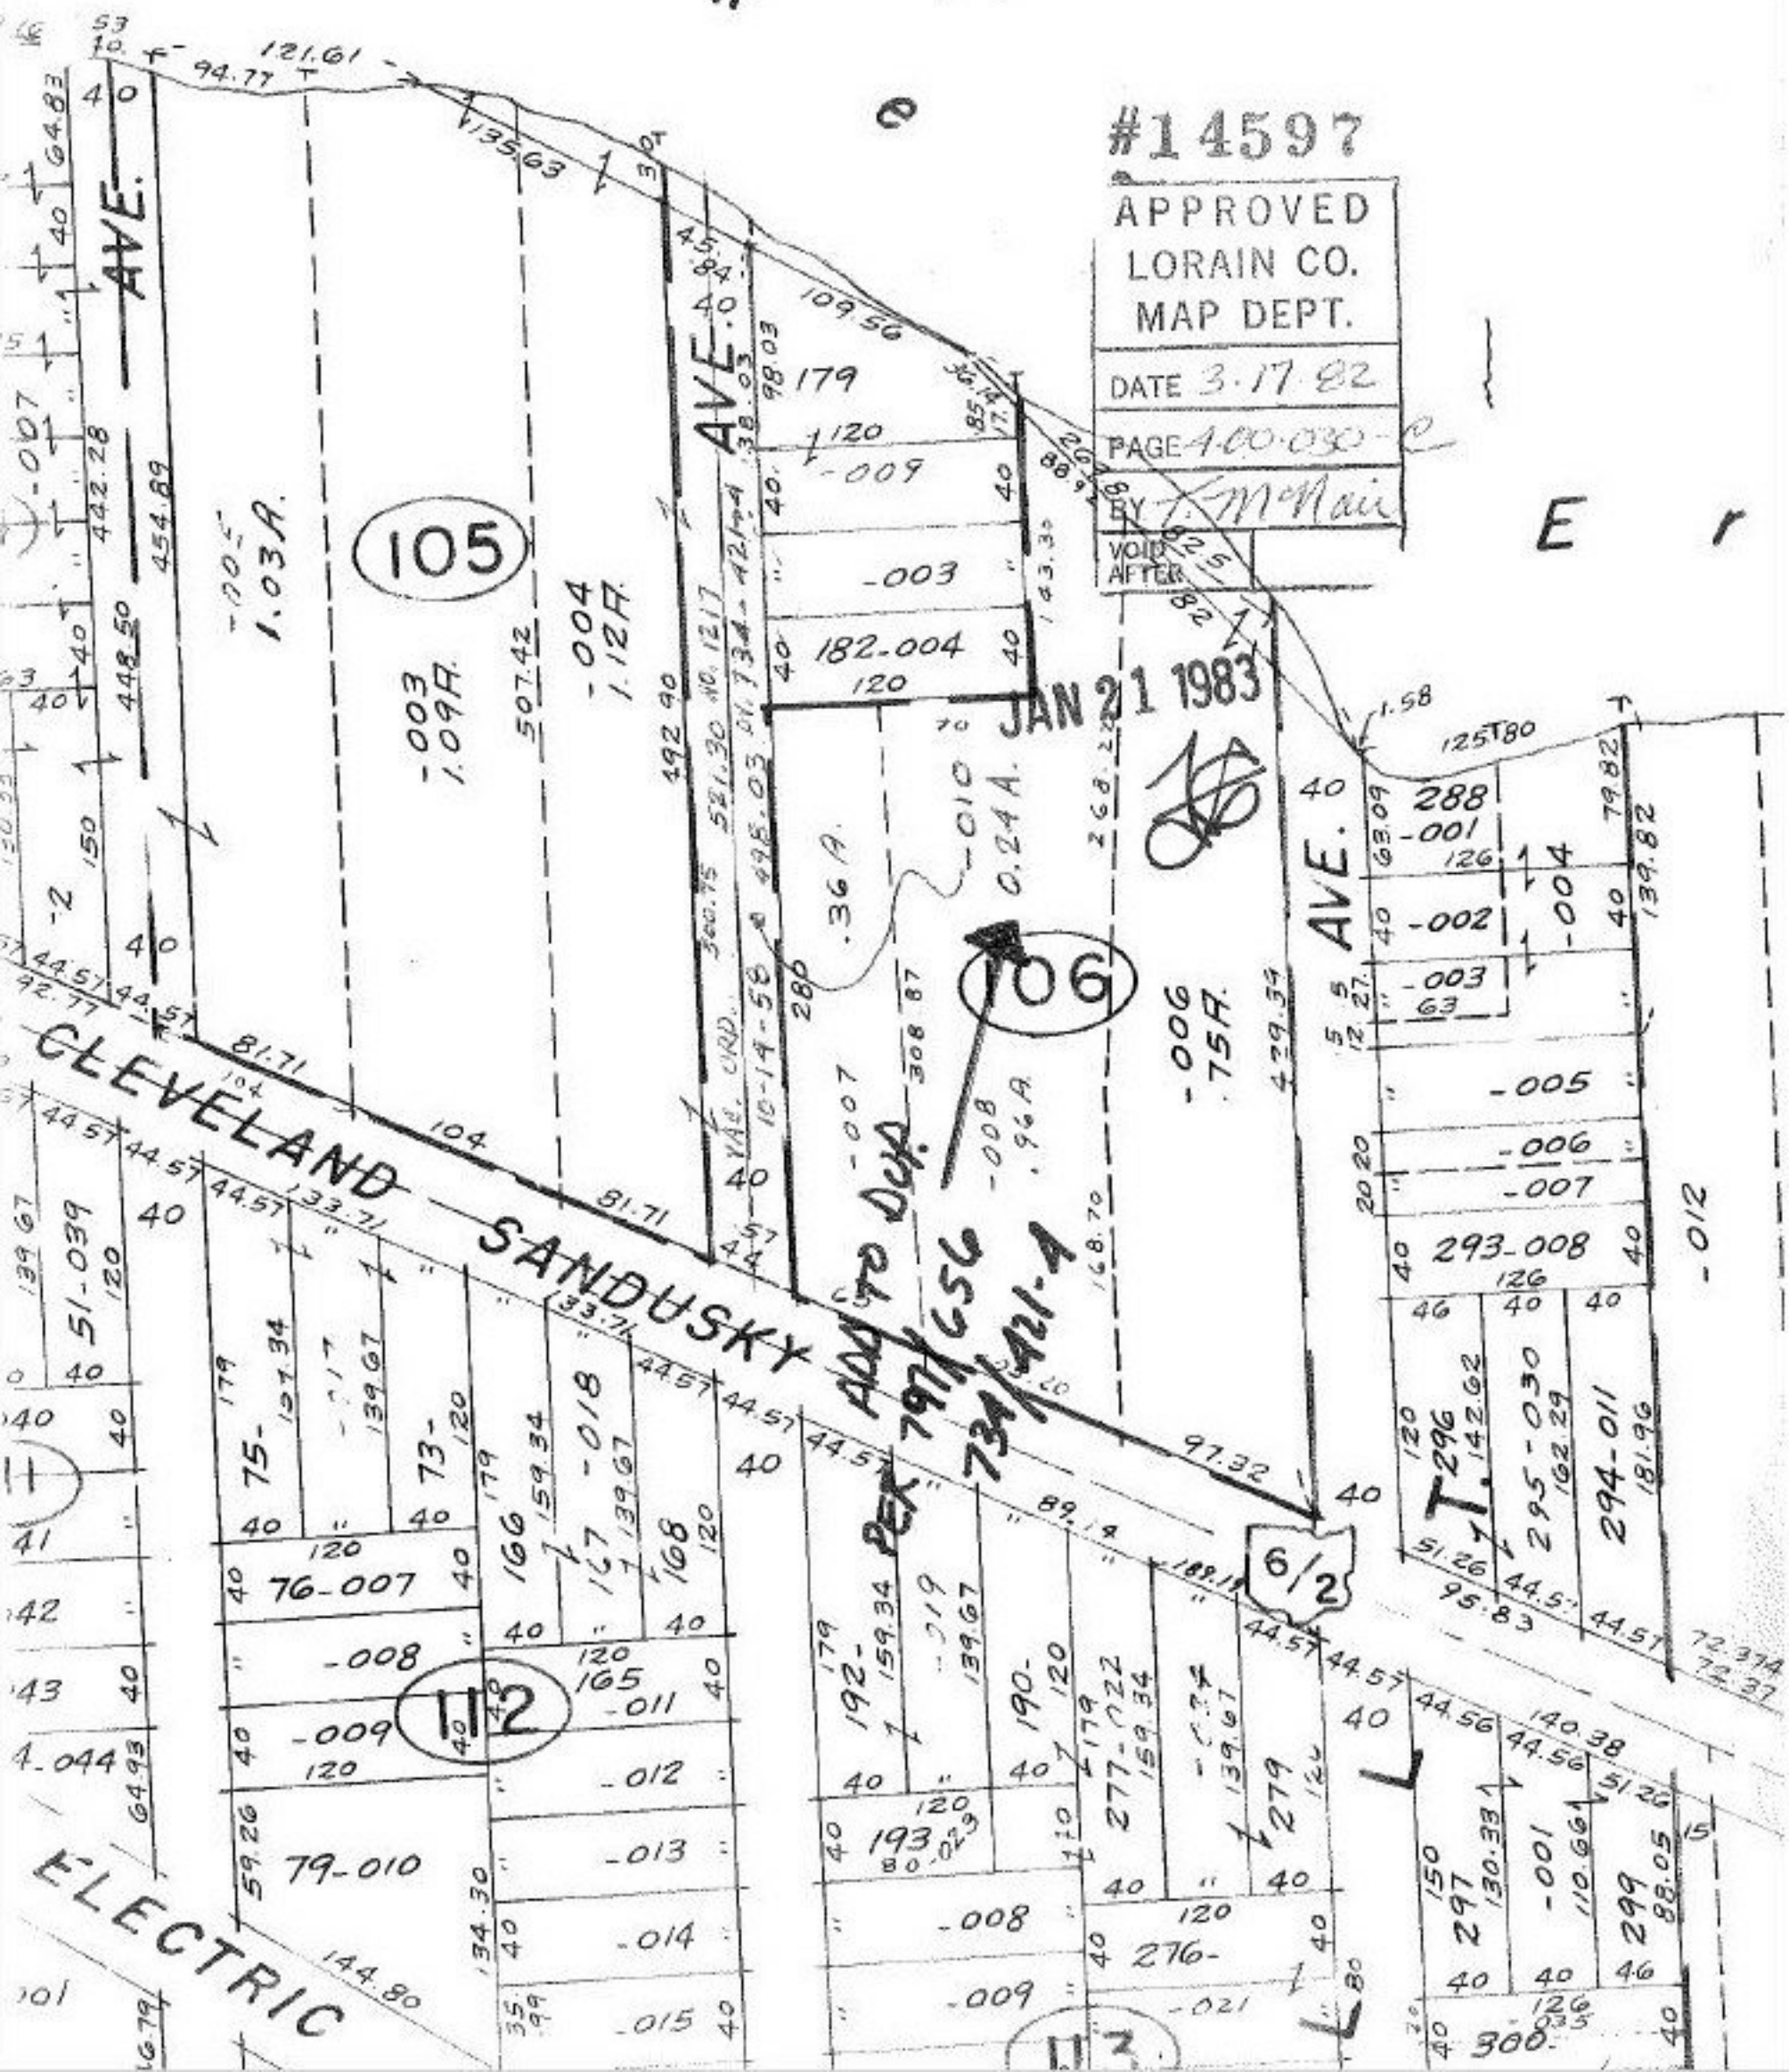

#14597

APPROVED  
LORAIN CO.  
MAP DEPT.

DATE 3-17-82

PAGE 4-00-030-2

BY J.M. Hair

VOID  
AFTER  
90  
DAYS

JAN 21 1983

105

106

112

ADD TO DEJA  
ADD TO DEJA PER 797656  
731421-4

6/2

ELECTRIC

CLEVELAND

SANDUSKY

AVE.

E

-012

101

72.37A  
72.37