

#14603

#14604

APPROVED
LORAIN CO.
MAP DEPT.


DATE 3.24.82

PAGE 3-00-108-A

BY T. McRae

VOID
AFTER

SEE 2-01-003-N

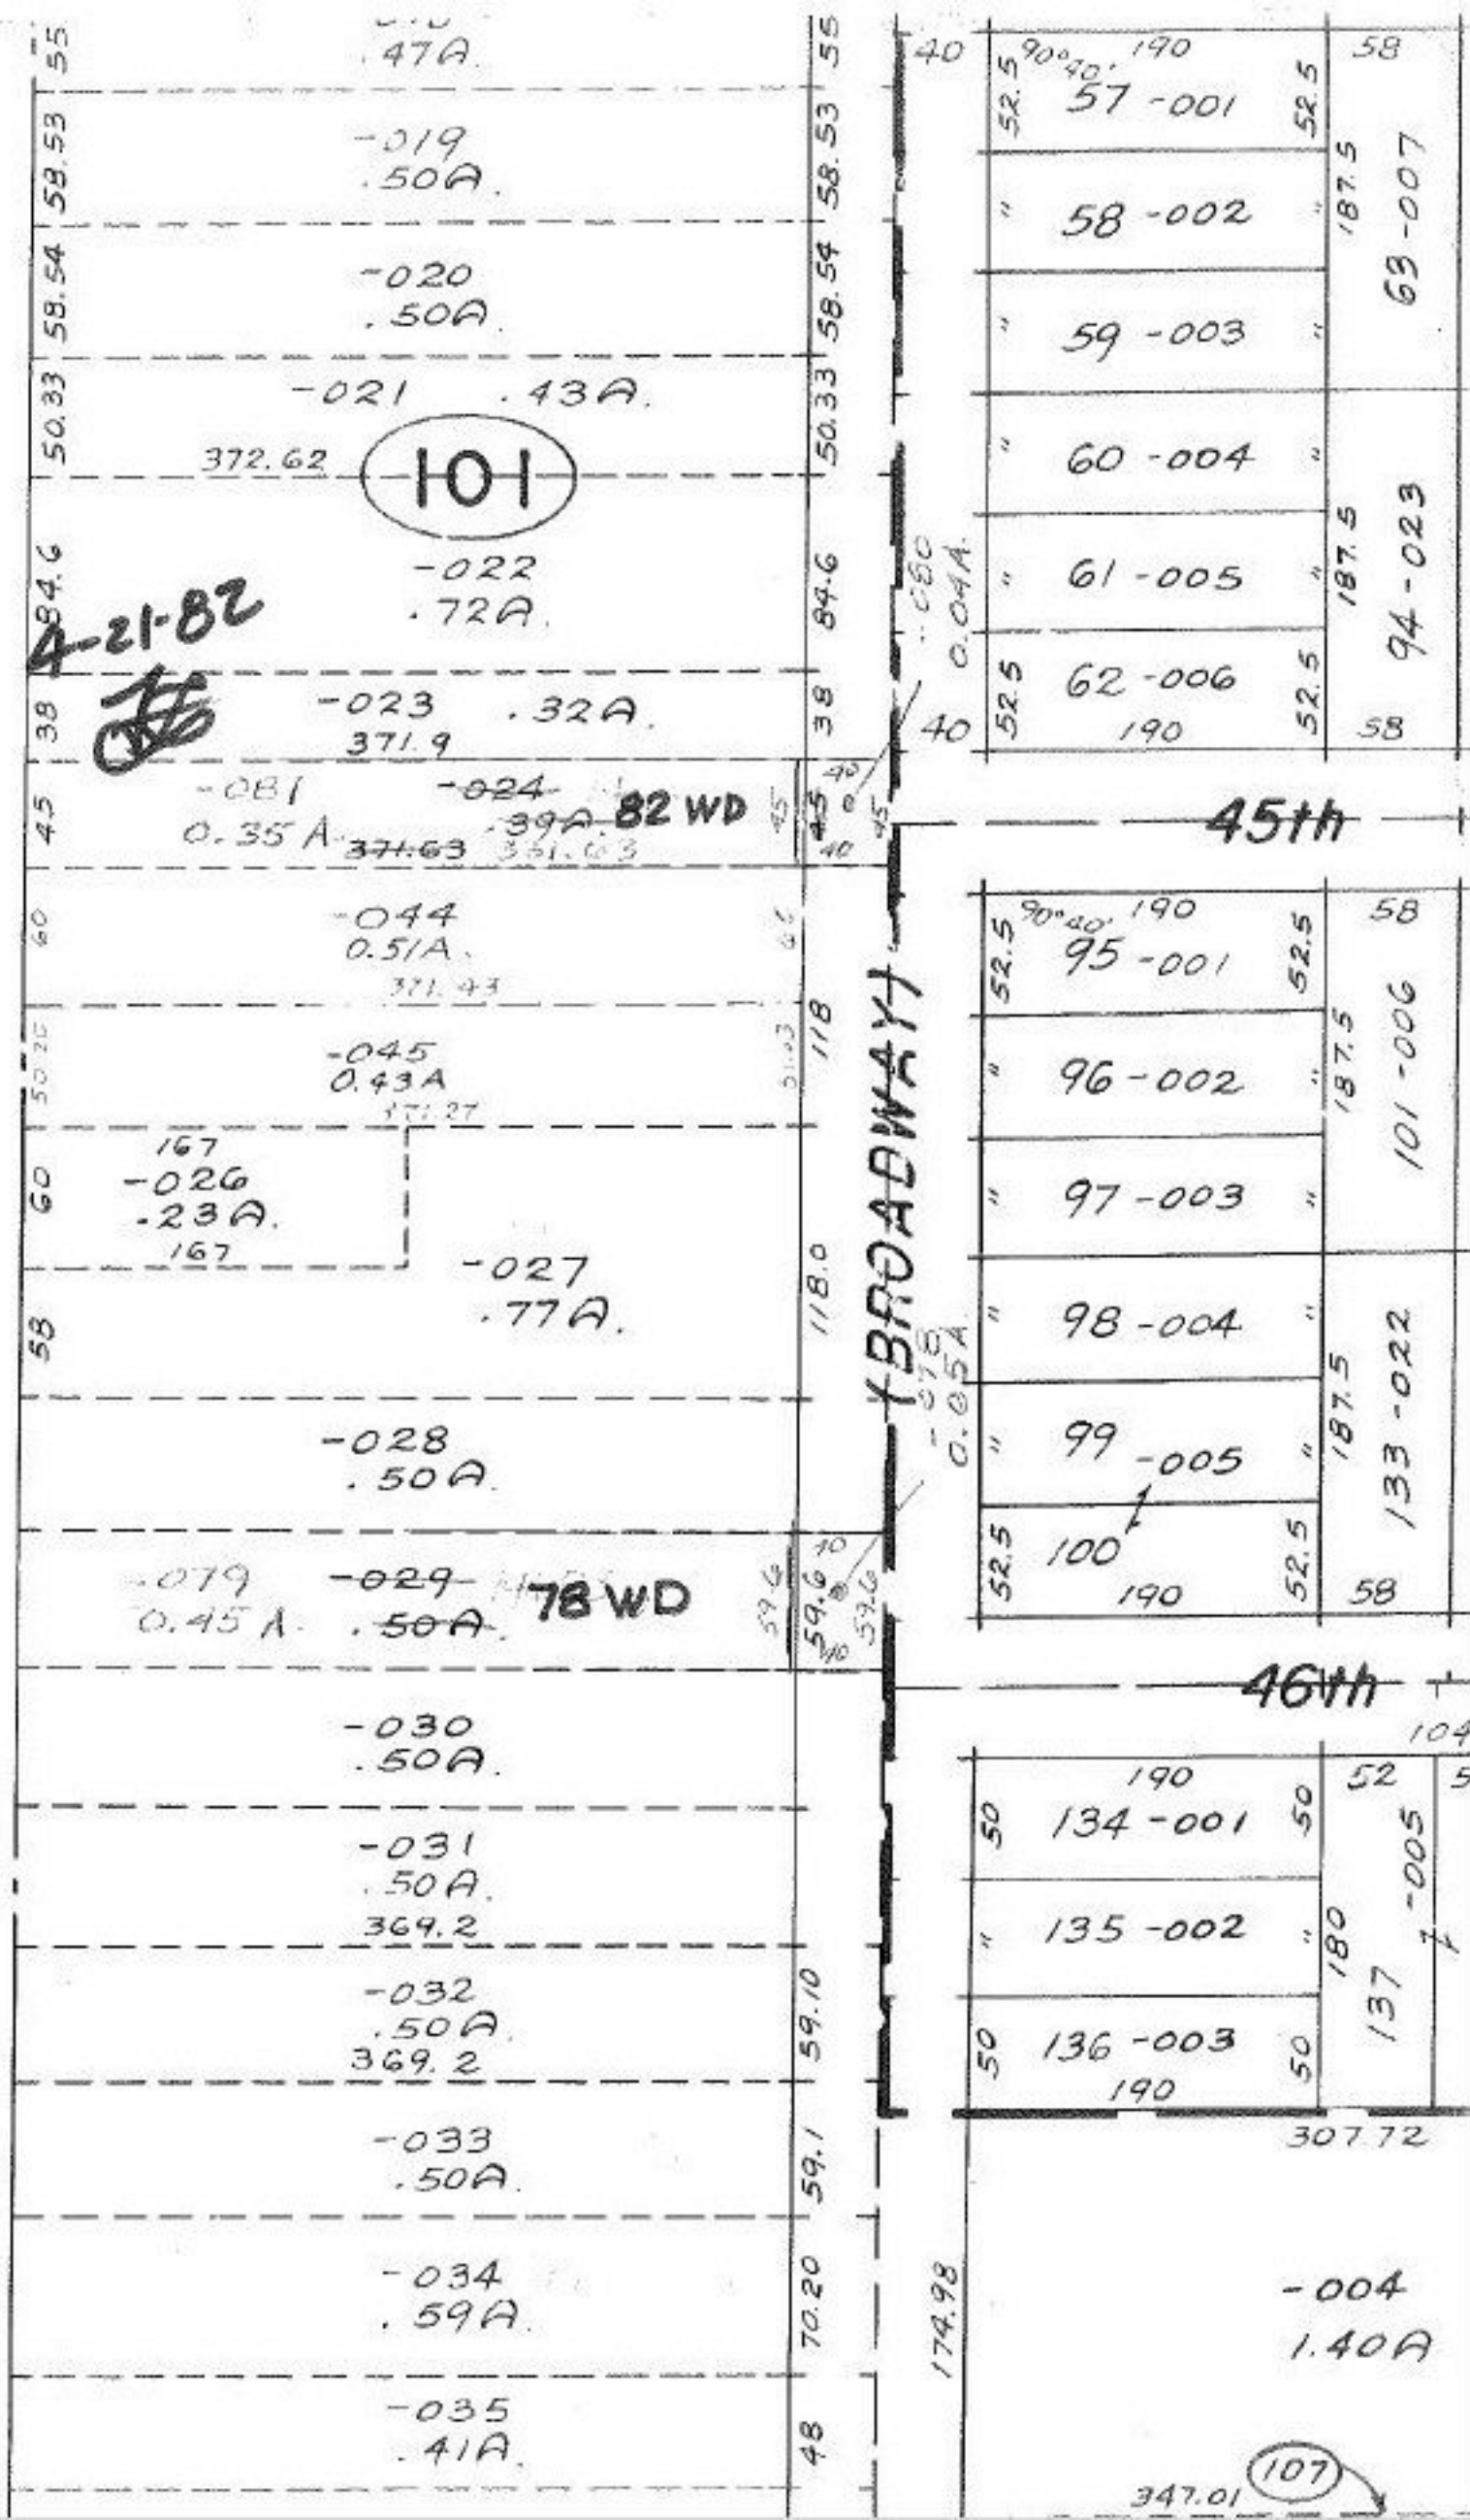

4-21-82
[Signature]

101

45th

46th

BROADWAY

347.01 107