


MEDINA - NORWALK

18

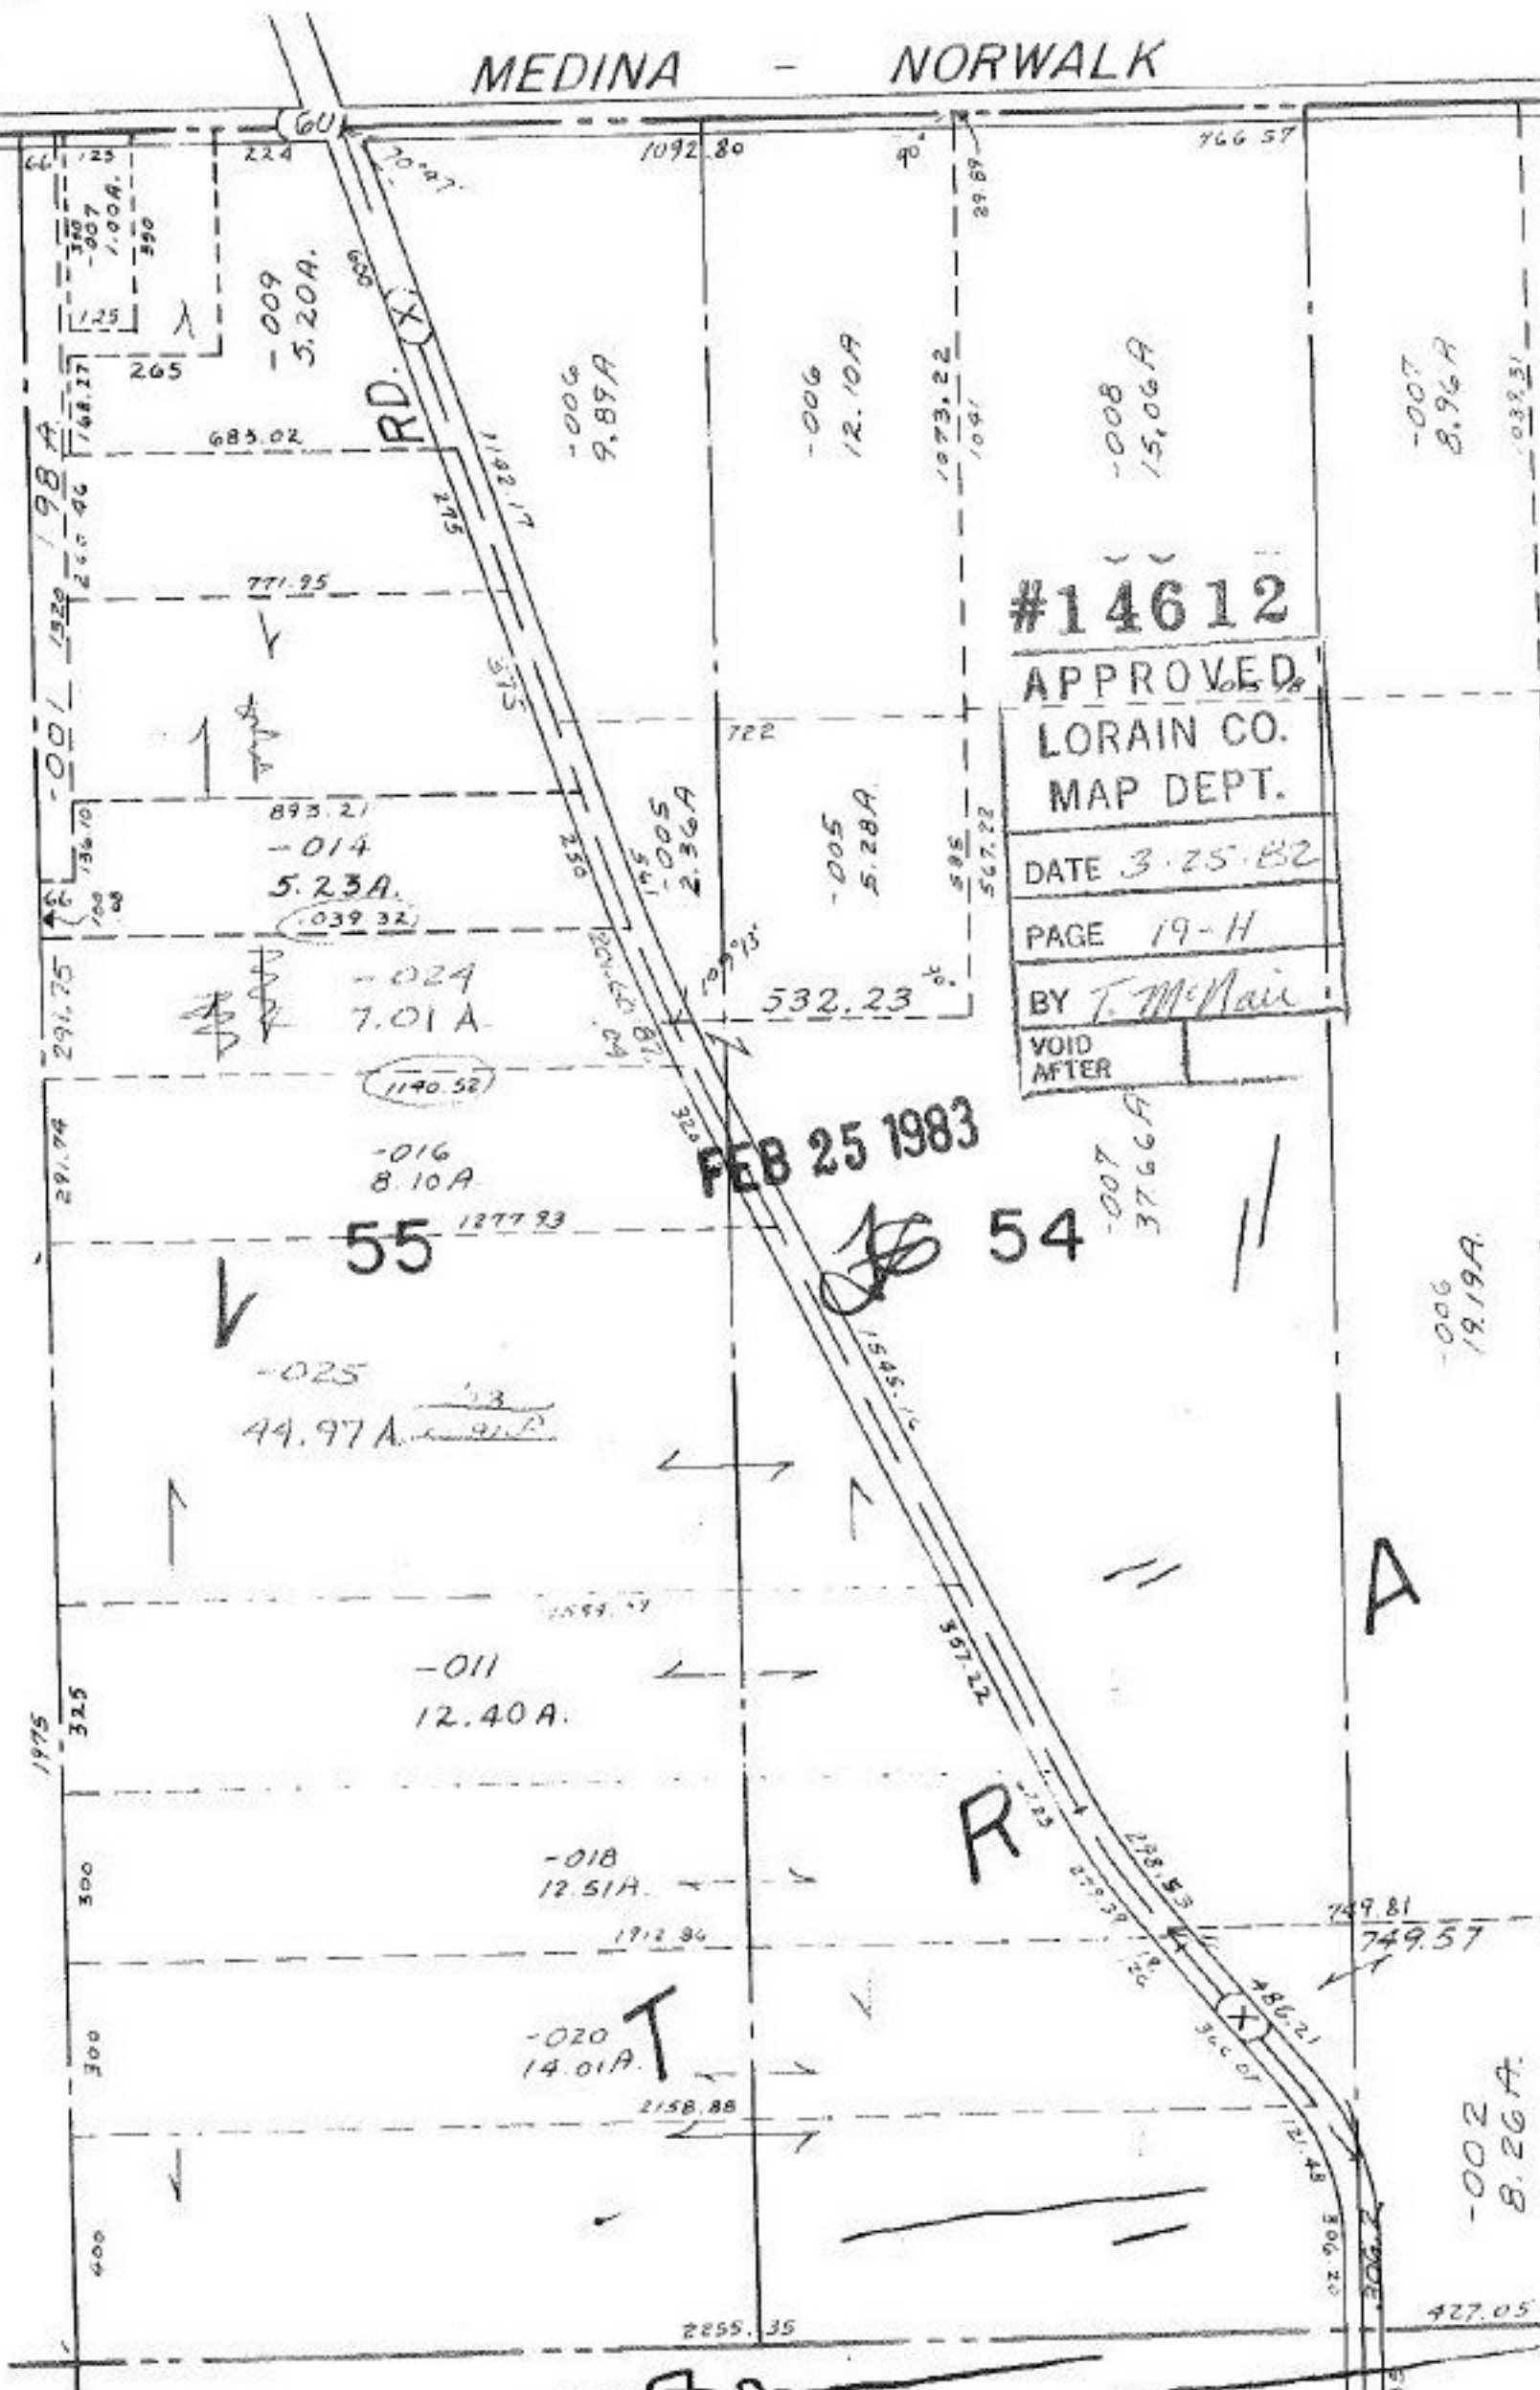

#14612

APPROVED
LORAIN CO.
MAP DEPT.

DATE 3-25-82

PAGE 19-H

BY T. McNeil

VOID
AFTER

FEB 25 1983

54

55

A

R

T

-002
8.26A

AJ