

SEE 2-01-003-L

672.25

1188

-040  
Pt. ~~03-00-108-101-539~~  
Pt. 50.666A  
50.44 A.c.

262


Pt. 027  
Pt. 184A

#14627

APPROVED
LORAIN CO.
MAP DEPT.
DATE 4-2-82
PAGE 2-01-003 N
BY <i>[Signature]</i>
VOID AFTER 14627

JAN 14 1983

*[Signature]*

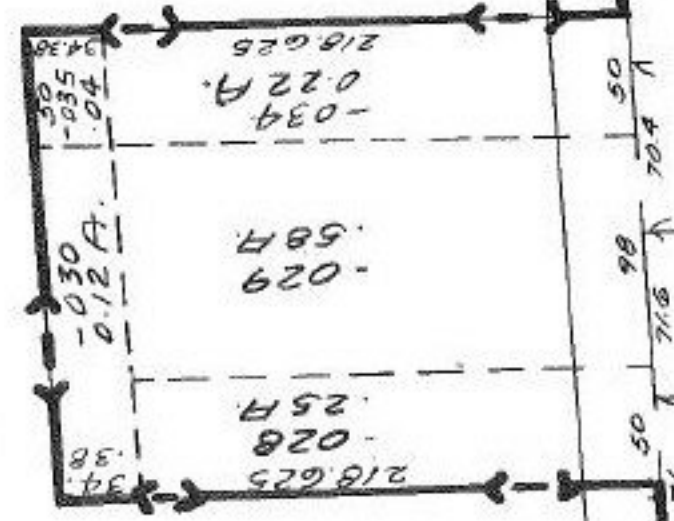

289.62 RD.

