

2159.36

1318

1580

NOTE: DELETE PAGE
BREAK LINE WHEN
PUTTING SPLIT ON MAP.
USE NEW PARCEL
LINE INSTEAD

#14629

Amigo

APPROVED LORAIN CO. MAP DEPT.
DATE 4-2-82
PAGE 11-00-029-A
BY <i>T. McHair</i>
VOID AFTER

~~Pt. 022~~
~~Pt. 59.00 A~~

-016
22.90 A

375
-048 2.00 A
232
375


#14629

APPROVED LORAIN CO. MAP DEPT.
DATE 4-2-82
PAGE 11-00-029-A
BY <i>T. McHair</i>
VOID AFTER

FEB 4 1983

600 -CCI
A x 10

[Signature]

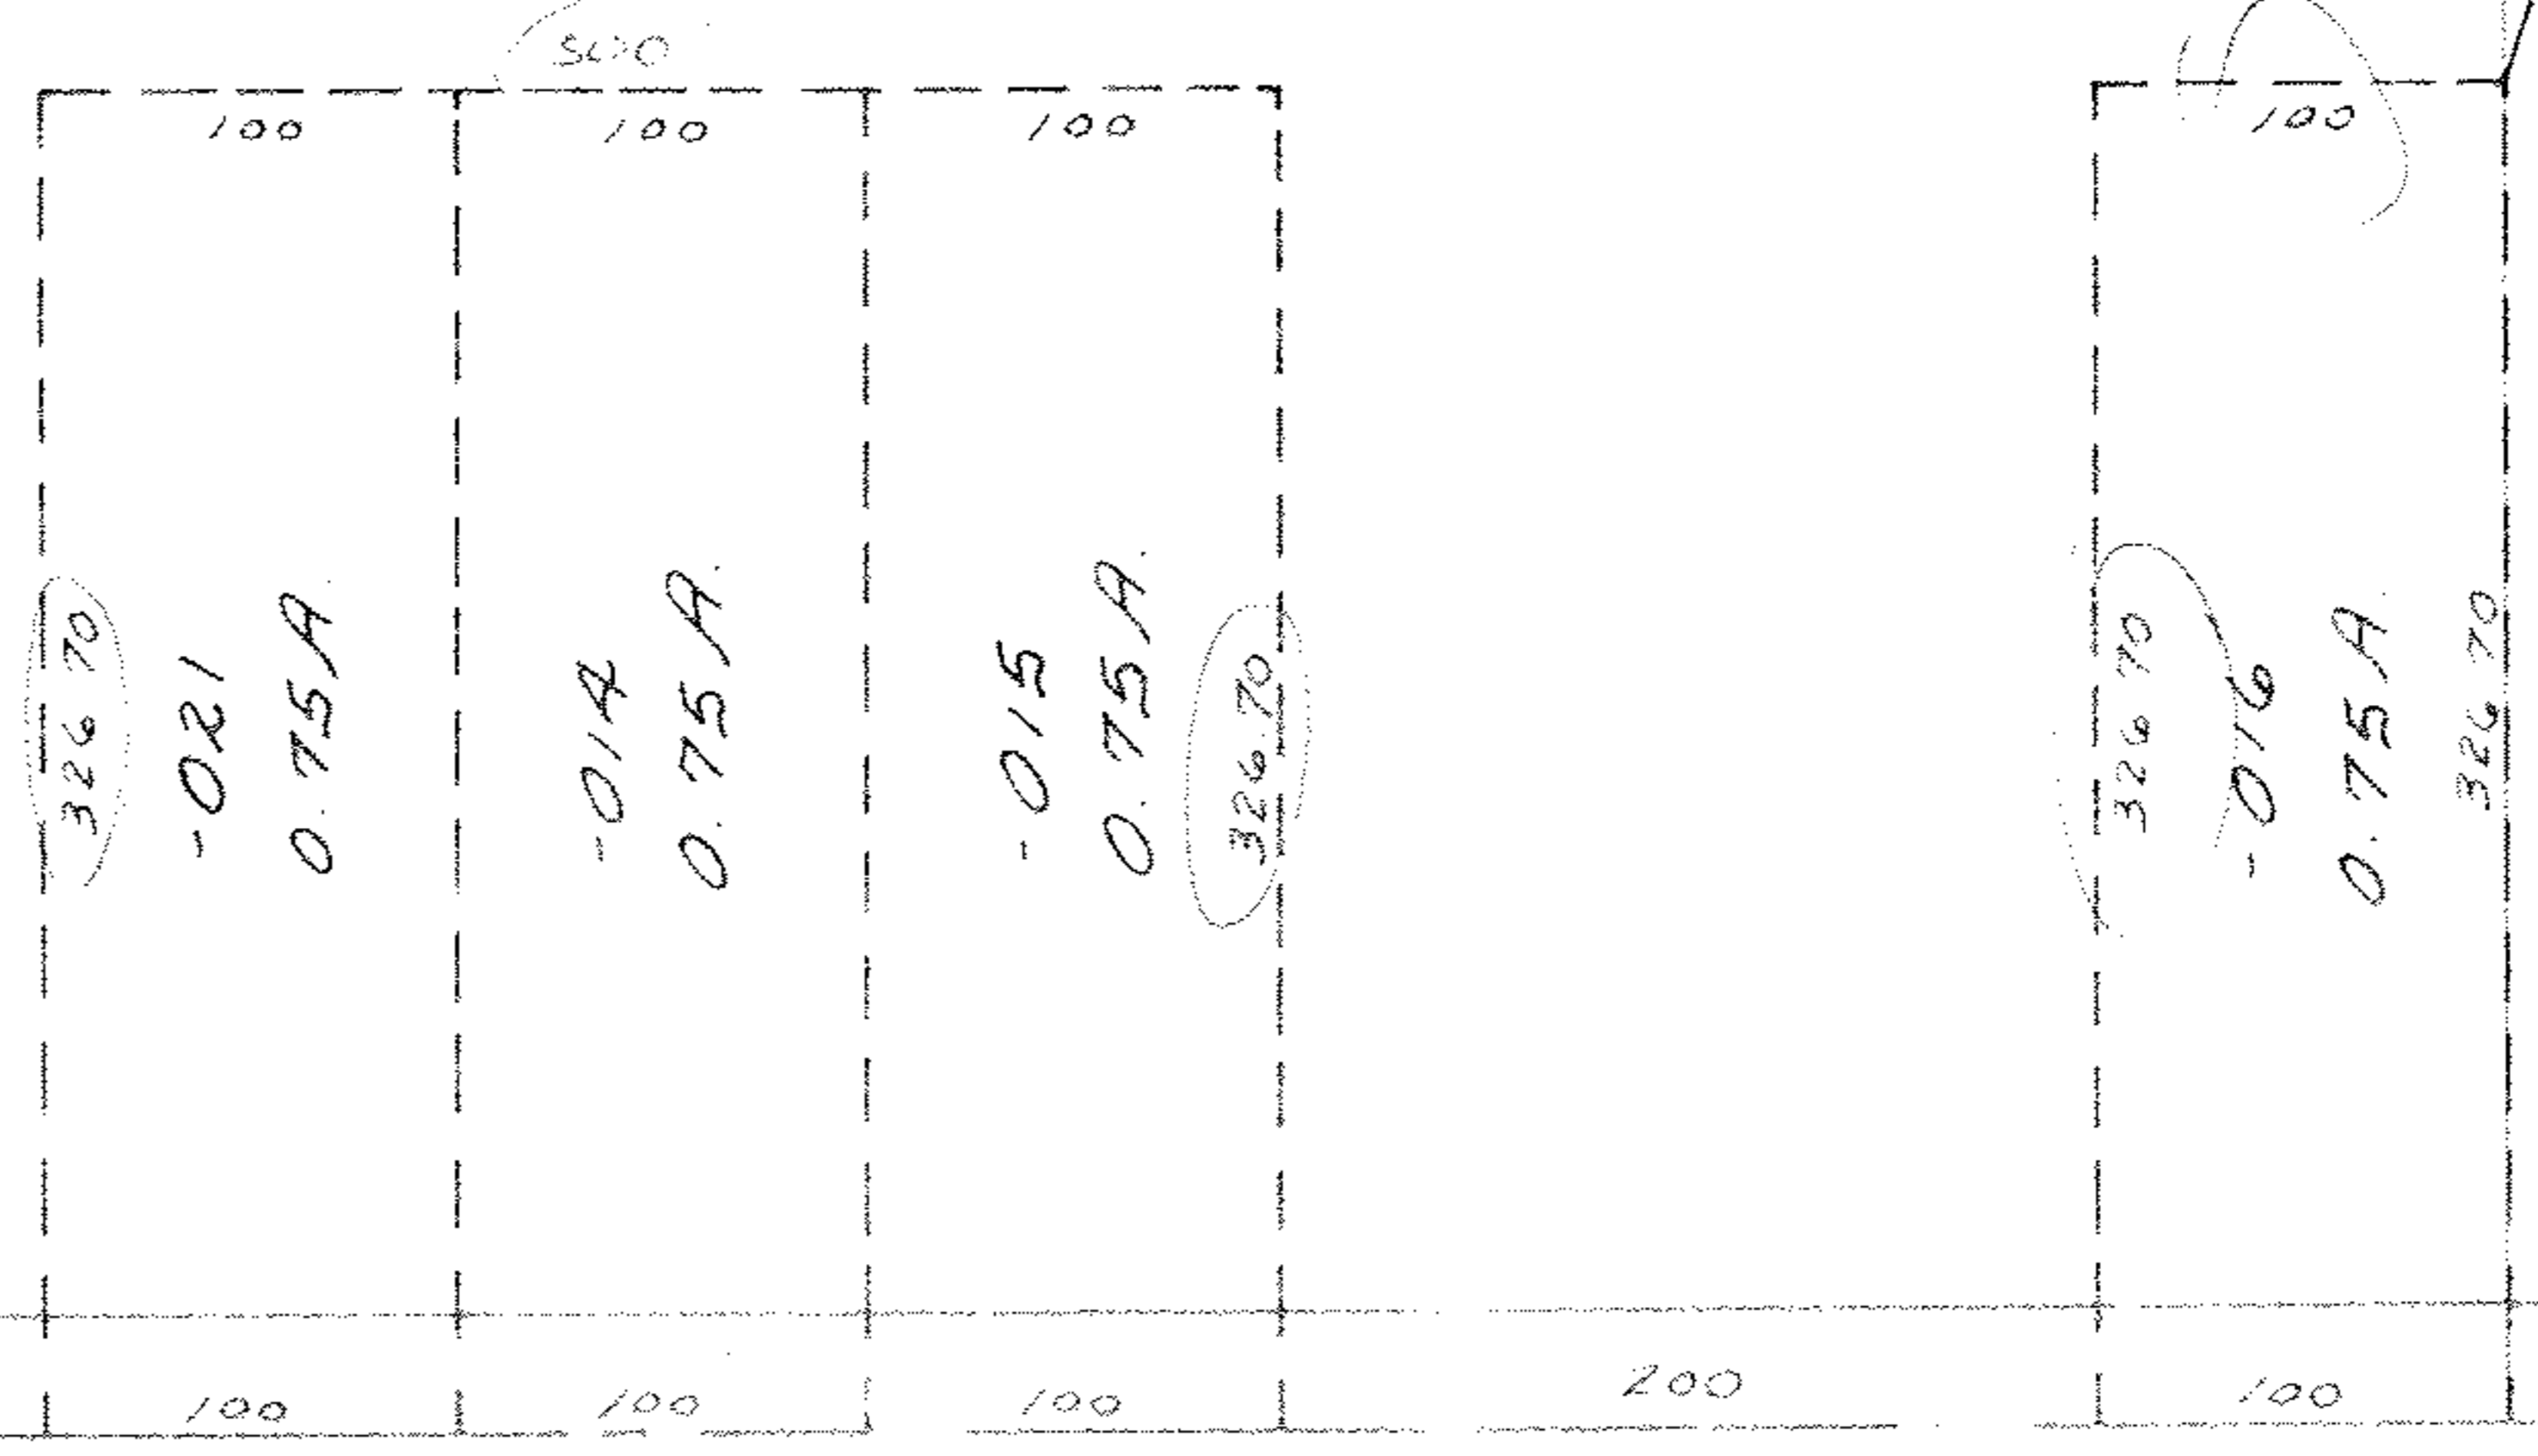

60 ISLAND

YE

717.48

RD.