


SEE 2-01-003-N

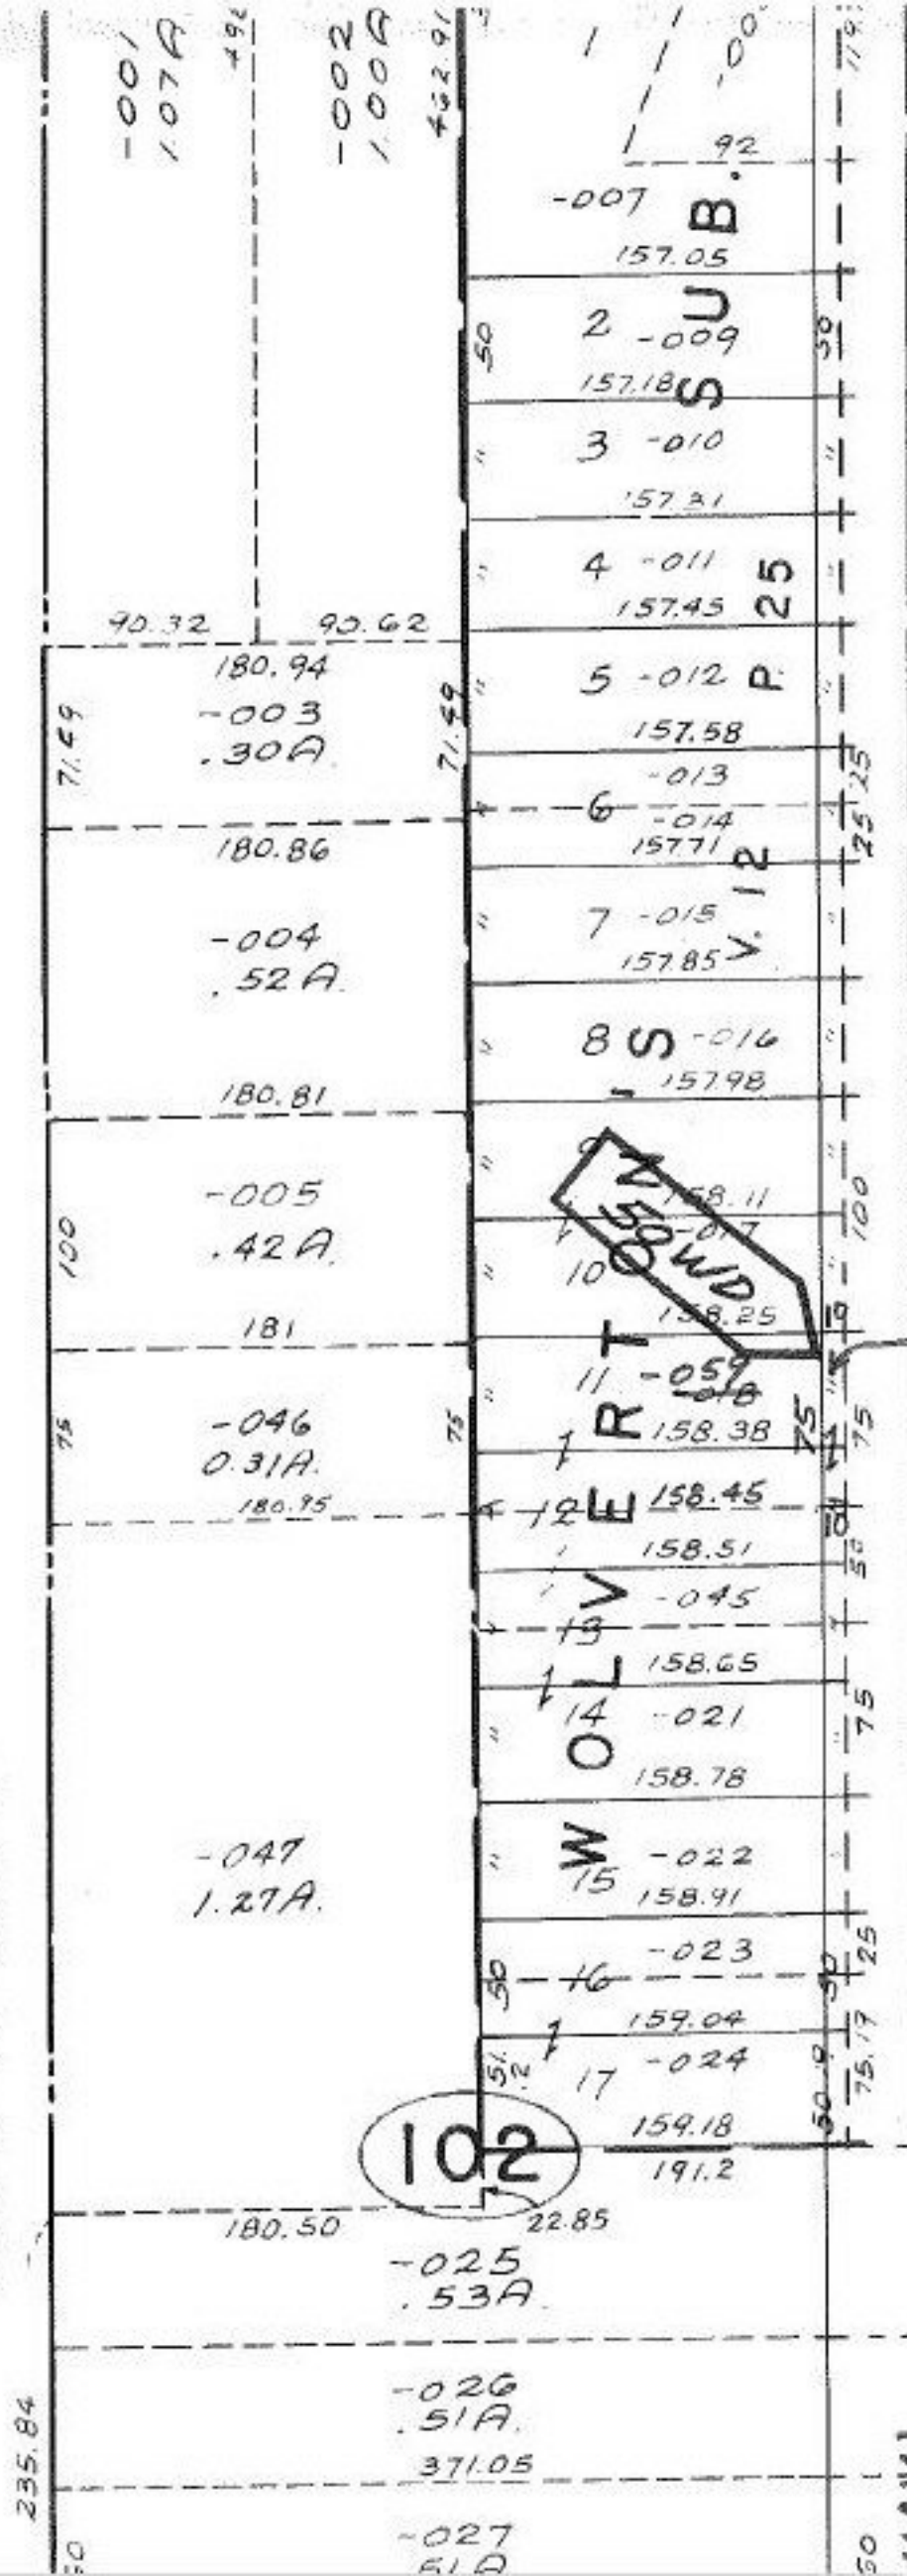

#14639

APPROVED
LORAIN CO.
MAP DEPT.

DATE 4-13-82

PAGE 3-00-1B-A

BY *J. J. J.*

VOID AFTER 14639

$\frac{-058}{75 \times 110}$

253
3.60H
[Signature]
4-13-82

$\frac{158.51}{158.58}$
89
45

288.30
-052 0.43
288.30

-003
.66A.

#14639

-004
.73A.

-049
37A.

MAY