


235.84

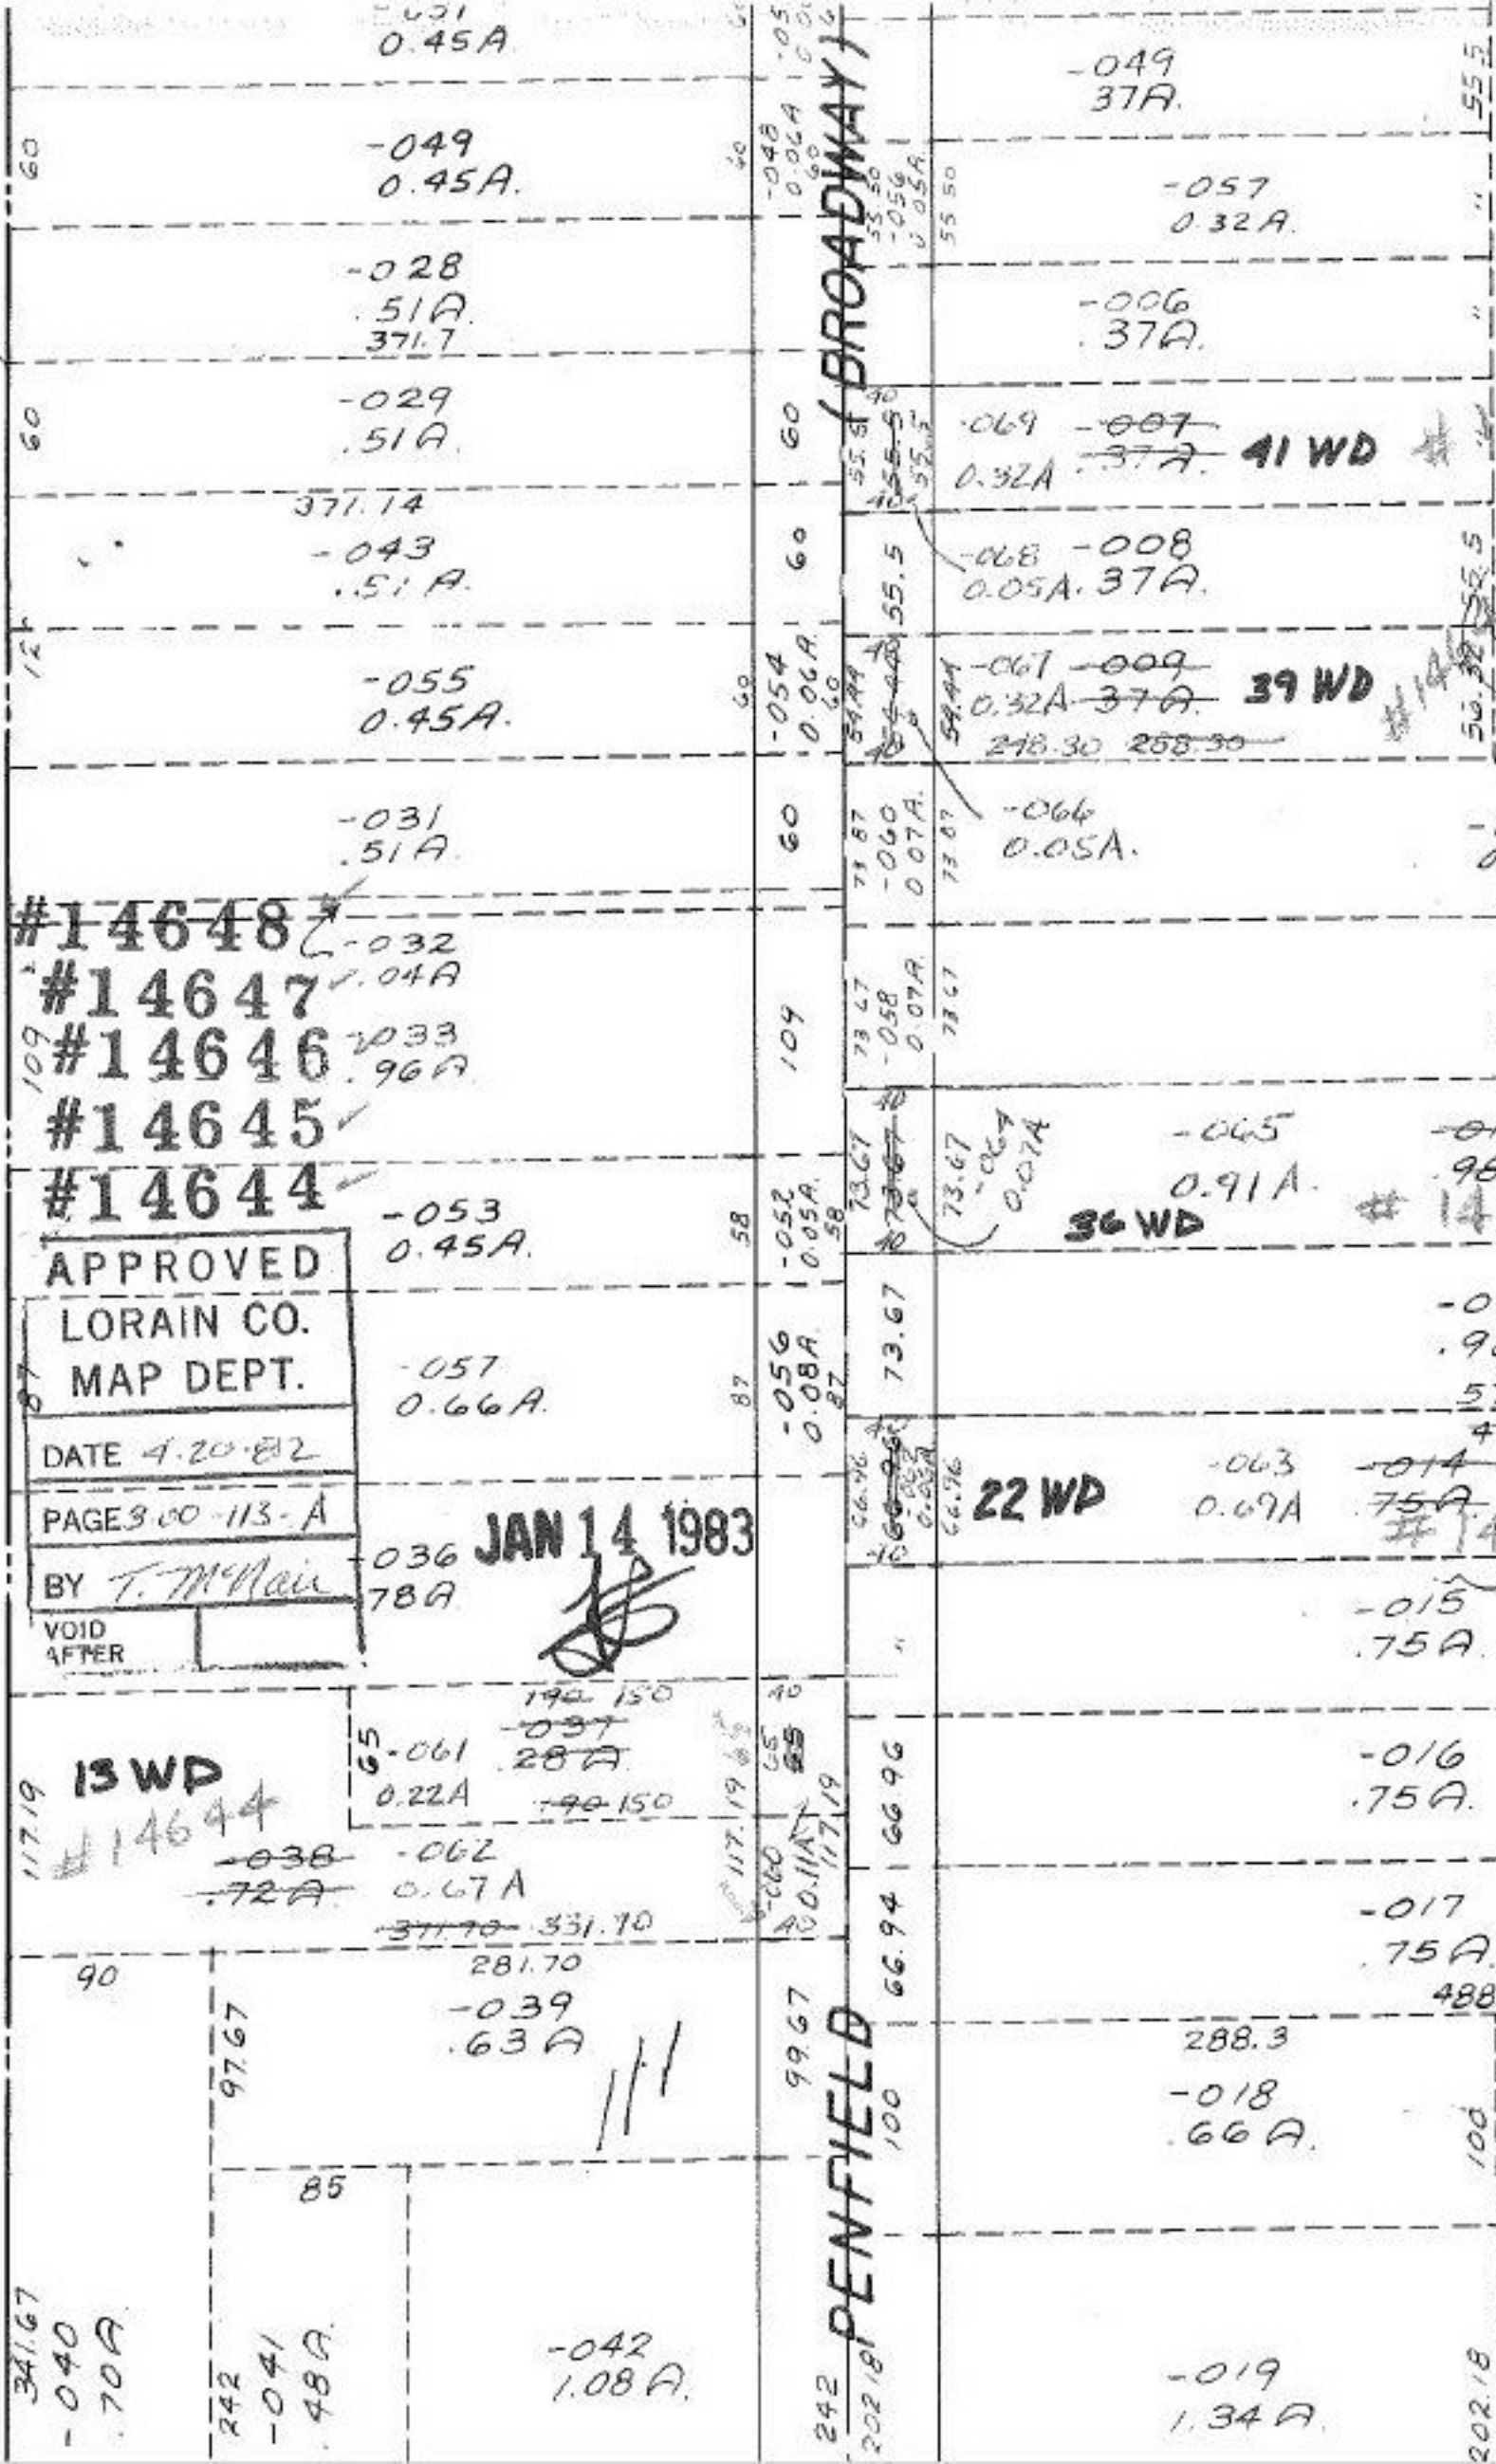

BLK 102

#14648 ✓
 #14647 ✓
 #14646 ✓
 #14645 ✓
 #14644 ✓

APPROVED
 LORAIN CO.
 MAP DEPT.
 DATE 4.20.82
 PAGE 300-113-A
 BY T. McNeil
 VOID AFTER

JAN 14 1983

BLK 102 300-113-102-03E

13WP
 #14644

22WP

36WP

39WP

41WP

BLK 104

#14648

341.67
 -040
 .70A

242
 -041
 .48A

-042
 1.08A

242
 20218
 PENFIELD

-019
 1.34A

20218
 30218

-020
 .76A