


235.84

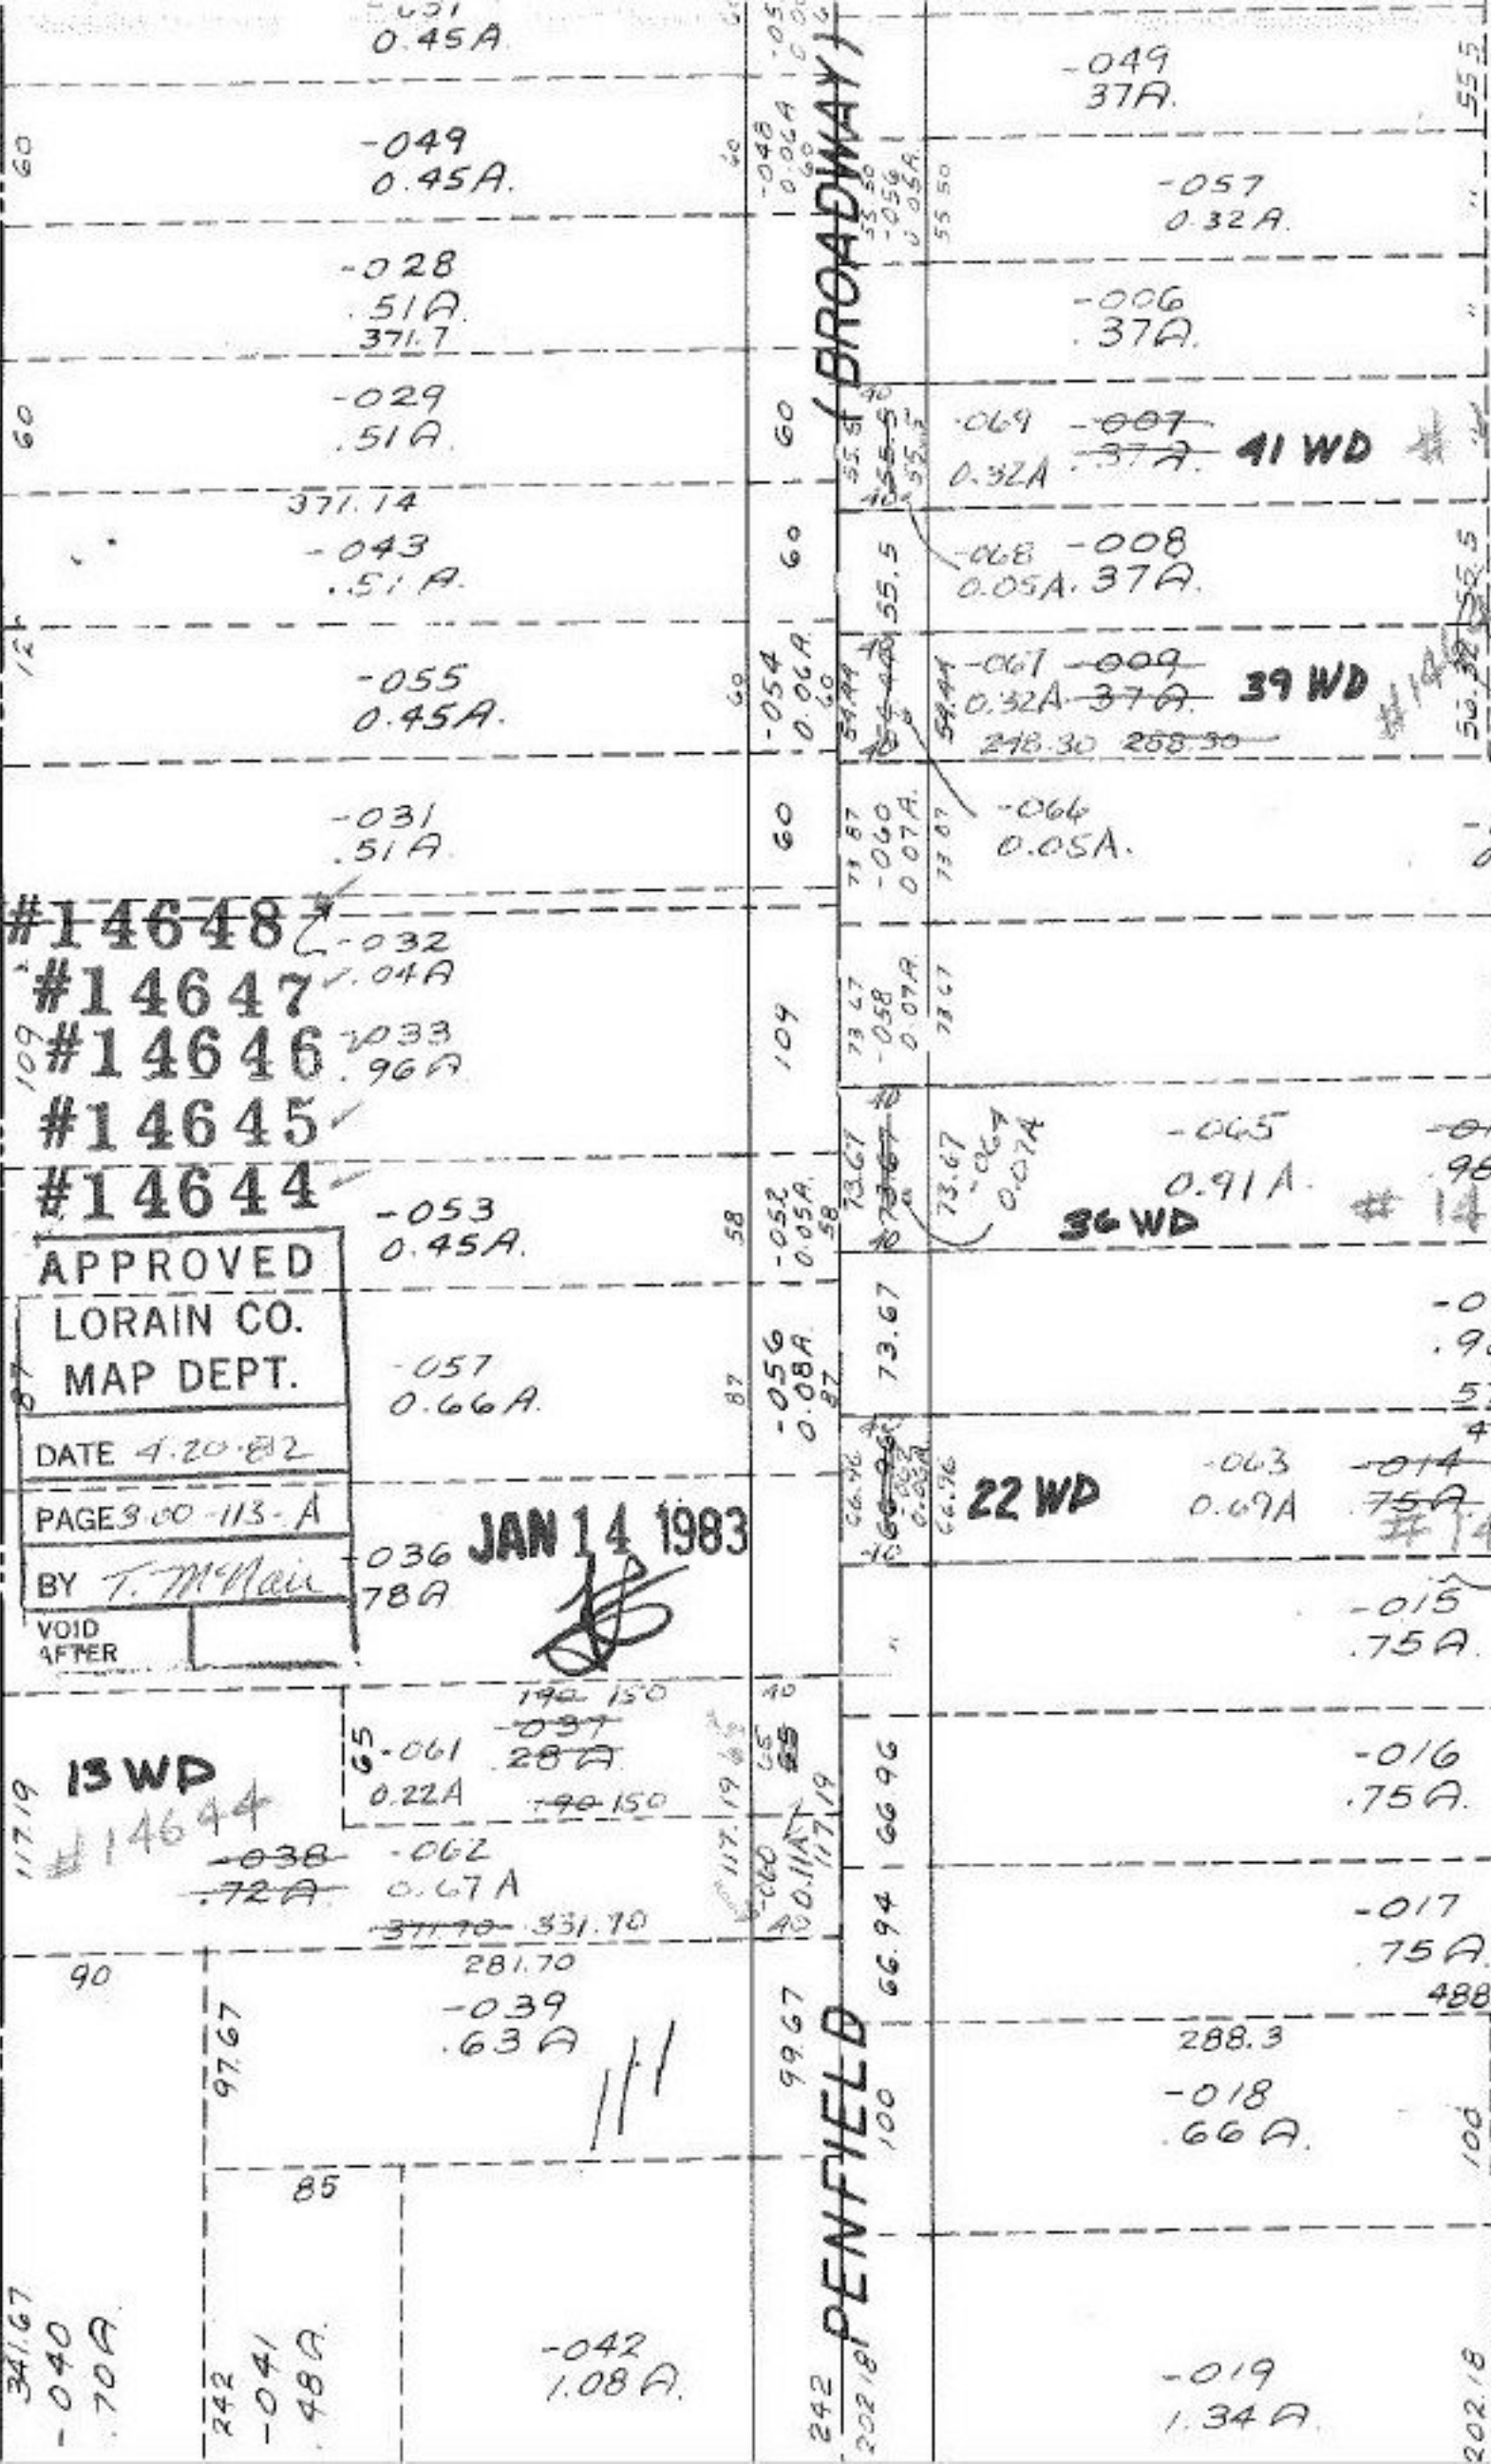

BLK 102

#14648 ✓
 #14647 ✓
 #14646 ✓
 #14645 ✓
 #14644 ✓

APPROVED
 LORAIN CO.
 MAP DEPT.
 DATE 4.20.82
 PAGES 00-113-A
 BY T. McNeil
 VOID AFTER

JAN 14 1983

BR 36 329 444
 05 00 113-102-05E

13WP
 #14644

22WP

36WP

41WP

39WP

#14646

#14645

#14648

BLK 104

341.67
 -040
 .70A

242
 -041
 .48A

-042
 1.08A

242
 202/8
 PENFIELD

-019
 1.34A

202/8
 202/8

-020
 .76A