


235.84

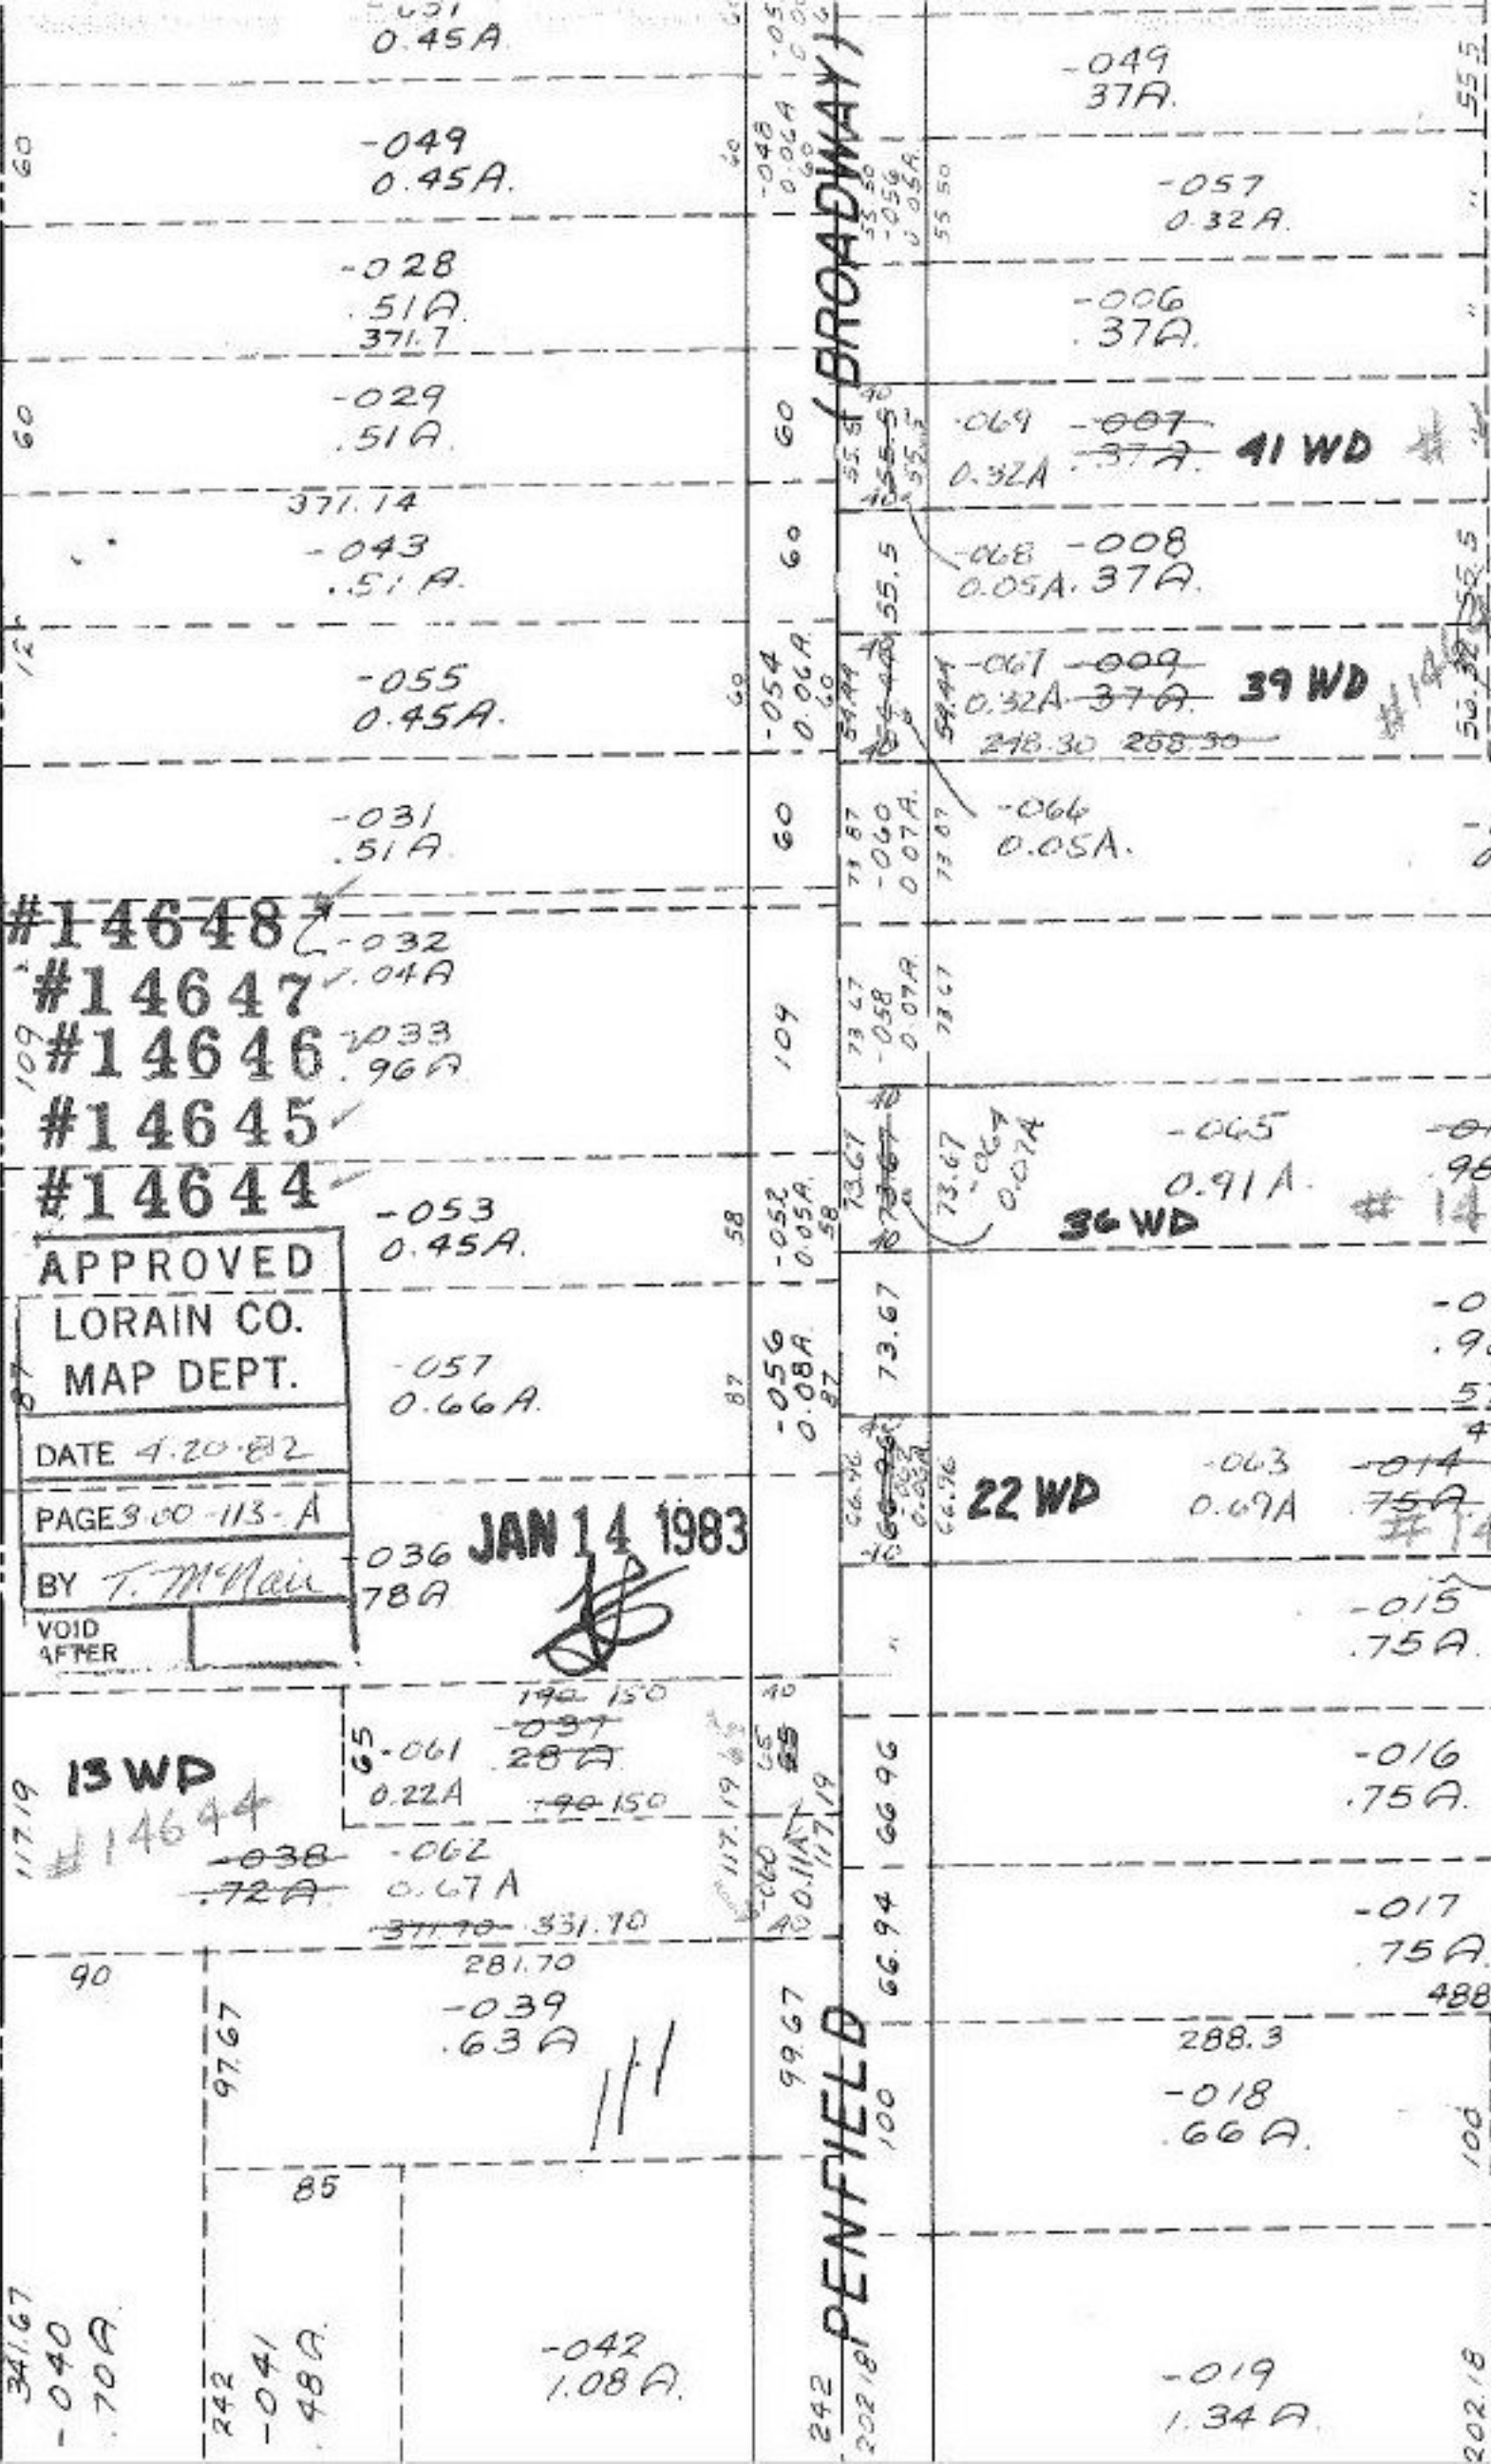

BLK 102

4648

BLK 104

#14648 ✓
 #14647 ✓
 #14646 ✓
 #14645 ✓
 #14644 ✓

APPROVED
 LORAIN CO.
 MAP DEPT.
 DATE 4.20.82
 PAGES 00-113-A
 BY T. McNeil
 VOID AFTER

JAN 14 1983

BR 36 329 444
05 00 113-102-05E

13WP

22WP

36WP

39WP

41WP

341.67
-040
.70A

242
-041
.48A

-042
1.08A

242
202/8
PENFIELD

-019
1.34A

202/8
202/8

-020
.76A

117.19
#14644

-038
.72A

-062
0.67A

311.70 331.70

-039
.63A

192 150
-037
.28A
192 150

65
-061
0.22A

-016
.75A

-017
.75A

488

288.3
-018
.66A

-013
.98A

576.6
488 448

-063
0.67A

-014
.75A
#14645

-015
.75A

-012
.98A

#14646

-065
0.91A

-067
0.07A

-059
0.91A

-061
0.88A

536.60

-066
0.05A

-067 -009
0.32A 37A
248.30 258.30

39WP

-068 -008
0.05A 37A

-069 -007
0.32A 37A

41WP

-006
37A

-057
0.32A

-049
37A

0.45A

-049
0.45A

-028
.51A
371.7

-029
.51A

371.14

-043
.51A

-055
0.45A

-031
.51A

-032
.04A

-033
96A

-053
0.45A

-057
0.66A

036
78A

65
-061
0.22A

-038
.72A

281.70

-039
.63A

97.67

85

99.67

66.94

66.94

117.19

65

65

60

60

55.5

55.5

110

100

100

100

BROADWAY

PENFIELD