

#14659

#14655

PARCEL SIZE CORRECTION

FRONTAGE & DEPTH

APPROVED
LORAIN CO.
MAP DEPT.

JAN 21 1983


DATE 4-26-82

PAGE 5-00-012-A

BY T. Myer

VOID
AFTER

SEE 5-00-013-A

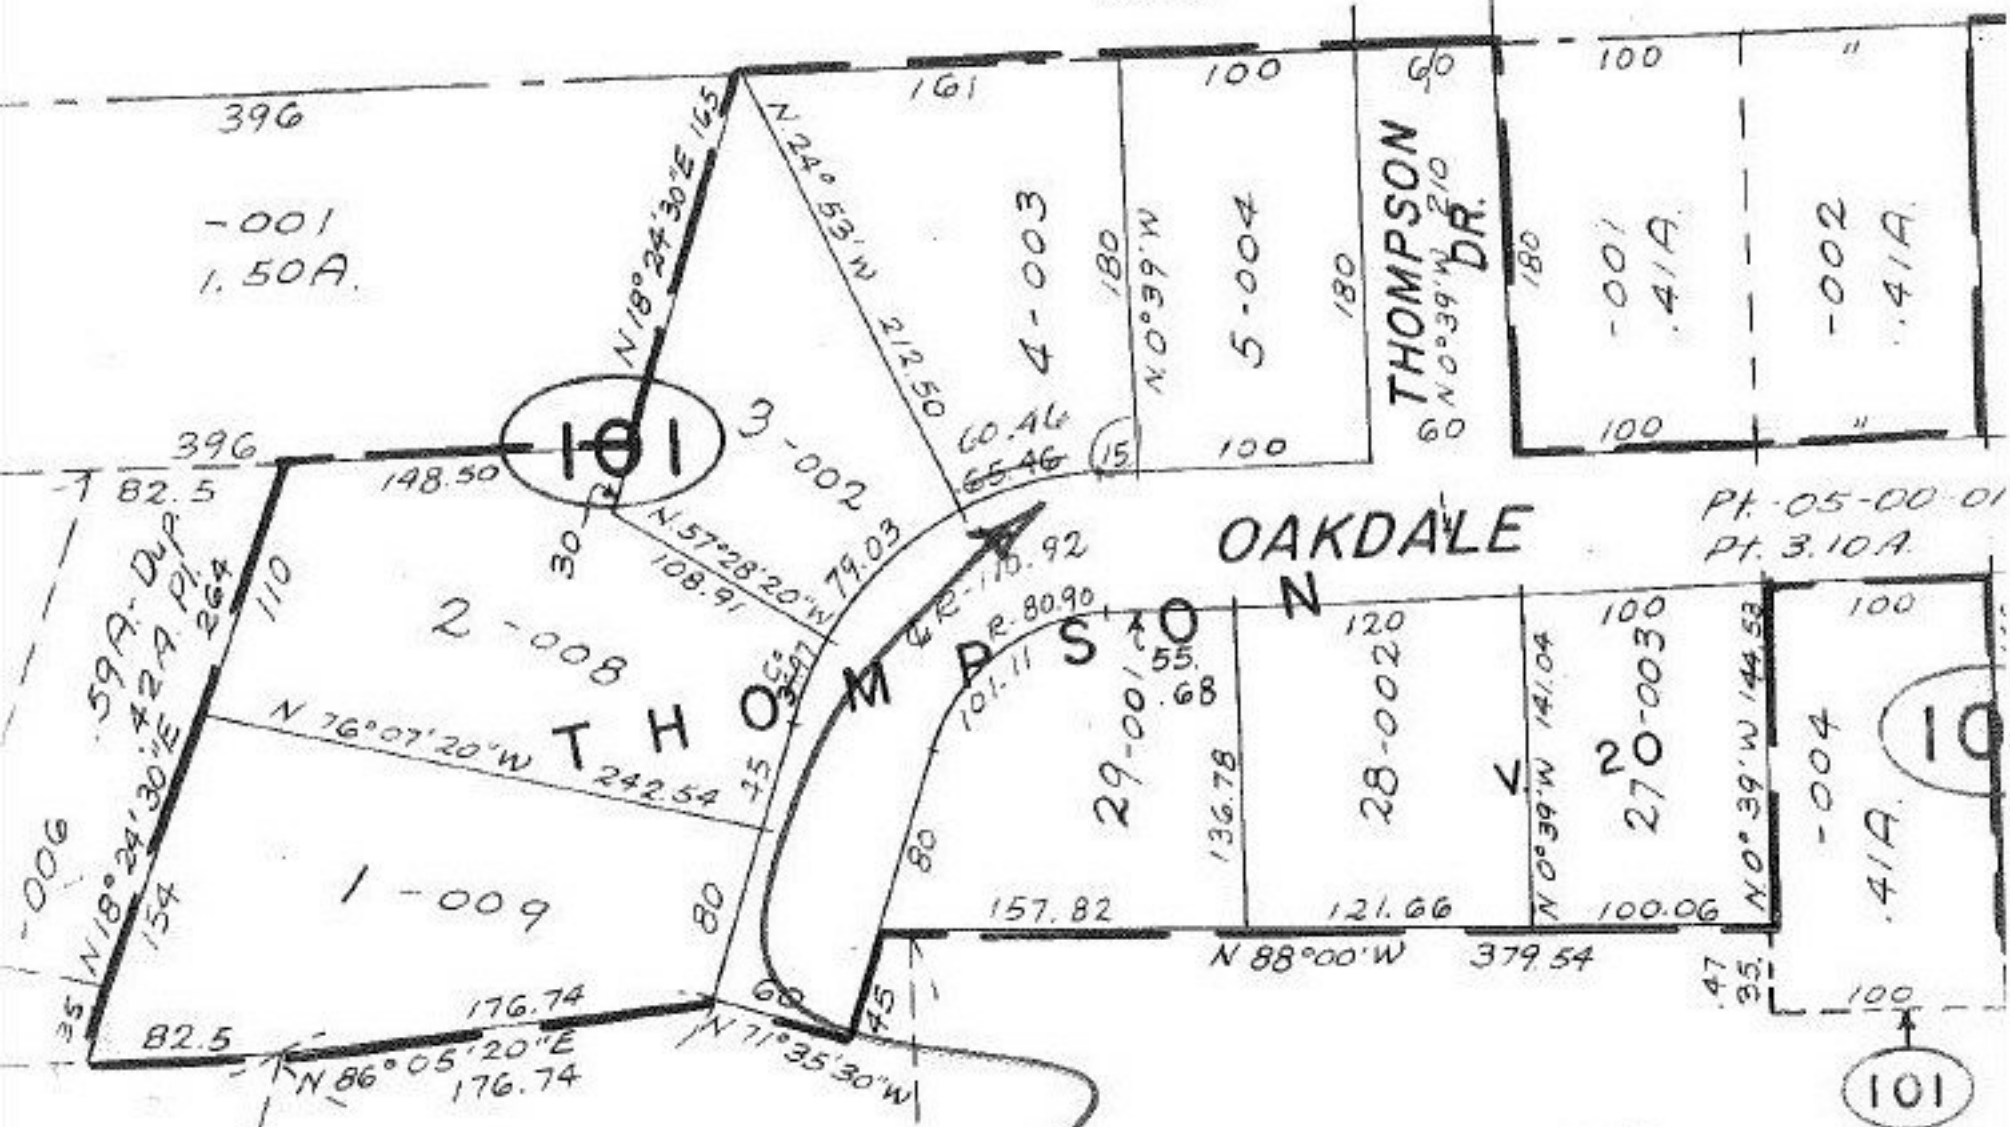

OAKDALE

Pt. 05-00-01
Pt. 3.10A

PER PLAT

20/29-A //

Pt. 05-00-012-103-013
Pt. 7.07A.