

NEW LONDON

EASTERN

9

#14663

APPROVED
LORAIN CO.
MAP DEPT.

DATE 5-1-82


PAGE 20-F

BY T. McHair

VOID
AFTER

-013
119.87 A.
G FEB 25 1983

SEE SURVEY - GRINDLE & BENDER
WILLIAM L. FOX

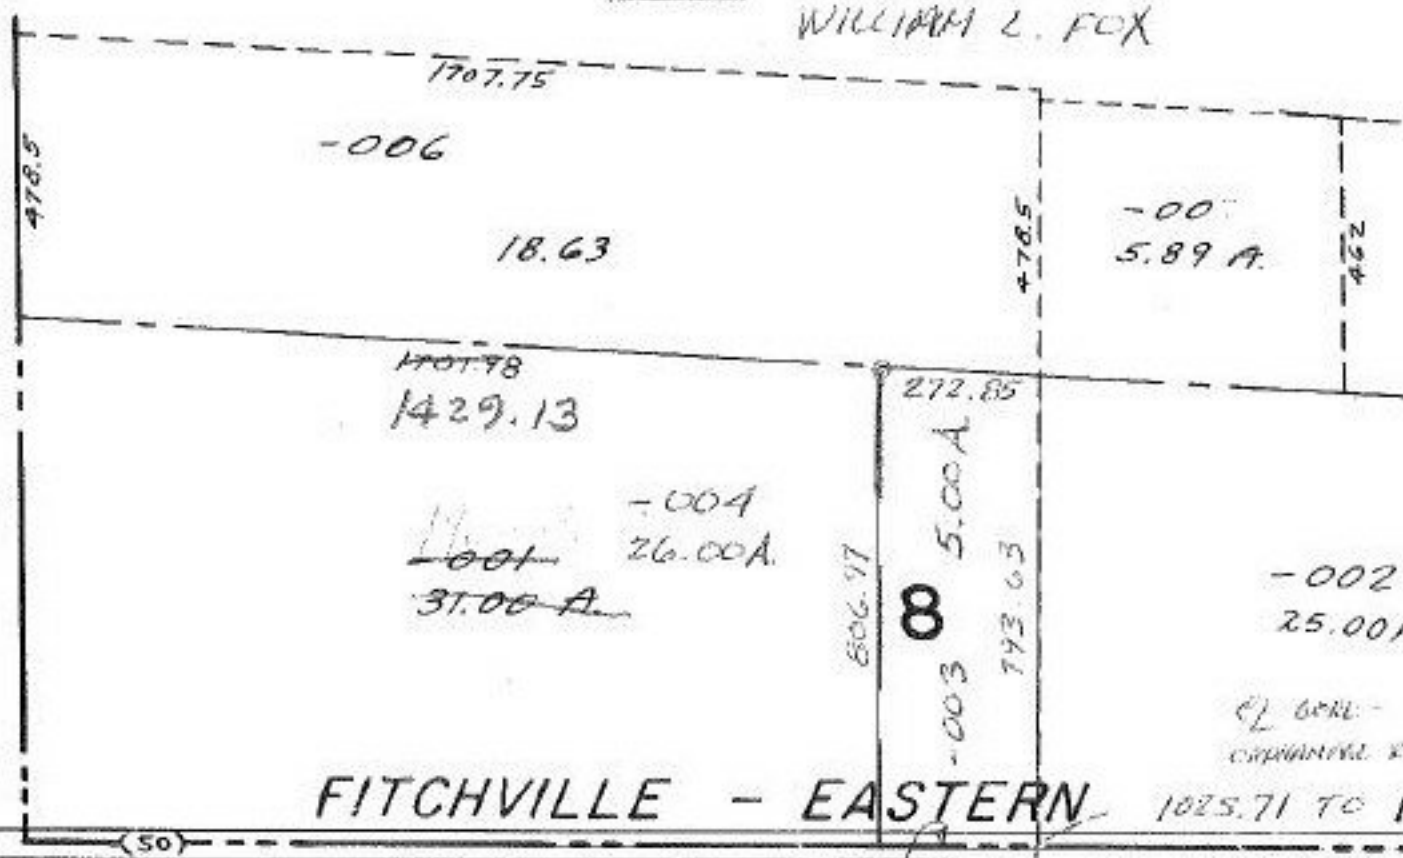

1701.98
272.85
1429.13

ROCHESTER T

SCALE: 1" = 400'