


SEE

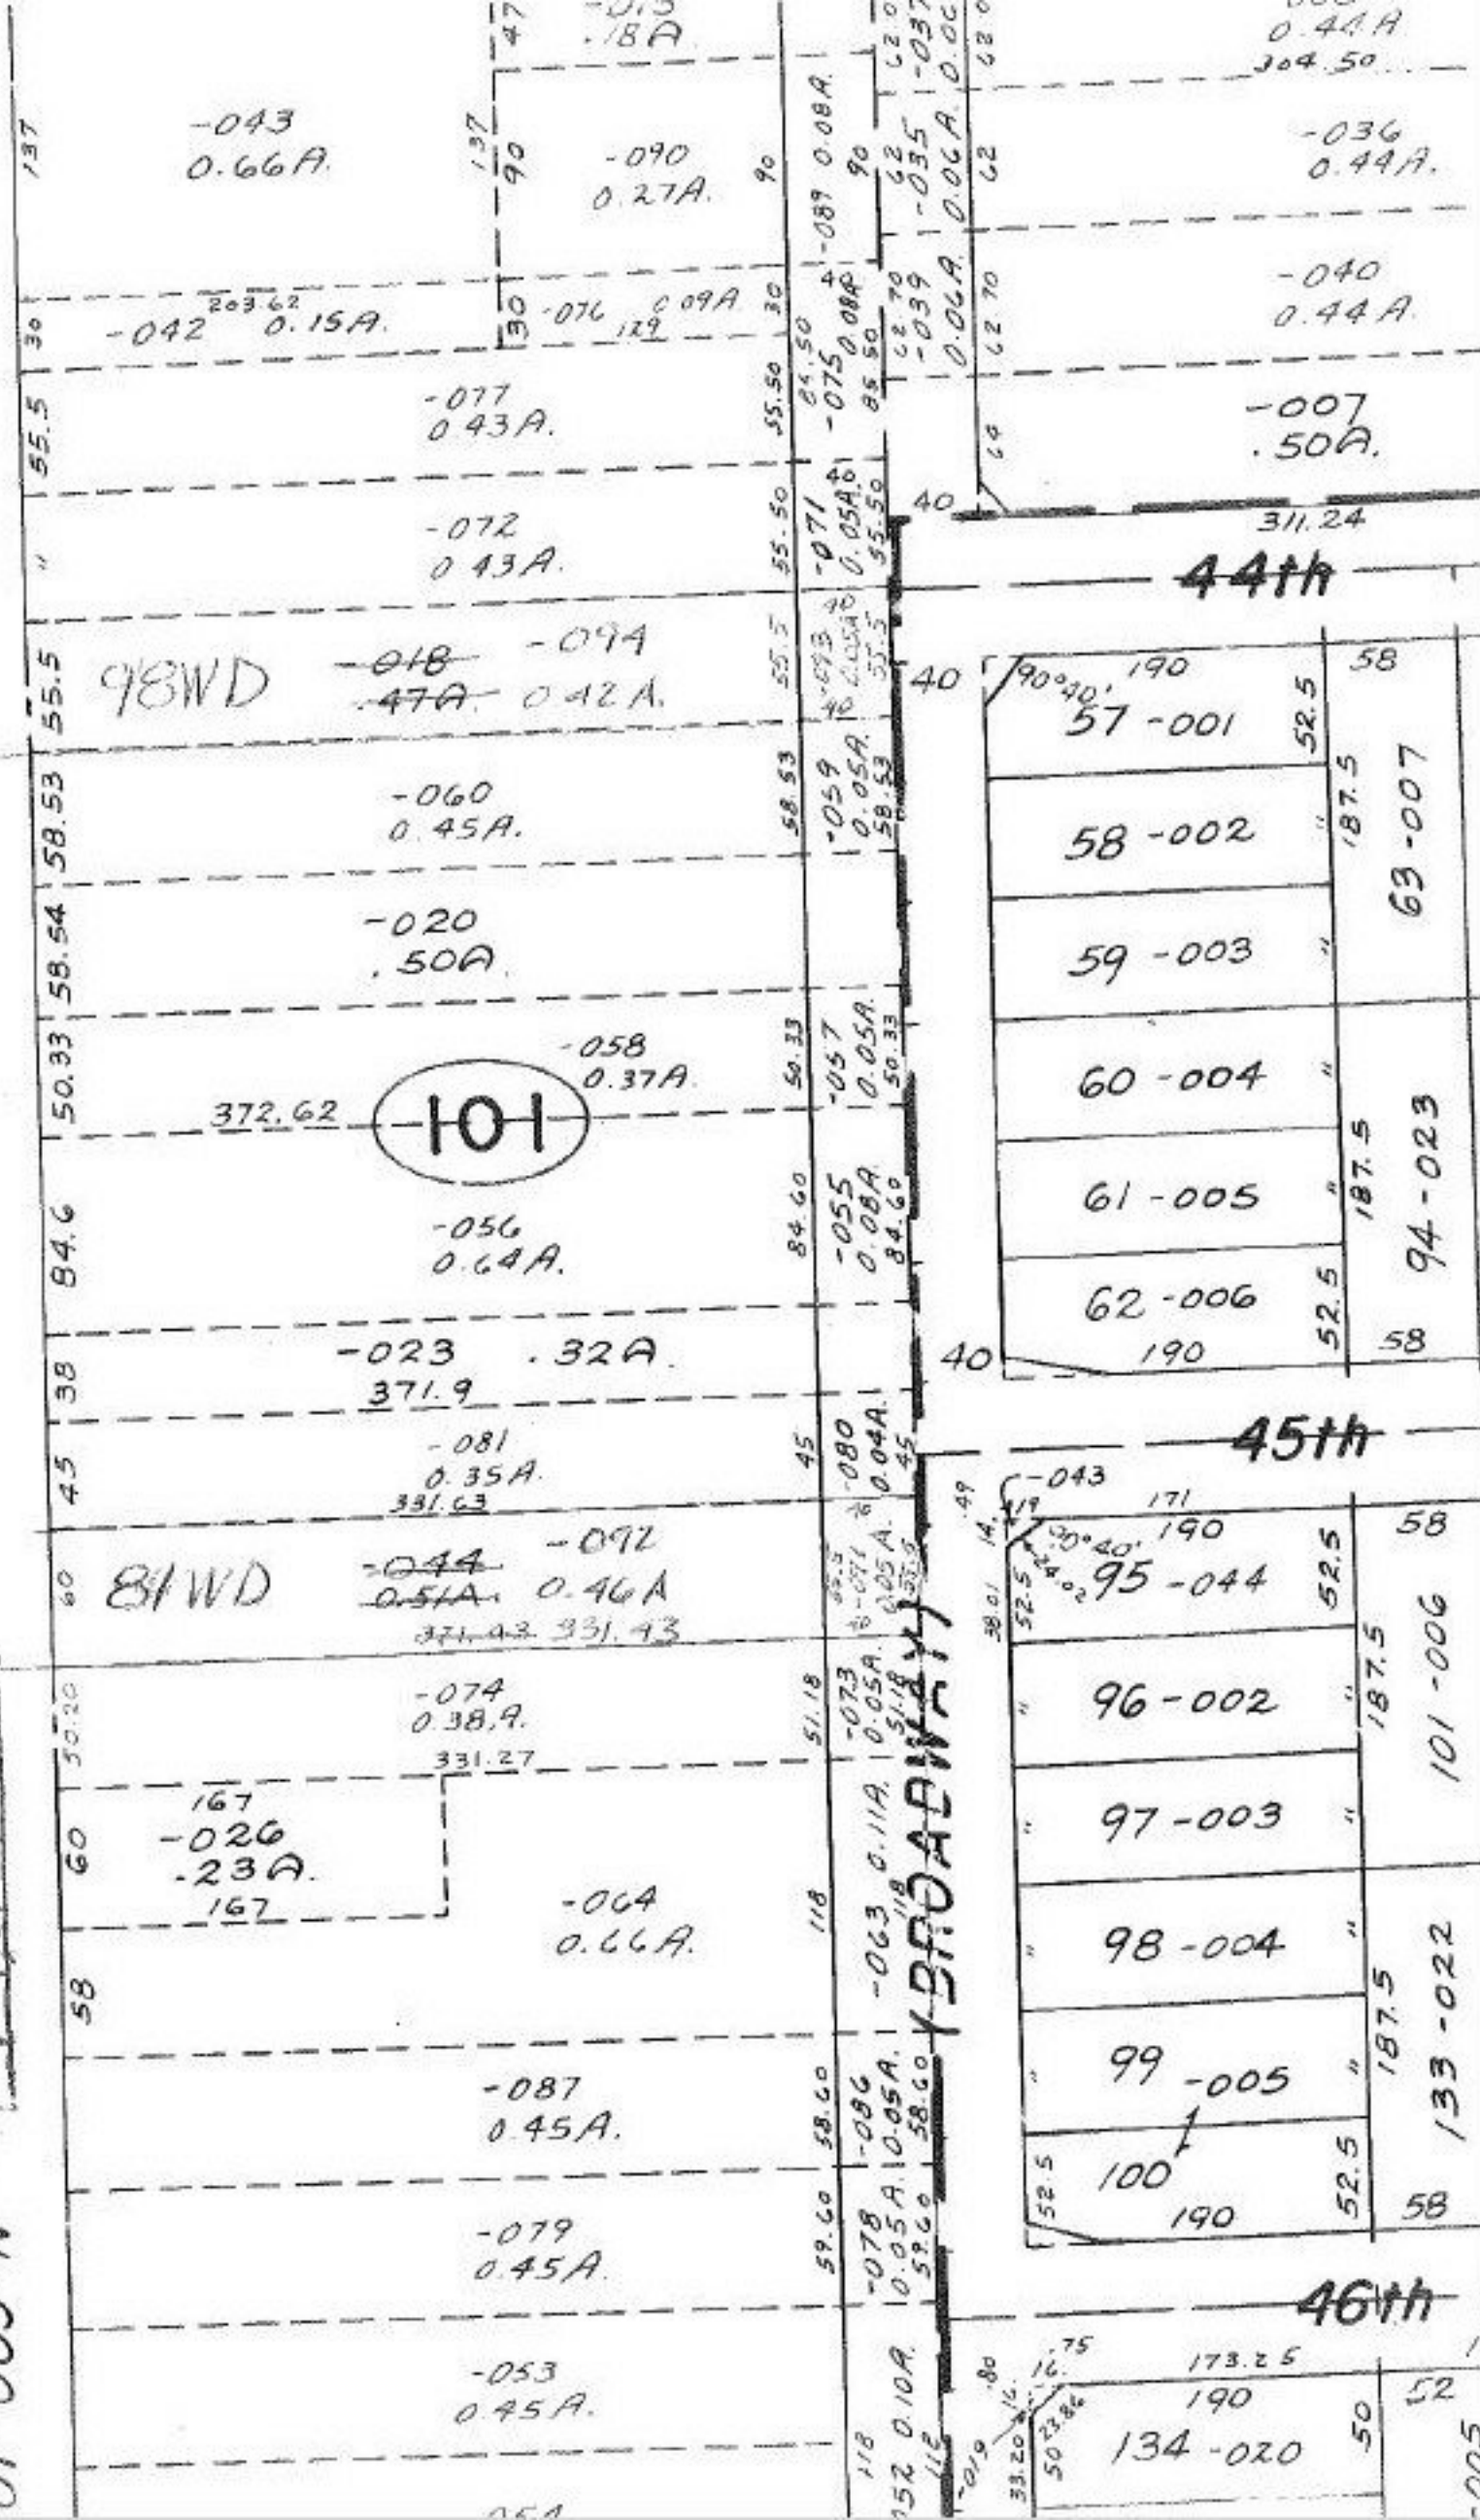

#14667

#14666

APPROVED
LORAIN CO.
MAP DEPT.

DATE 5 11 82

PAGE 3-00-108-A

BY *T. McHain*

VOID
AFTER

JAN 14 1983

[Signature]

01-003-N