


SEE 7-00-011-C

CHANGE PAGE 7-H

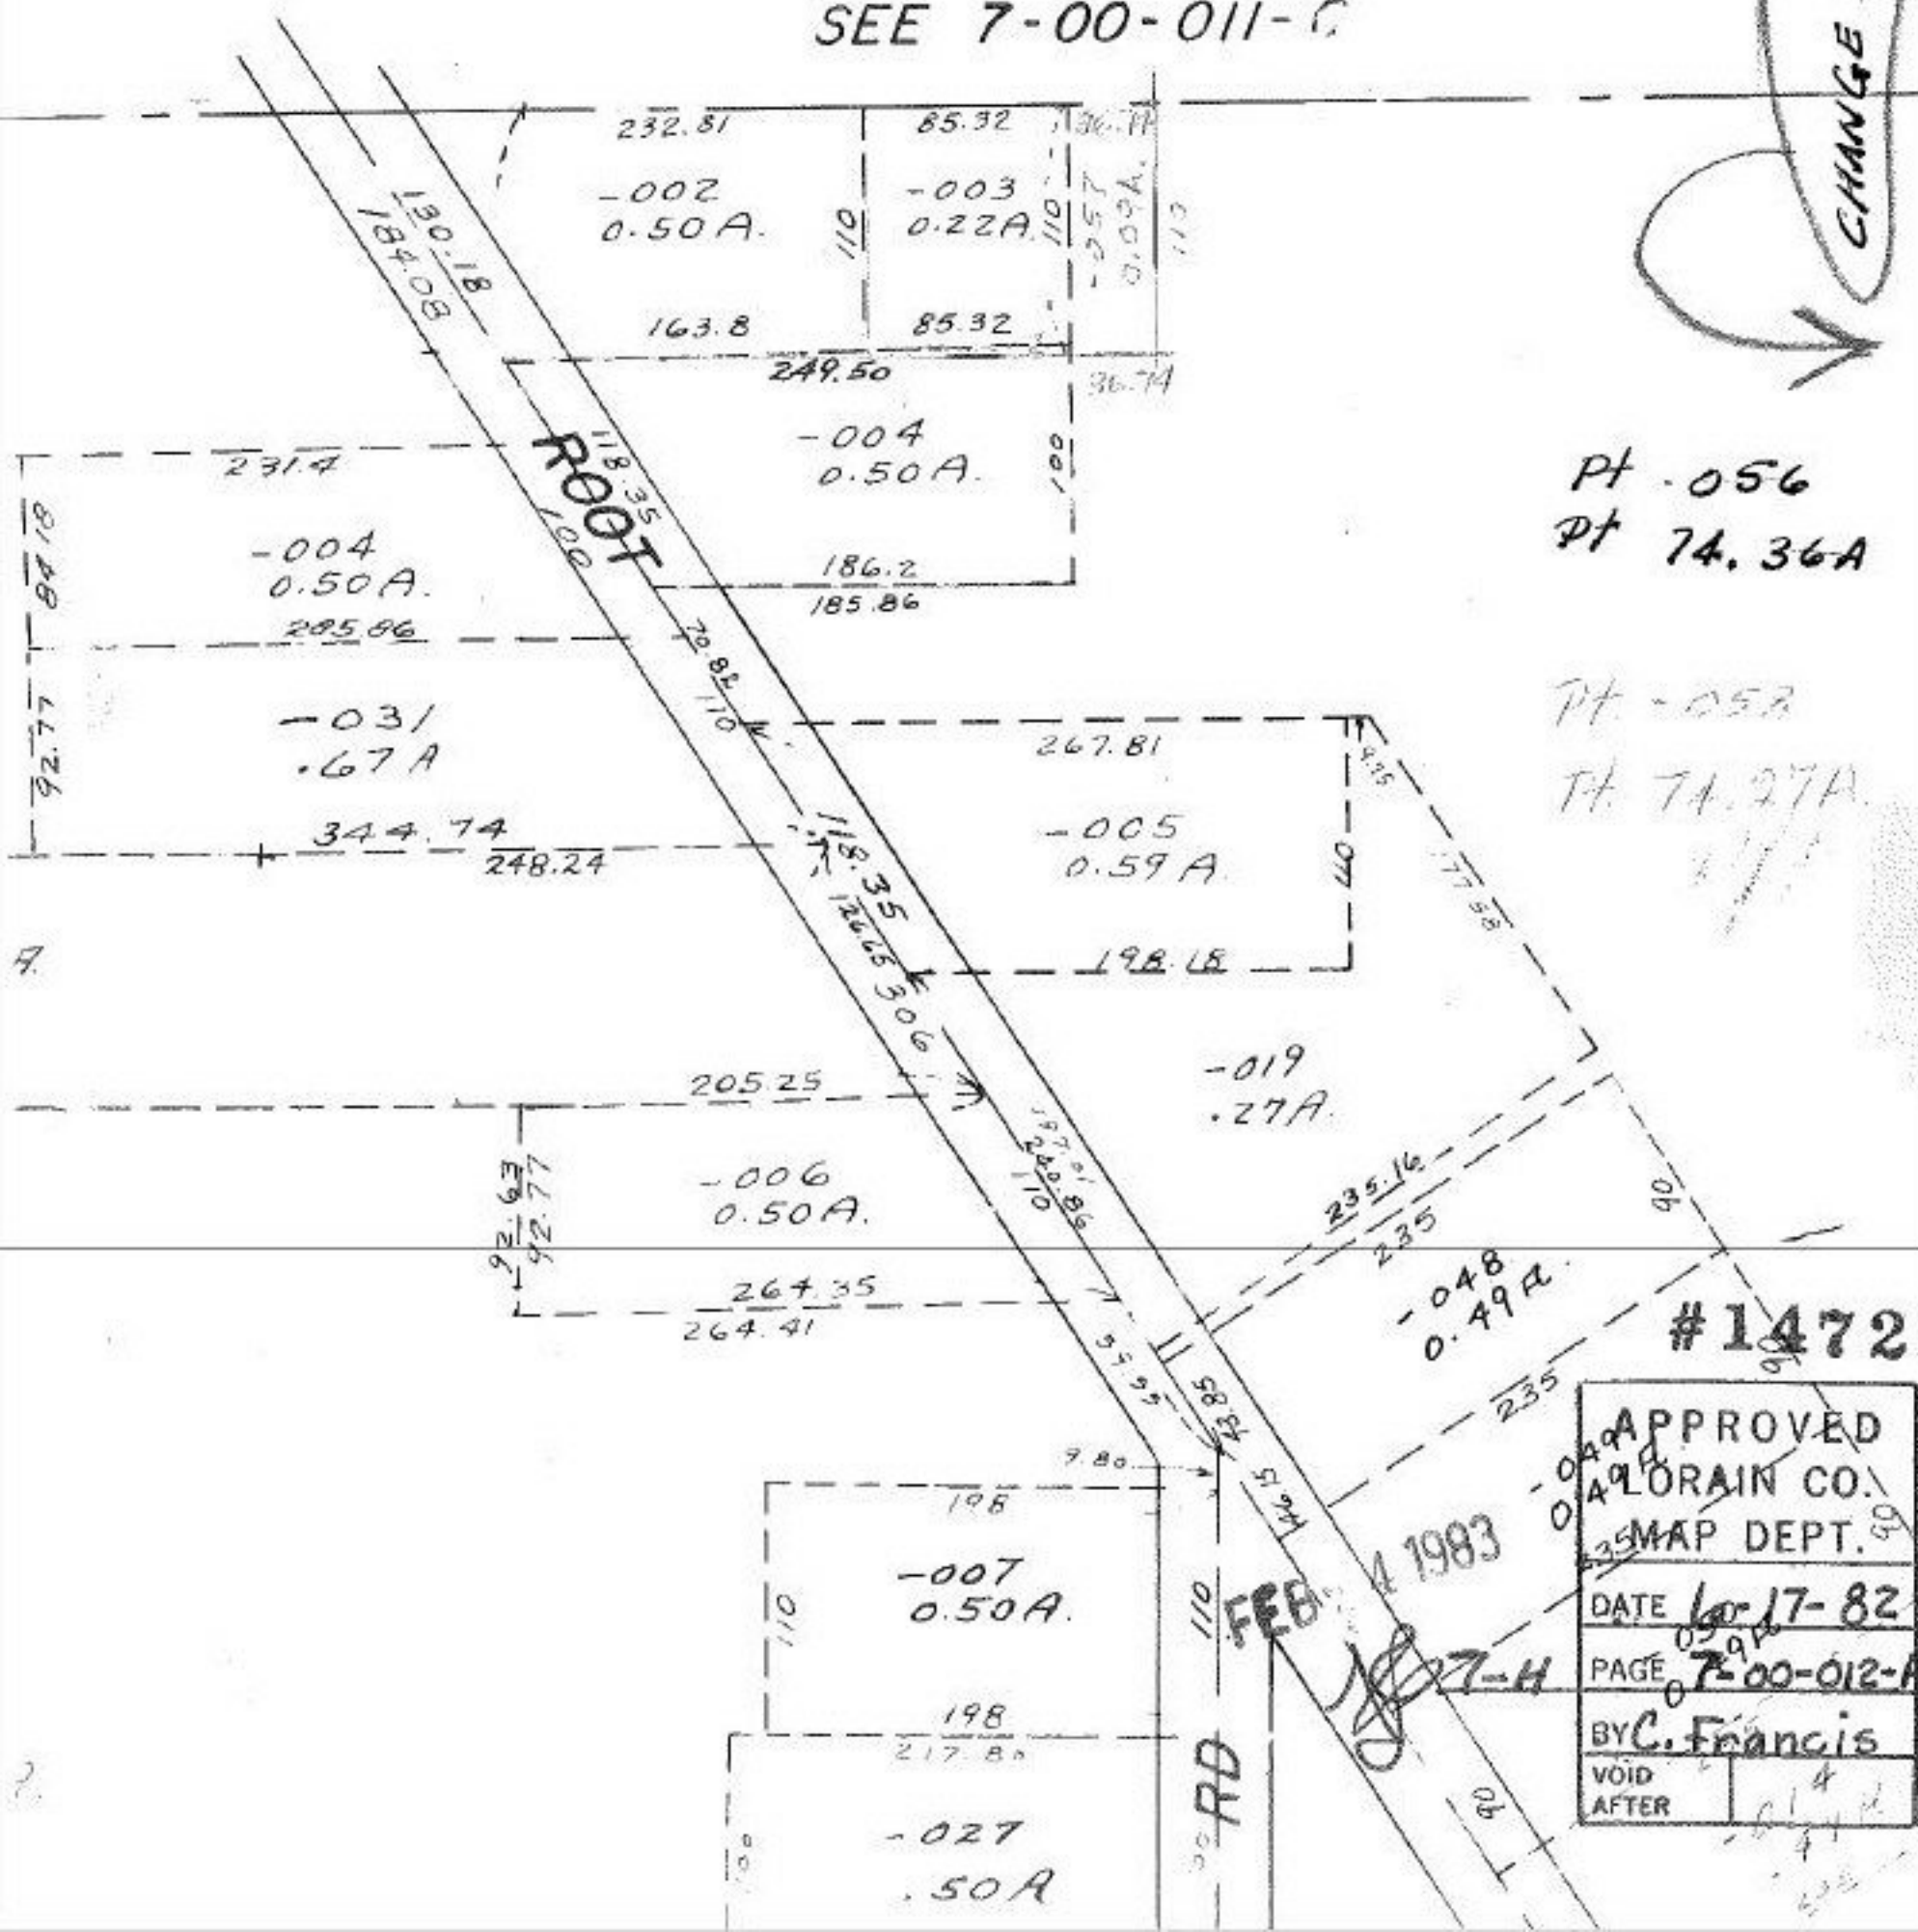

Pt .056  
Pt 74.36A

Pt .053  
Pt 74.27A

#14728

|            |            |
|------------|------------|
| APPROVED   |            |
| LORAIN CO. |            |
| MAP DEPT.  |            |
| DATE       | 10-17-82   |
| PAGE       | 7-00-012-A |
| BY         | C. Francis |
| VOID AFTER |            |

FEB 4 1983

RD