


SEE 3-00-III-A

254

RIDGE

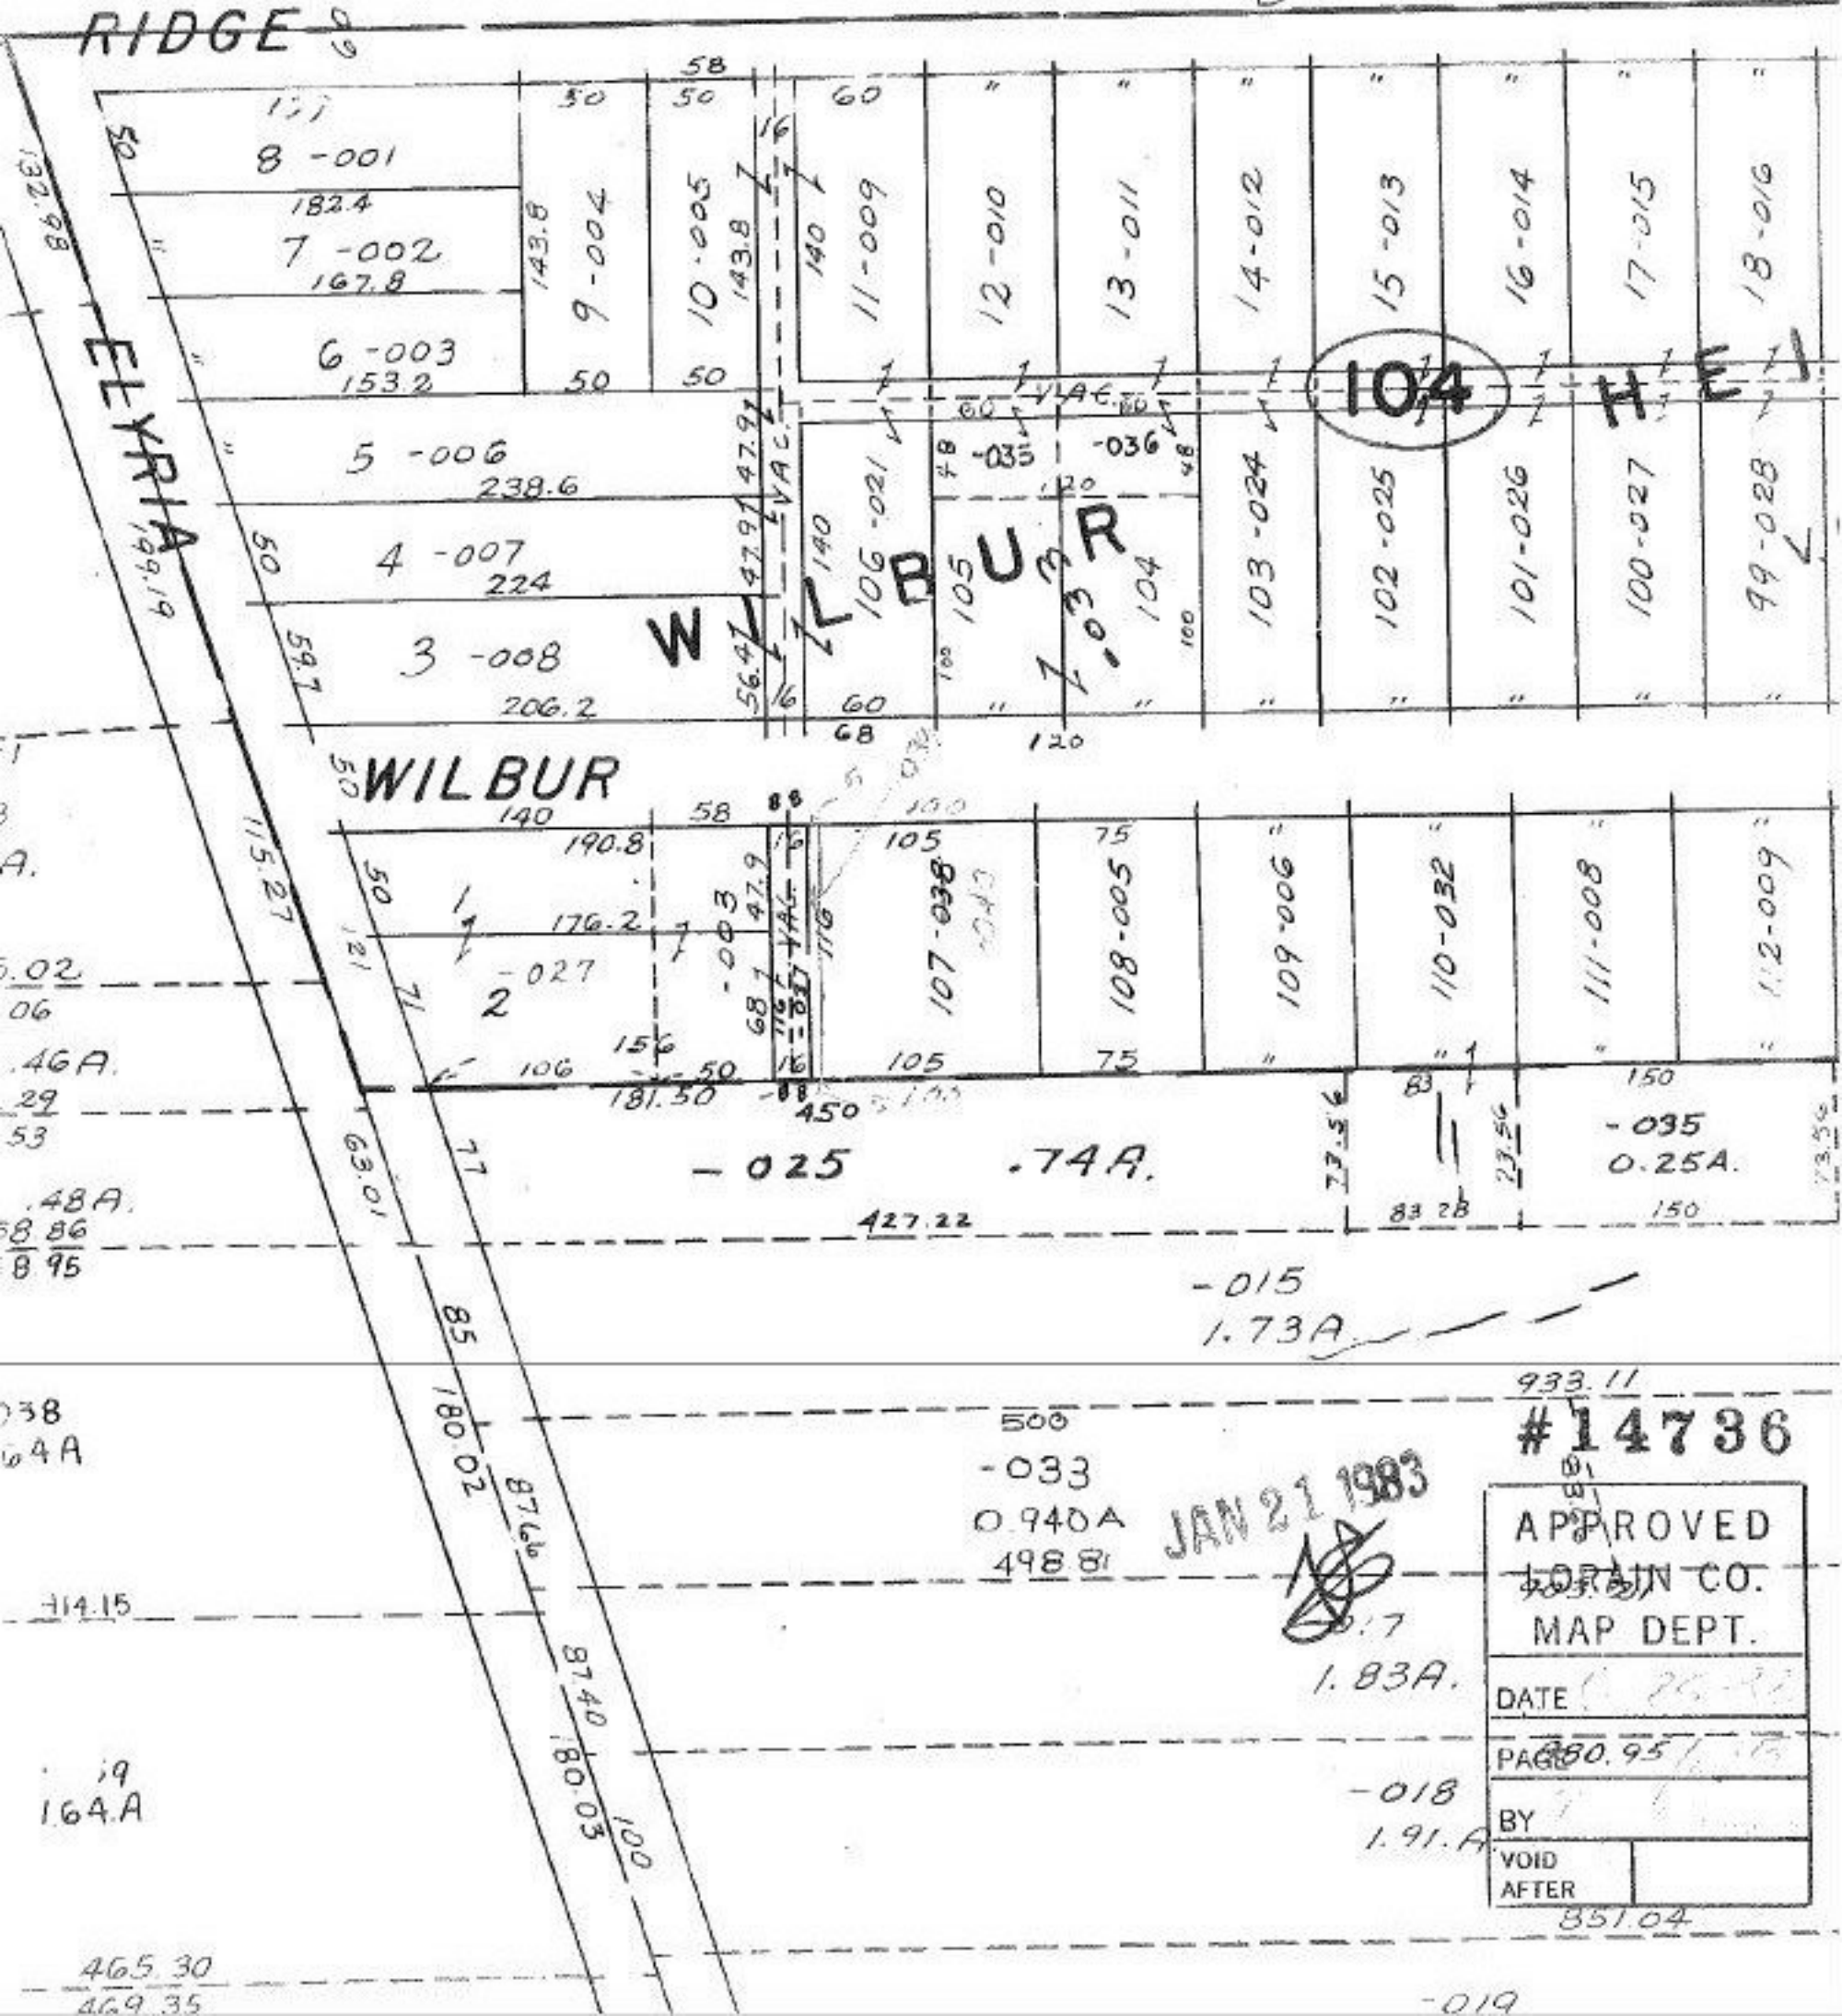

104

WILBUR

HE

#14736

JAN 21 1983

APPROVED  
LORAIN CO.  
MAP DEPT.

DATE 1-25-83

PAGE 80.95/17

BY  
VOID AFTER

851.04

-018  
1.91.A

-019