



RD 60

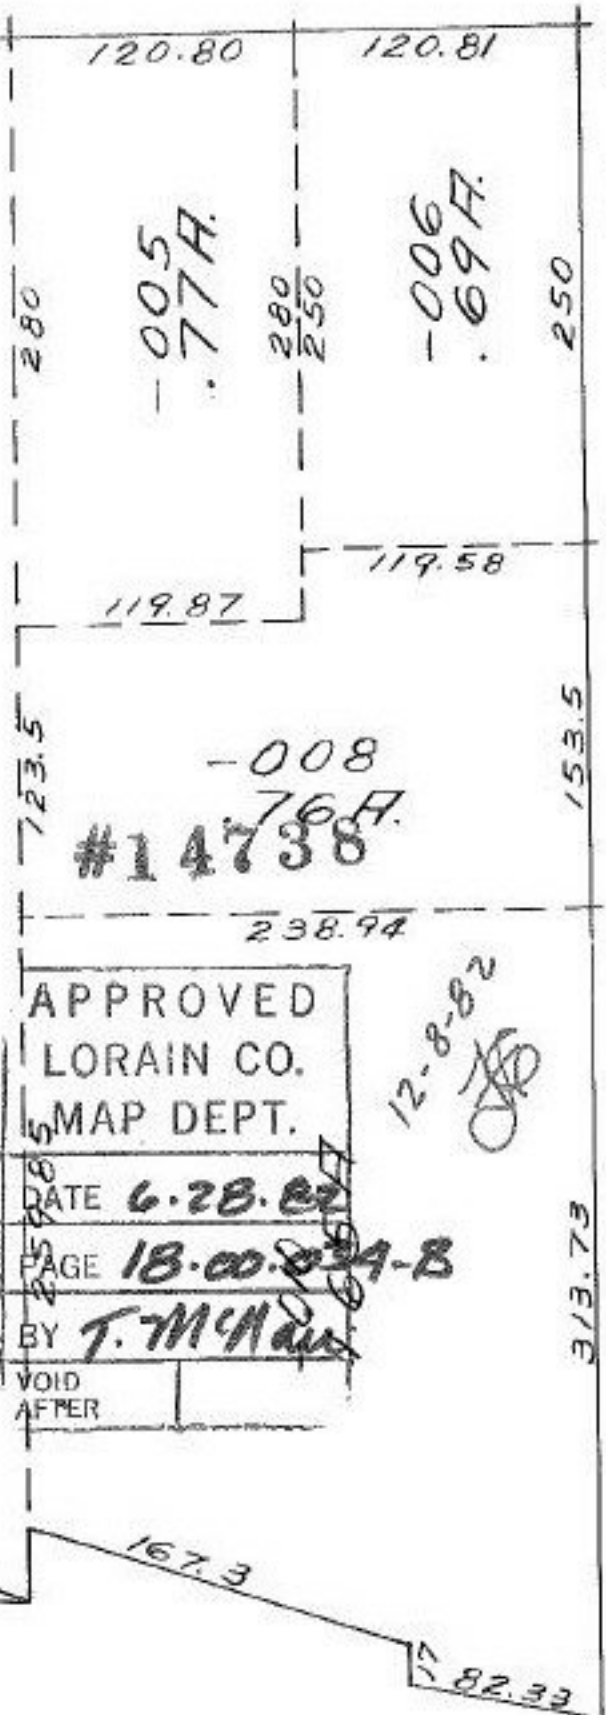

APPROVED
LORAIN CO.
MAP DEPT.
DATE 6.28.82
PAGE 18.00.82A-B
BY T. McNamee
VOID
AFTER

ST. 60

ACREAGE CORRECTION

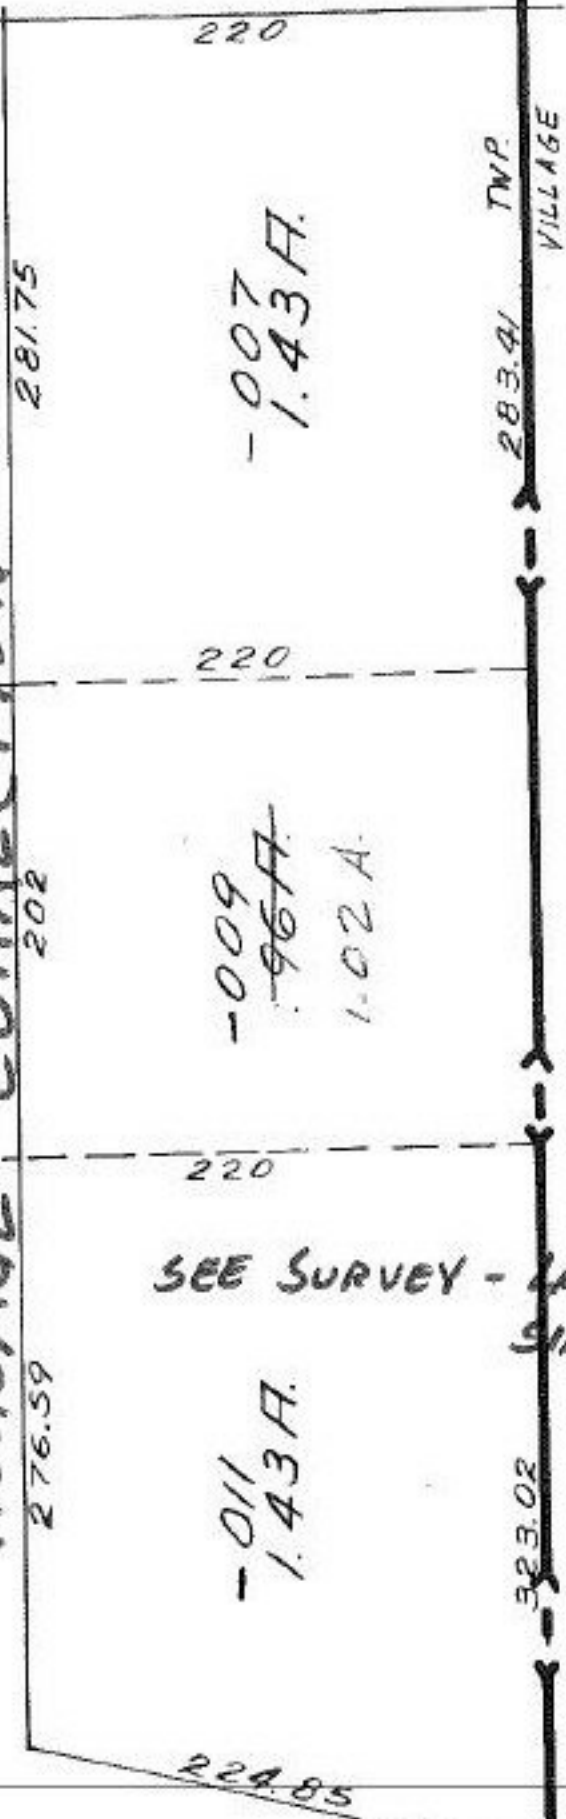


TWP. VILLAGE

SEE SURVEY - LAUNDON.
SIMON. CAHL.
& ASSOC.

60

GAS

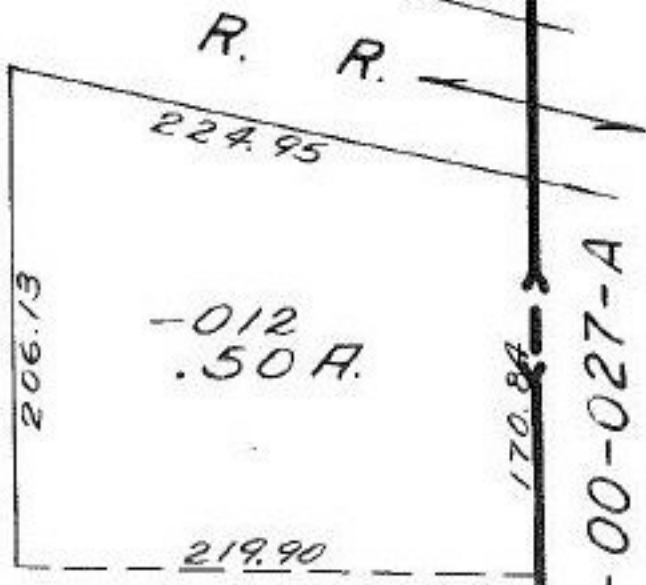

R. R.

FAIRGROUND

ST

8-00-027-A