

Need Deed  
For -042

1648.33  
1648.3

-002  
5-68A

-043  
1-46A

-042  
10-12A


748.51

N. 0°05'00"E. 750.82

1648

270.82

327

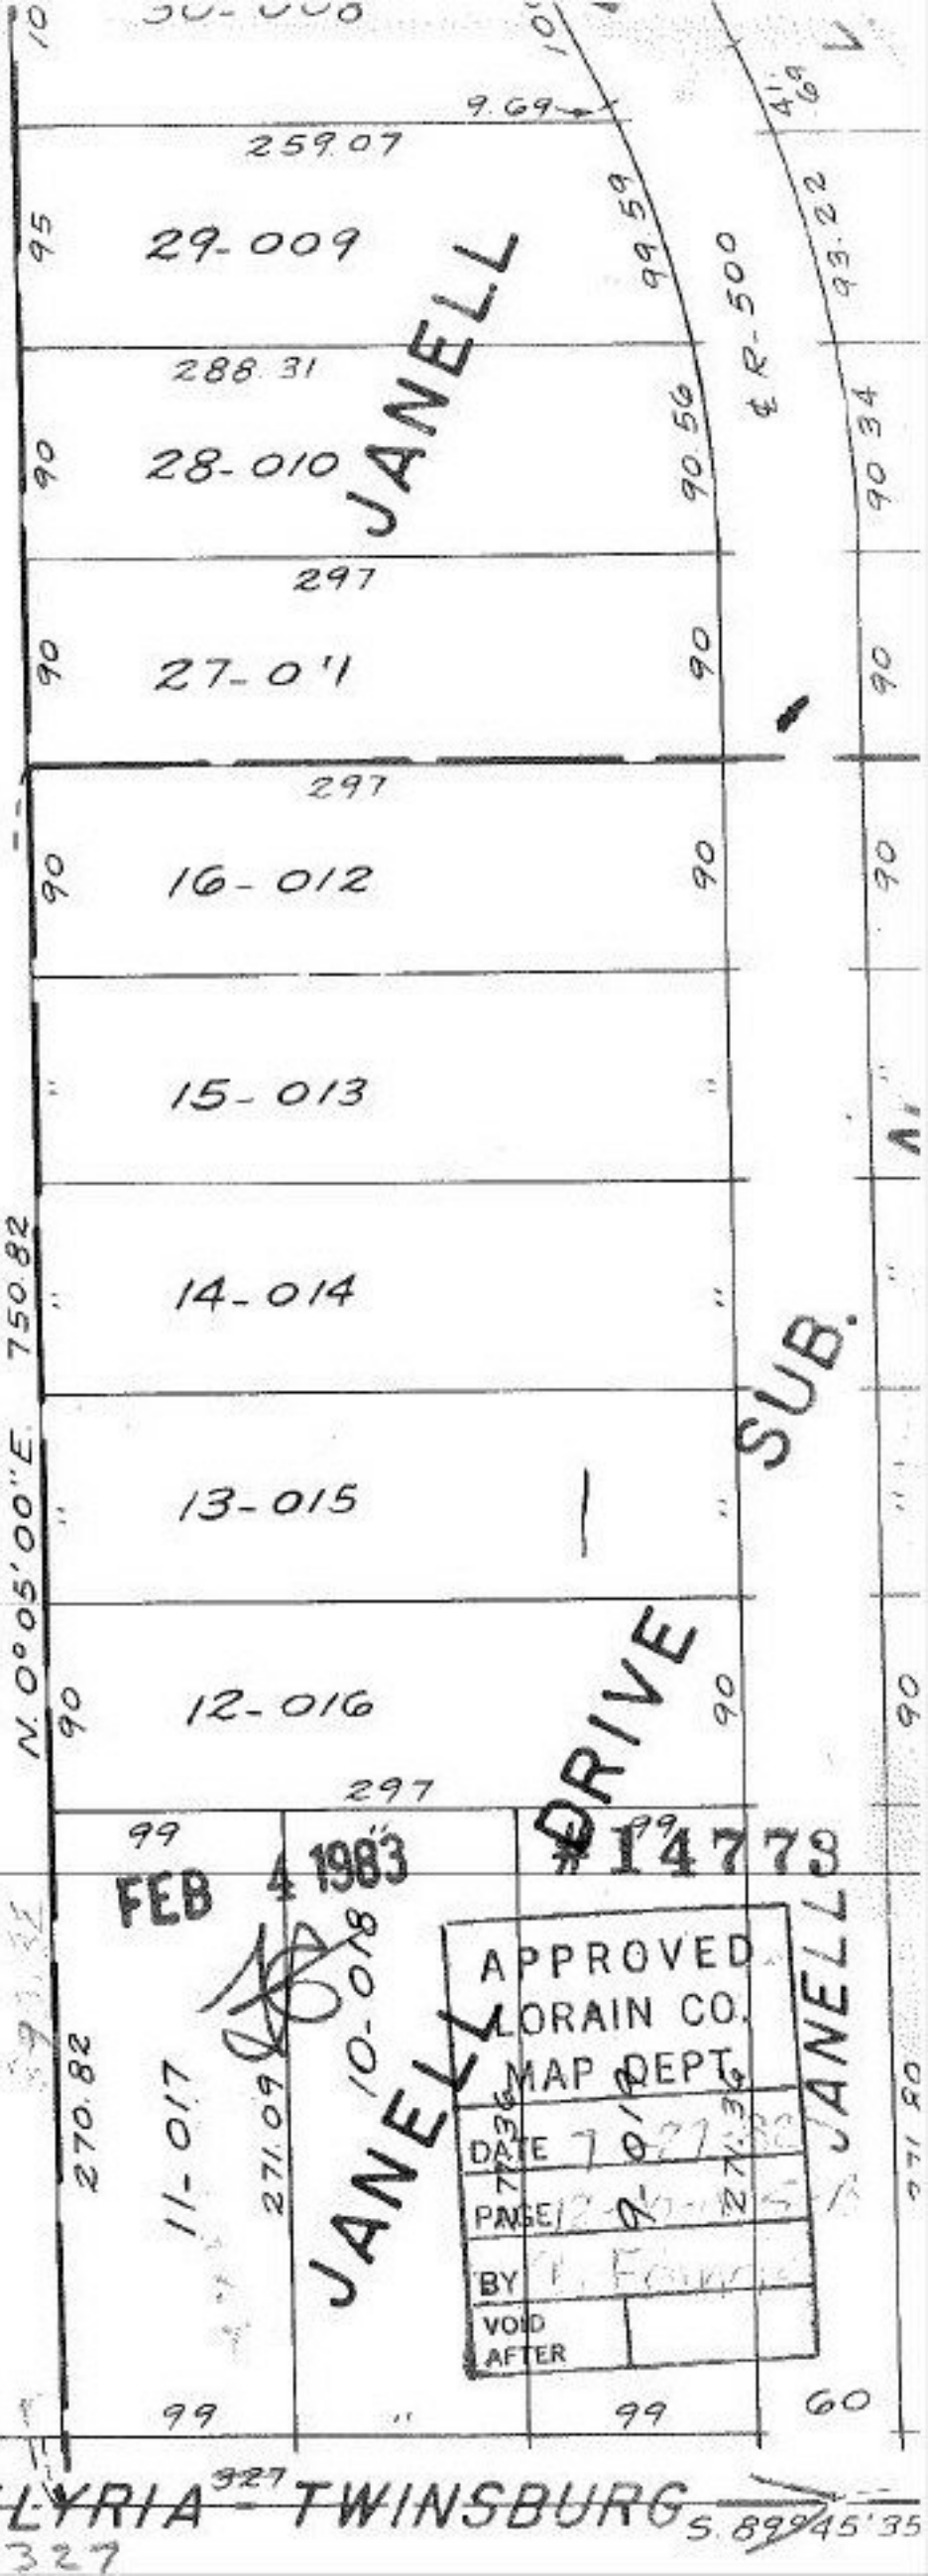

Closure:  
1:142, 857.14

(Considered)

ELYRIA - TWINSBURG 5.89945'35

APPROVED	
LORAIN CO.	
MAP DEPT.	
DATE	7-8-82
PAGE	9-1-82
BY	V. Fournier
VOID	
AFTER	

JANELL

#14778

SUB.