


NTE

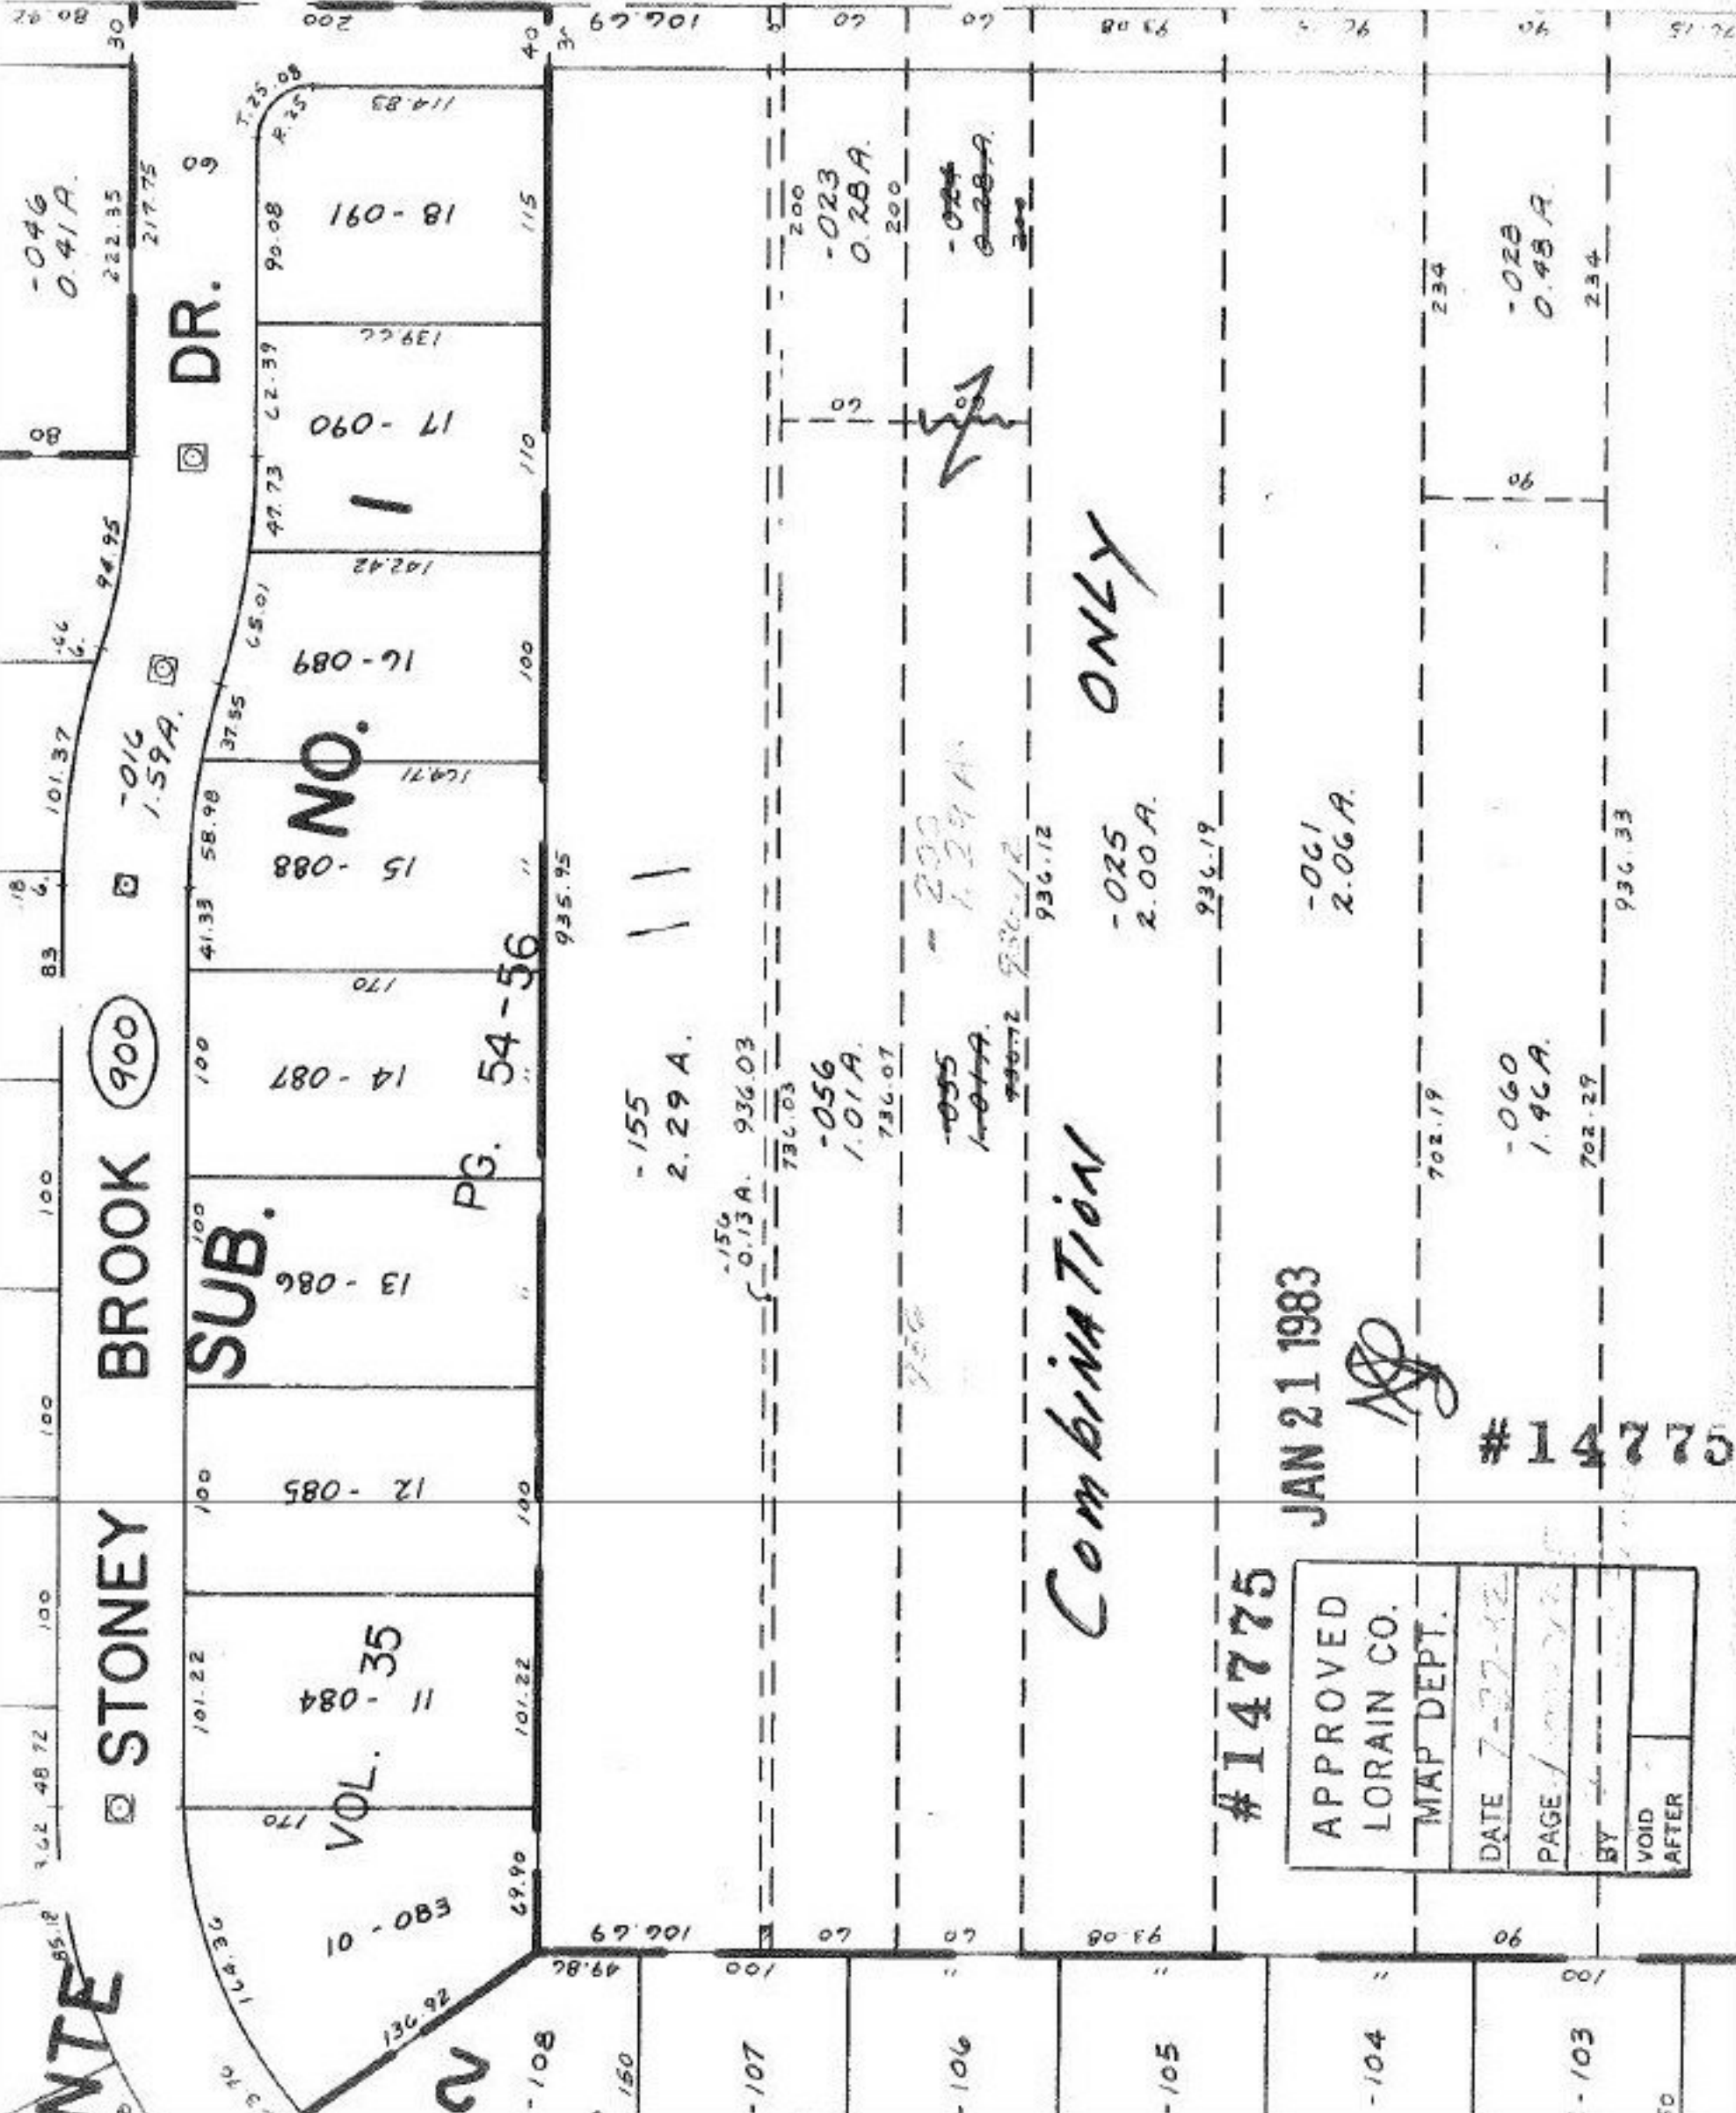

COMBINATION ONLY

JAN 21 1983

APPROVED	
LORAIN CO.	
MAP DEPT.	
DATE	7-27-82
PAGE	100/200
BY	
VOID AFTER	

#14775