


COMBINATION ONLY

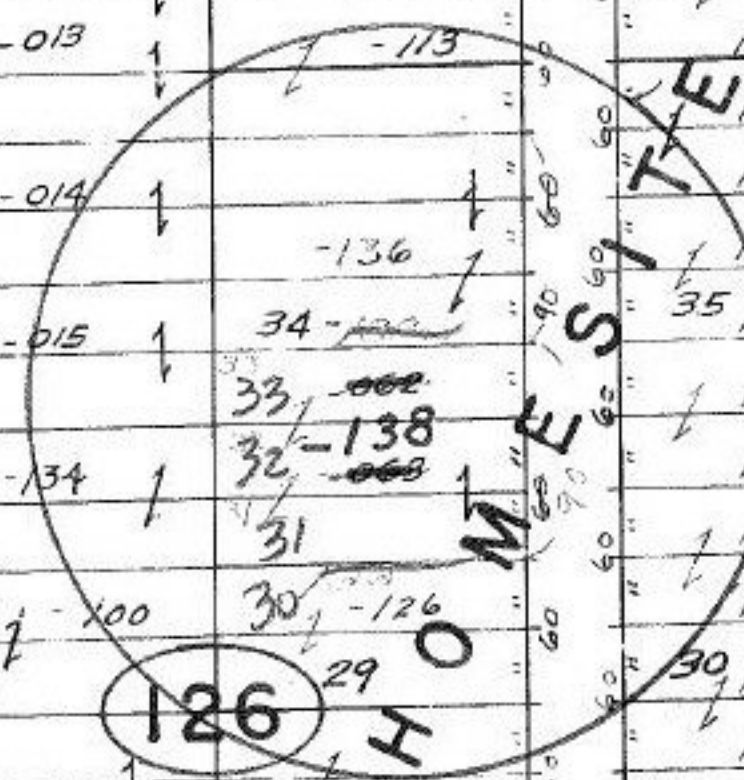

123

126

128

FEB 4 1983

#14777

APPROVED  
LORAIN CO.  
MAP DEPT.

DATE 7-28-82

PAGE 7-00-017-0

BY C. FRANCIS

VOID  
AFTER