


Combination Only

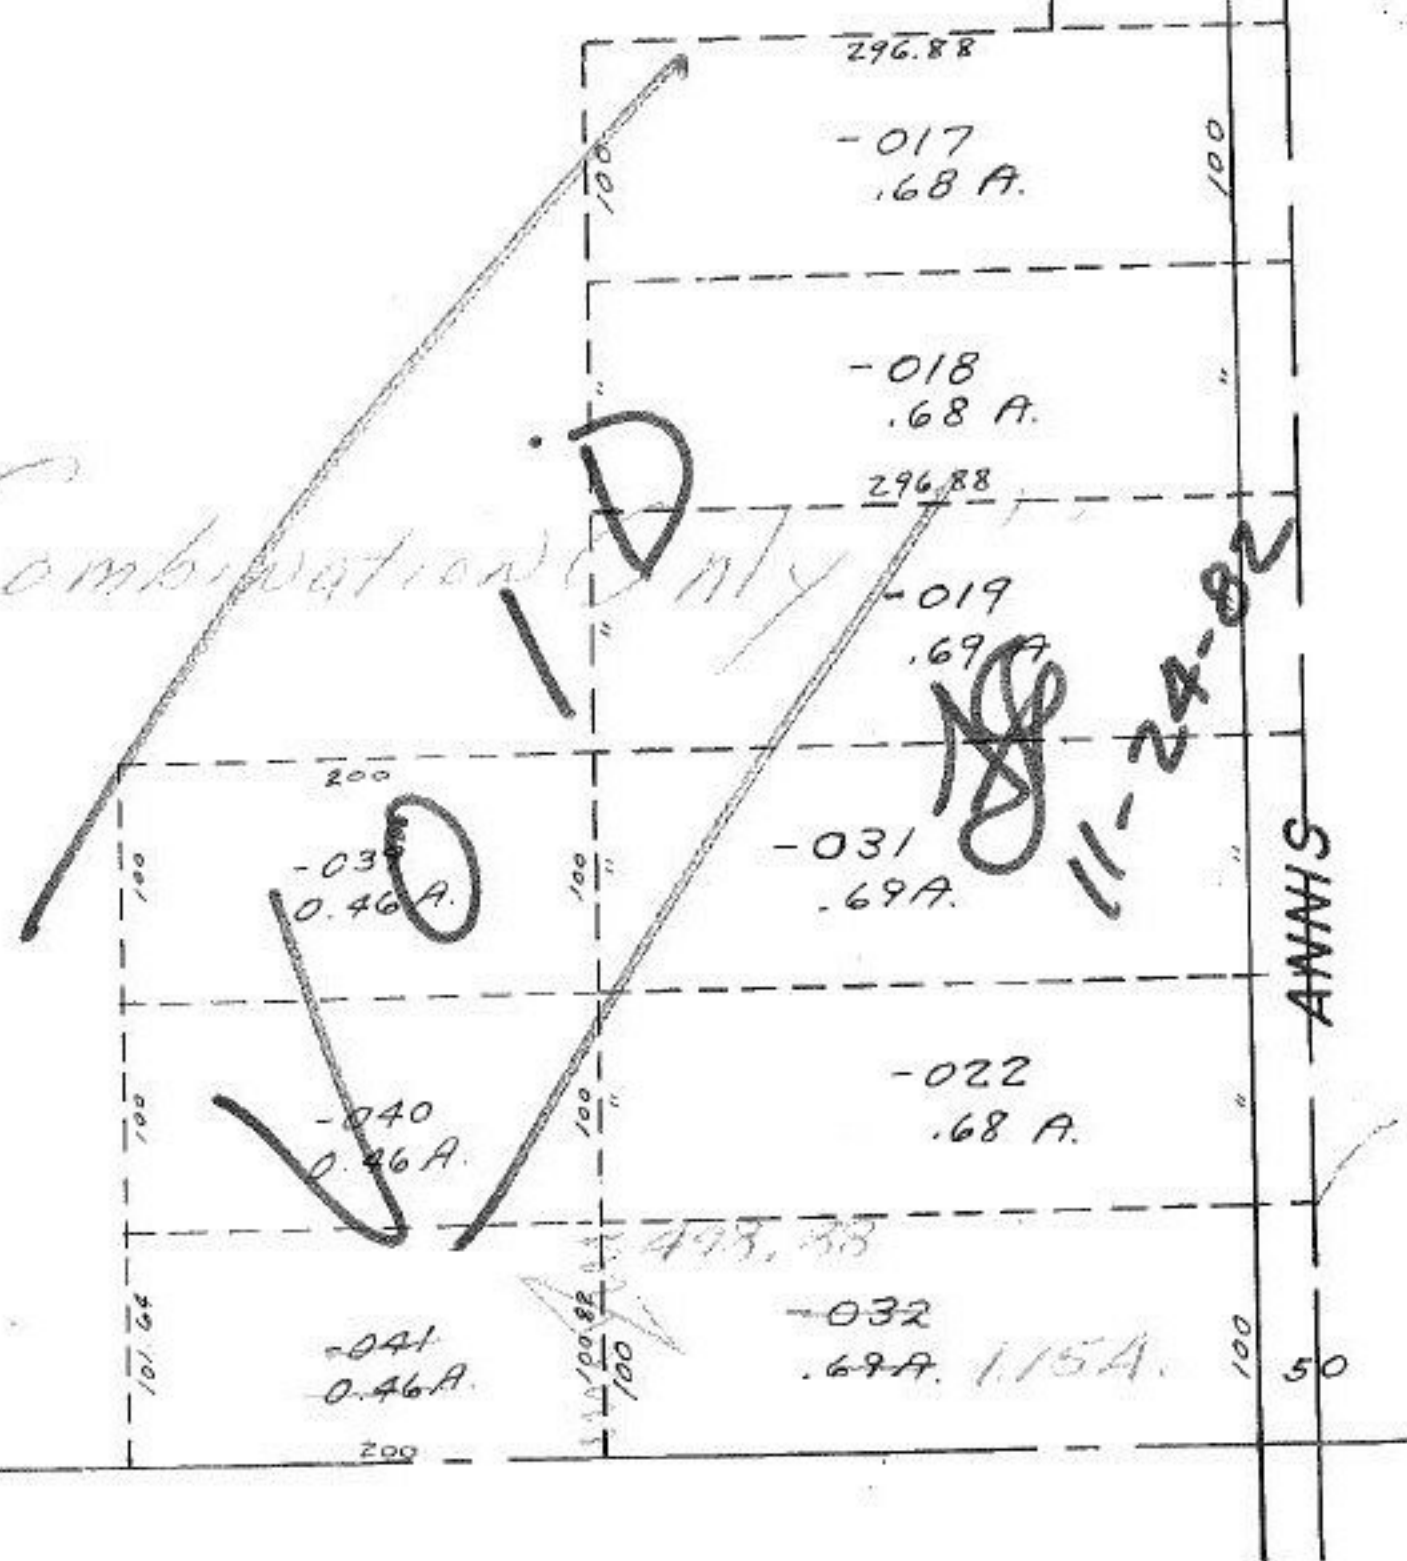

W. 1/2 LOT 4

#14778

APPROVED LORAIN CO. MAP DEPT.	
DATE	3-3-82
PAGE	9.21.224
BY	P. F. ...
VOID AFTER	