


1357.87
1548.31

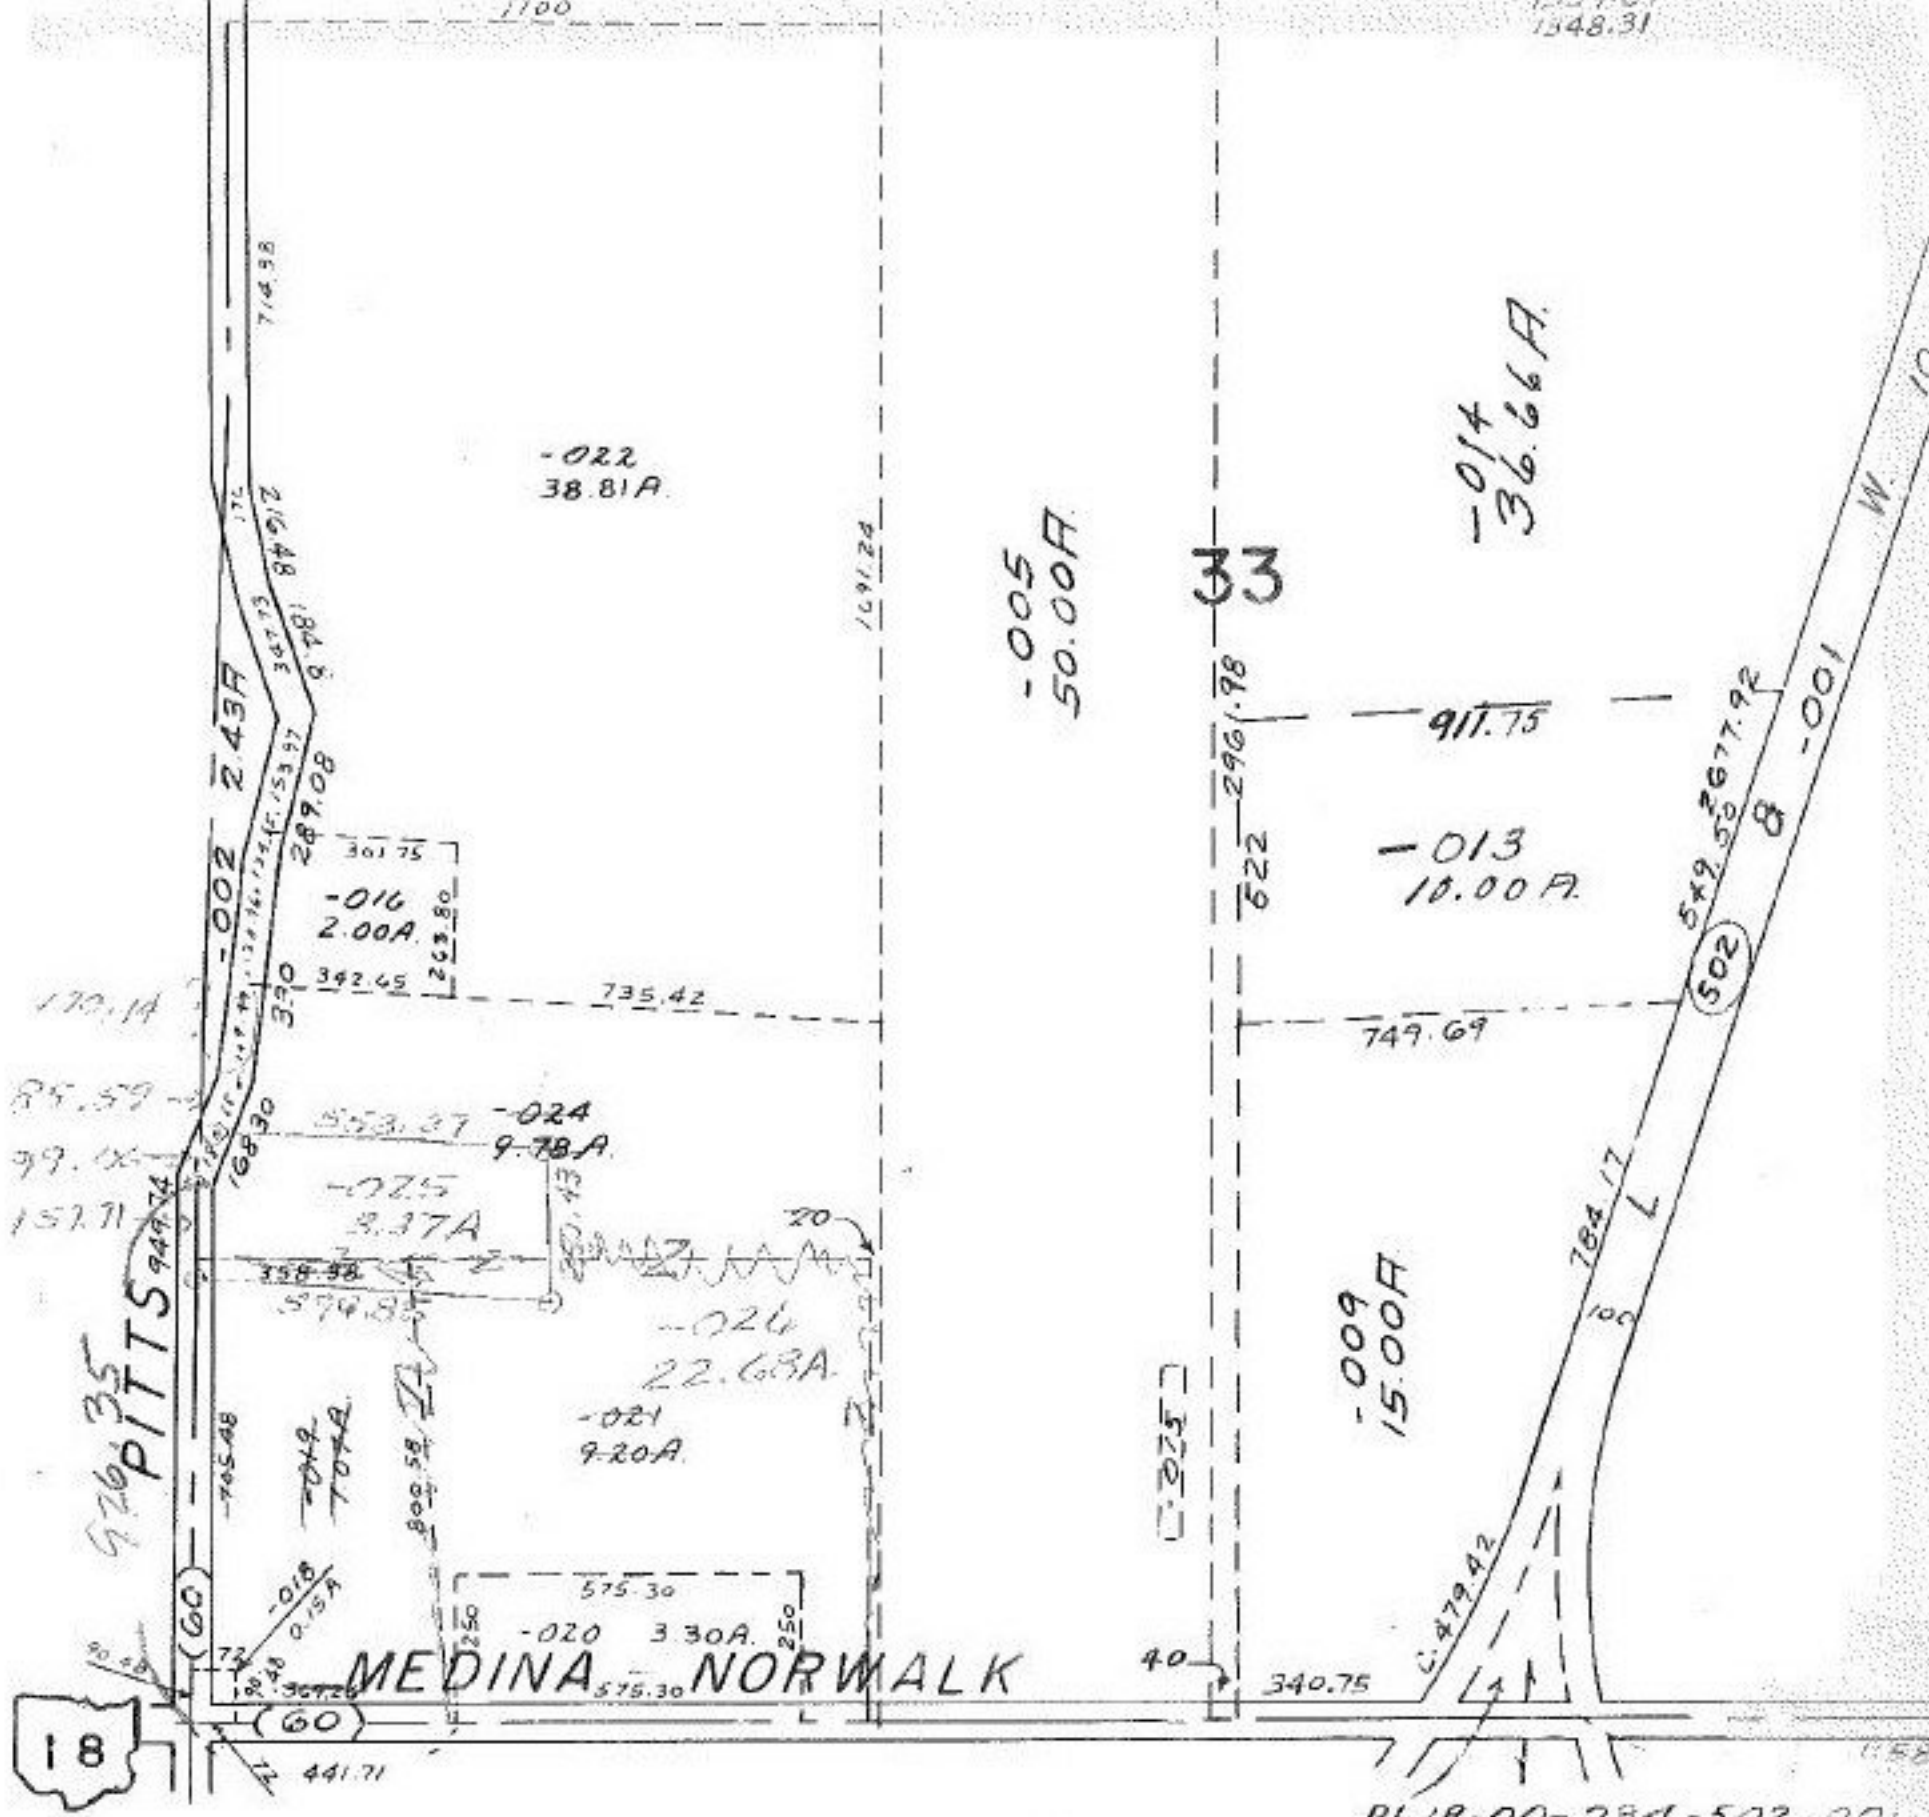

SEE SURVEY R. SIMON

#14800

12-8-82

APPROVED LORAIN CO. MAP DEPT.	
DATE	8-24-82
PAGE	18-B
BY	R. Simon
VOID AFTER	

WELLINGTON TWP.

SCALE: 1" = 400'