
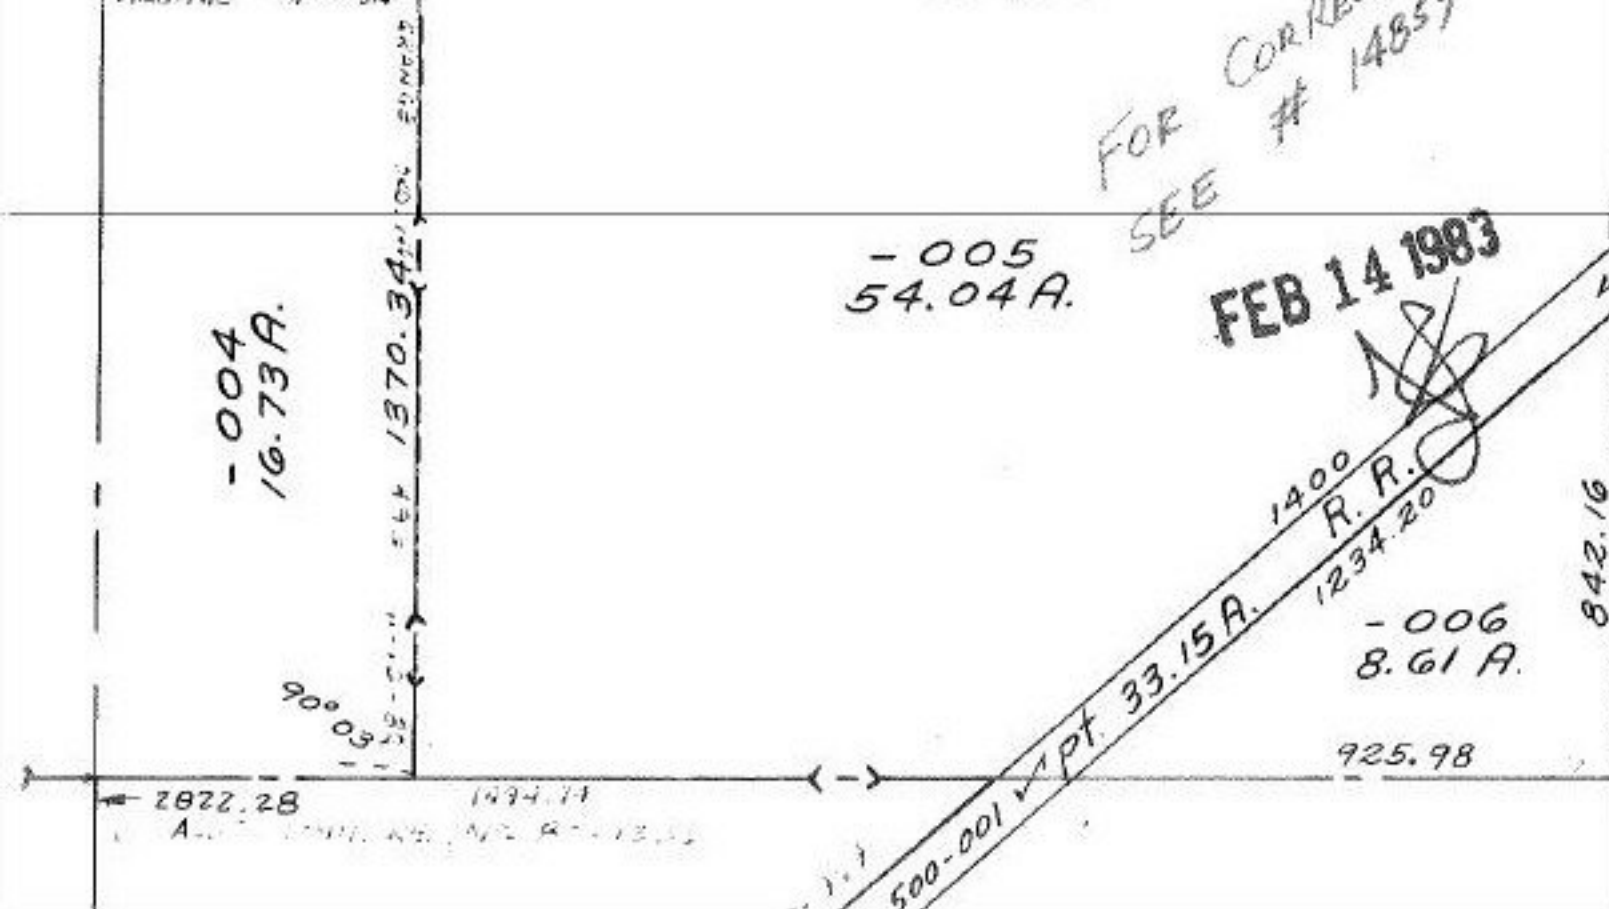
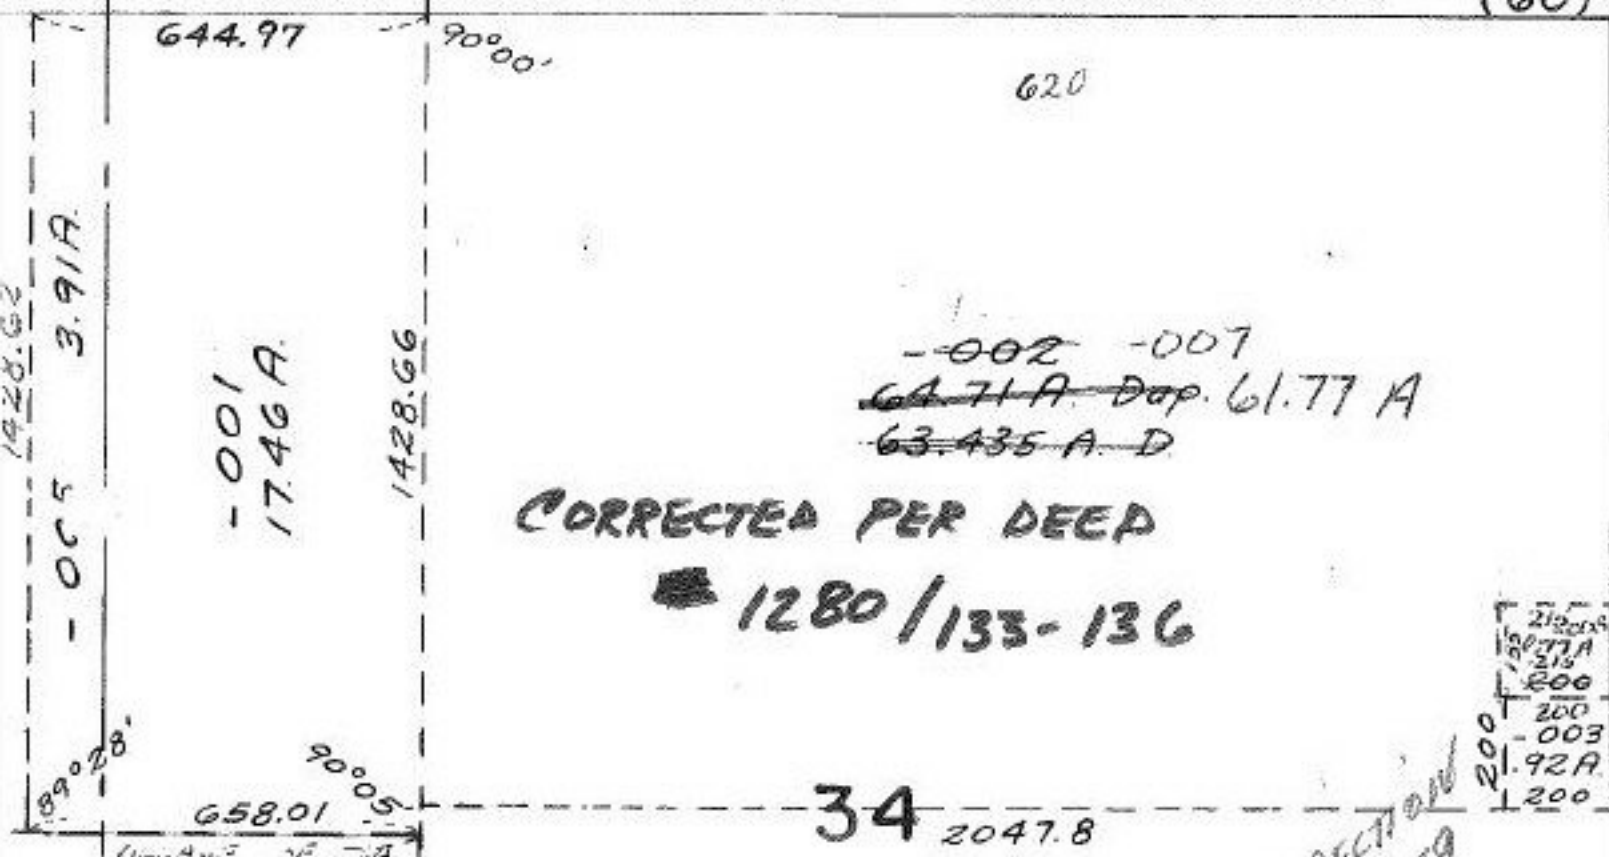


1140.34

1372.73

21

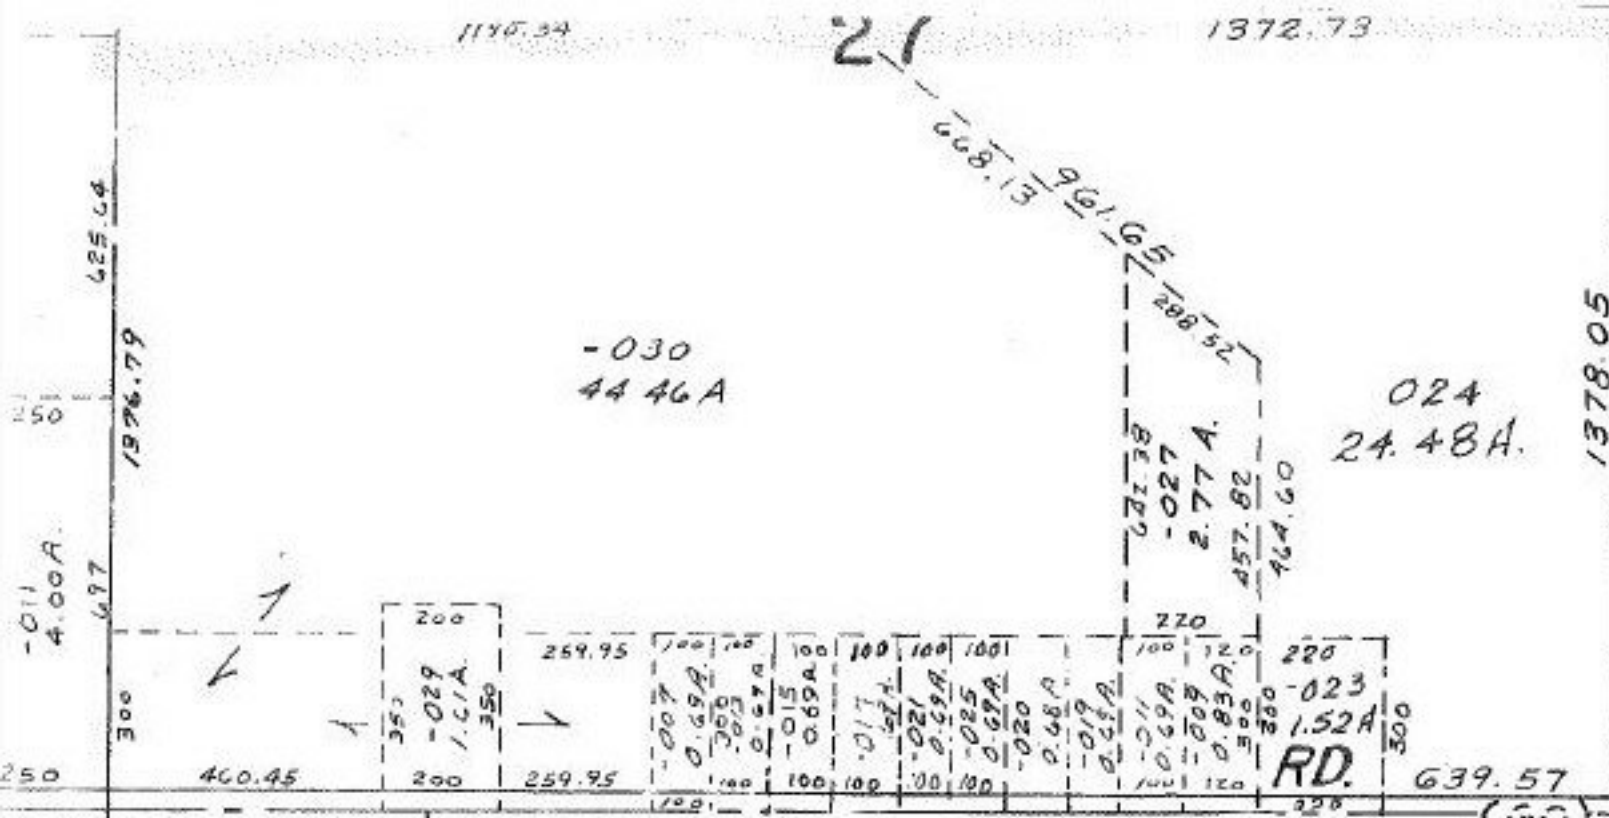

CORRECTED

#14806

APPROVED
LORAIN CO.
MAP DEPT.

DATE 8-24-82

PAGE 15-C

BY Roy Canfield

VOID
AFTER