


VAC. No. 1440-18
ORD.

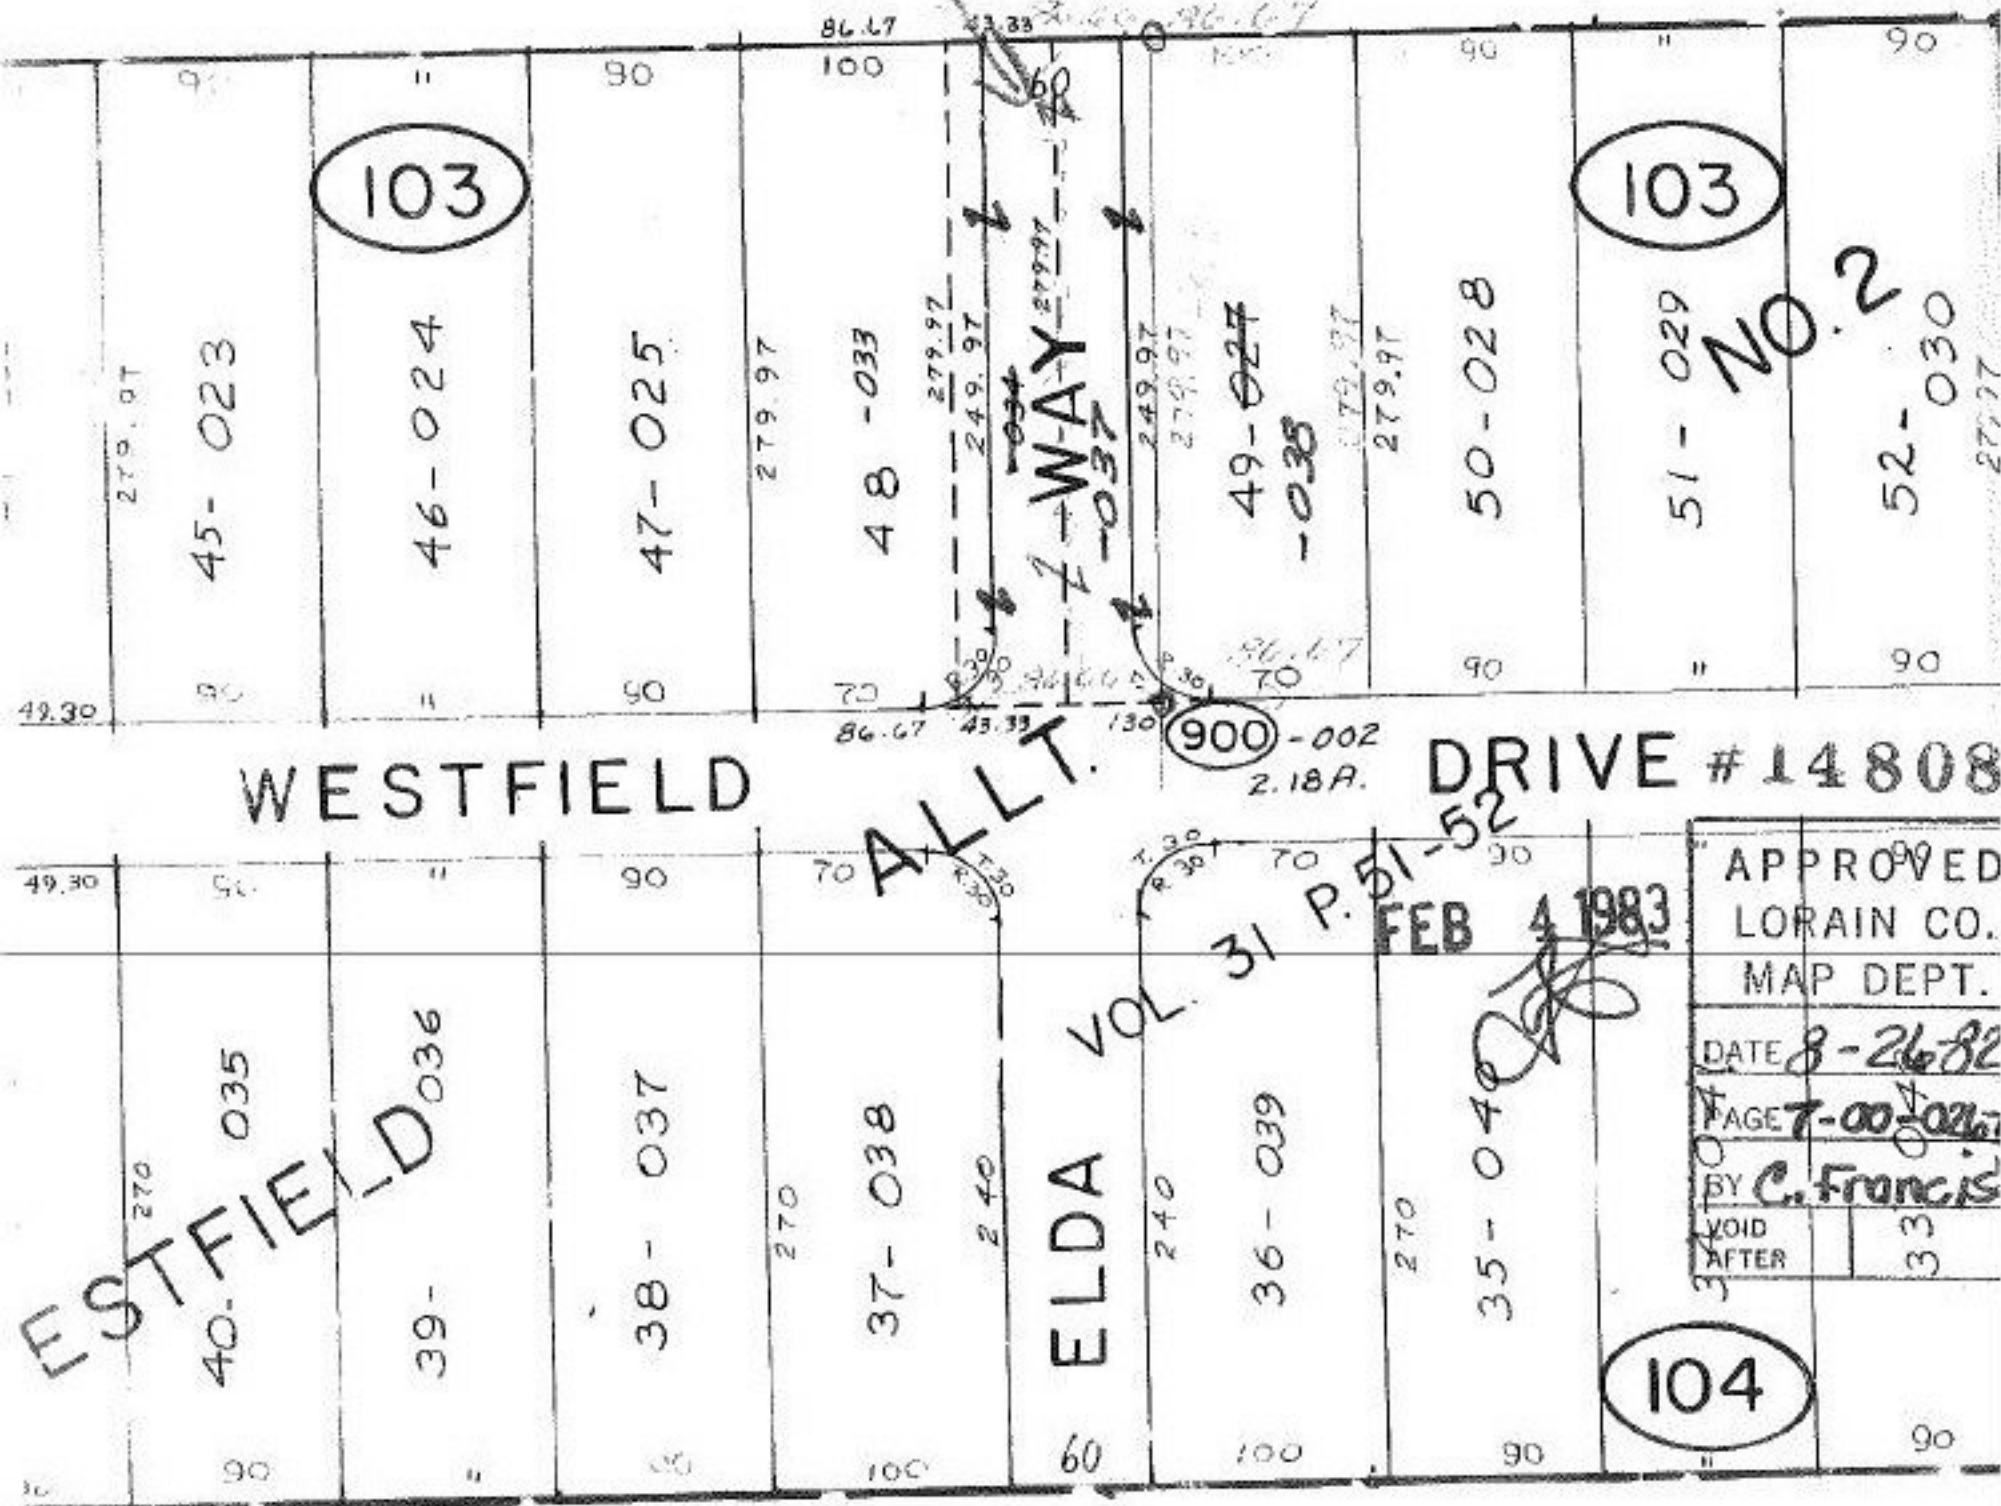

WESTFIELD

ESTFIELD

ALLT.

ELDA

DRIVE # 14808

900-002
2.18A.

FEB 4 1983

APPROVED	99
LORAIN CO.	
MAP DEPT.	
DATE	8-26-82
PAGE	7-00-02
BY	C. Francis
VOID AFTER	33

104