


SEE 7-

3 108 03

234.65  
234.60

140.80 159.49 159.48

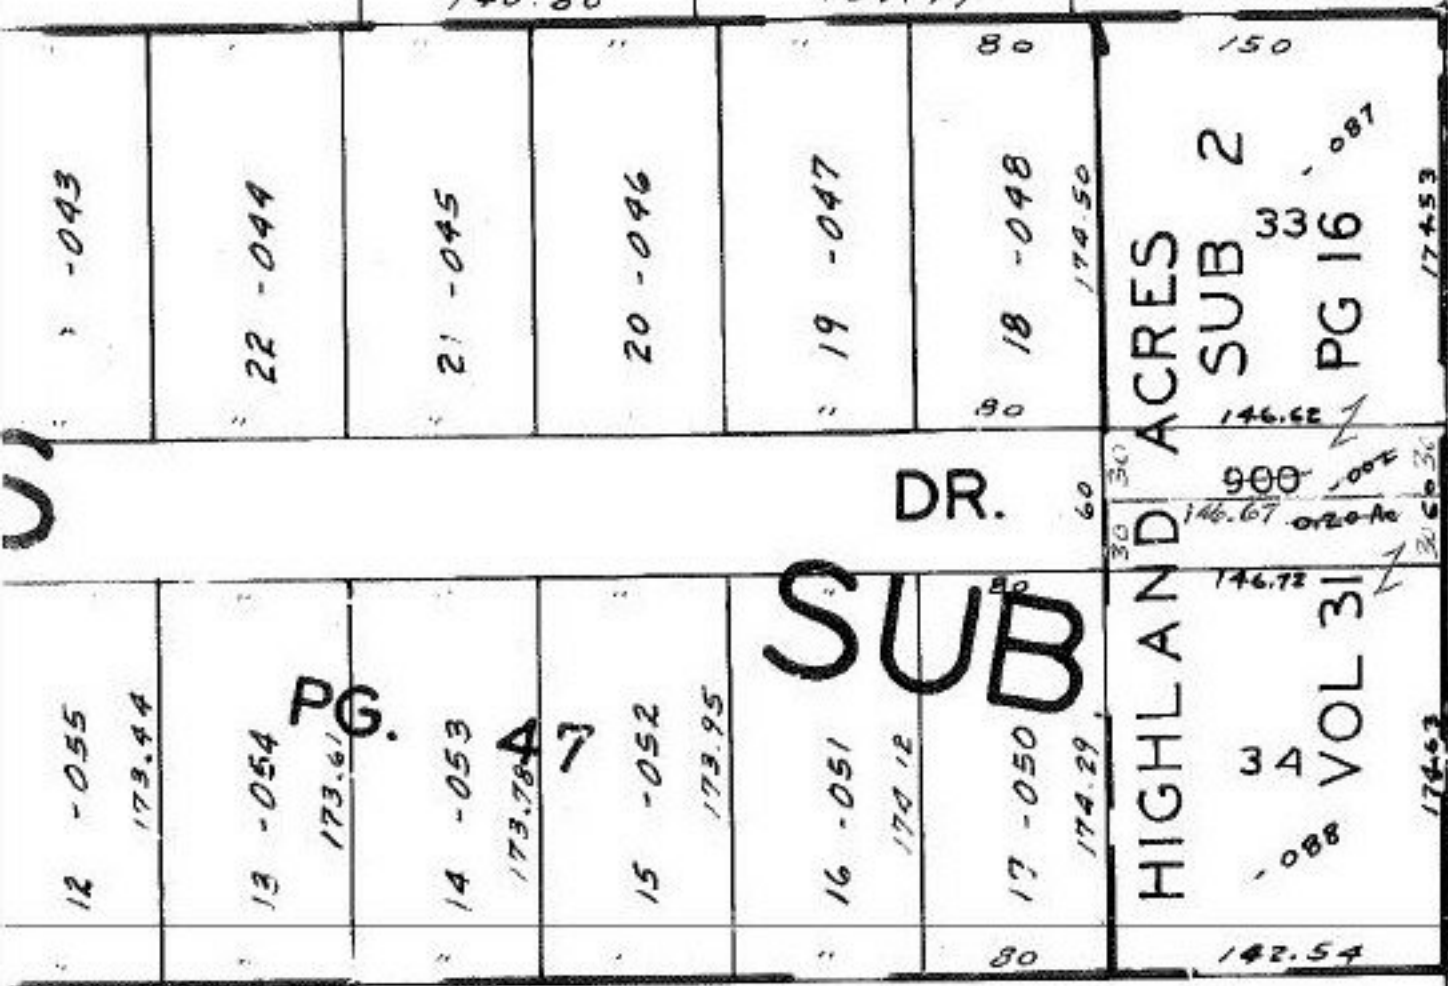

VACATION  
ORD. NO.  
1838-83

#14812

APPROVED  
LORAIN CO.  
MAP DEPT.

DATE 9-30-83

PAGE 700-018-A

BY T.M. Hair

VOID  
IF  
6-14-85

F. Hollis  
6-18-85

TWP