


VACATION
ORD. NO.
1837-83

SEE 7-00-007-A

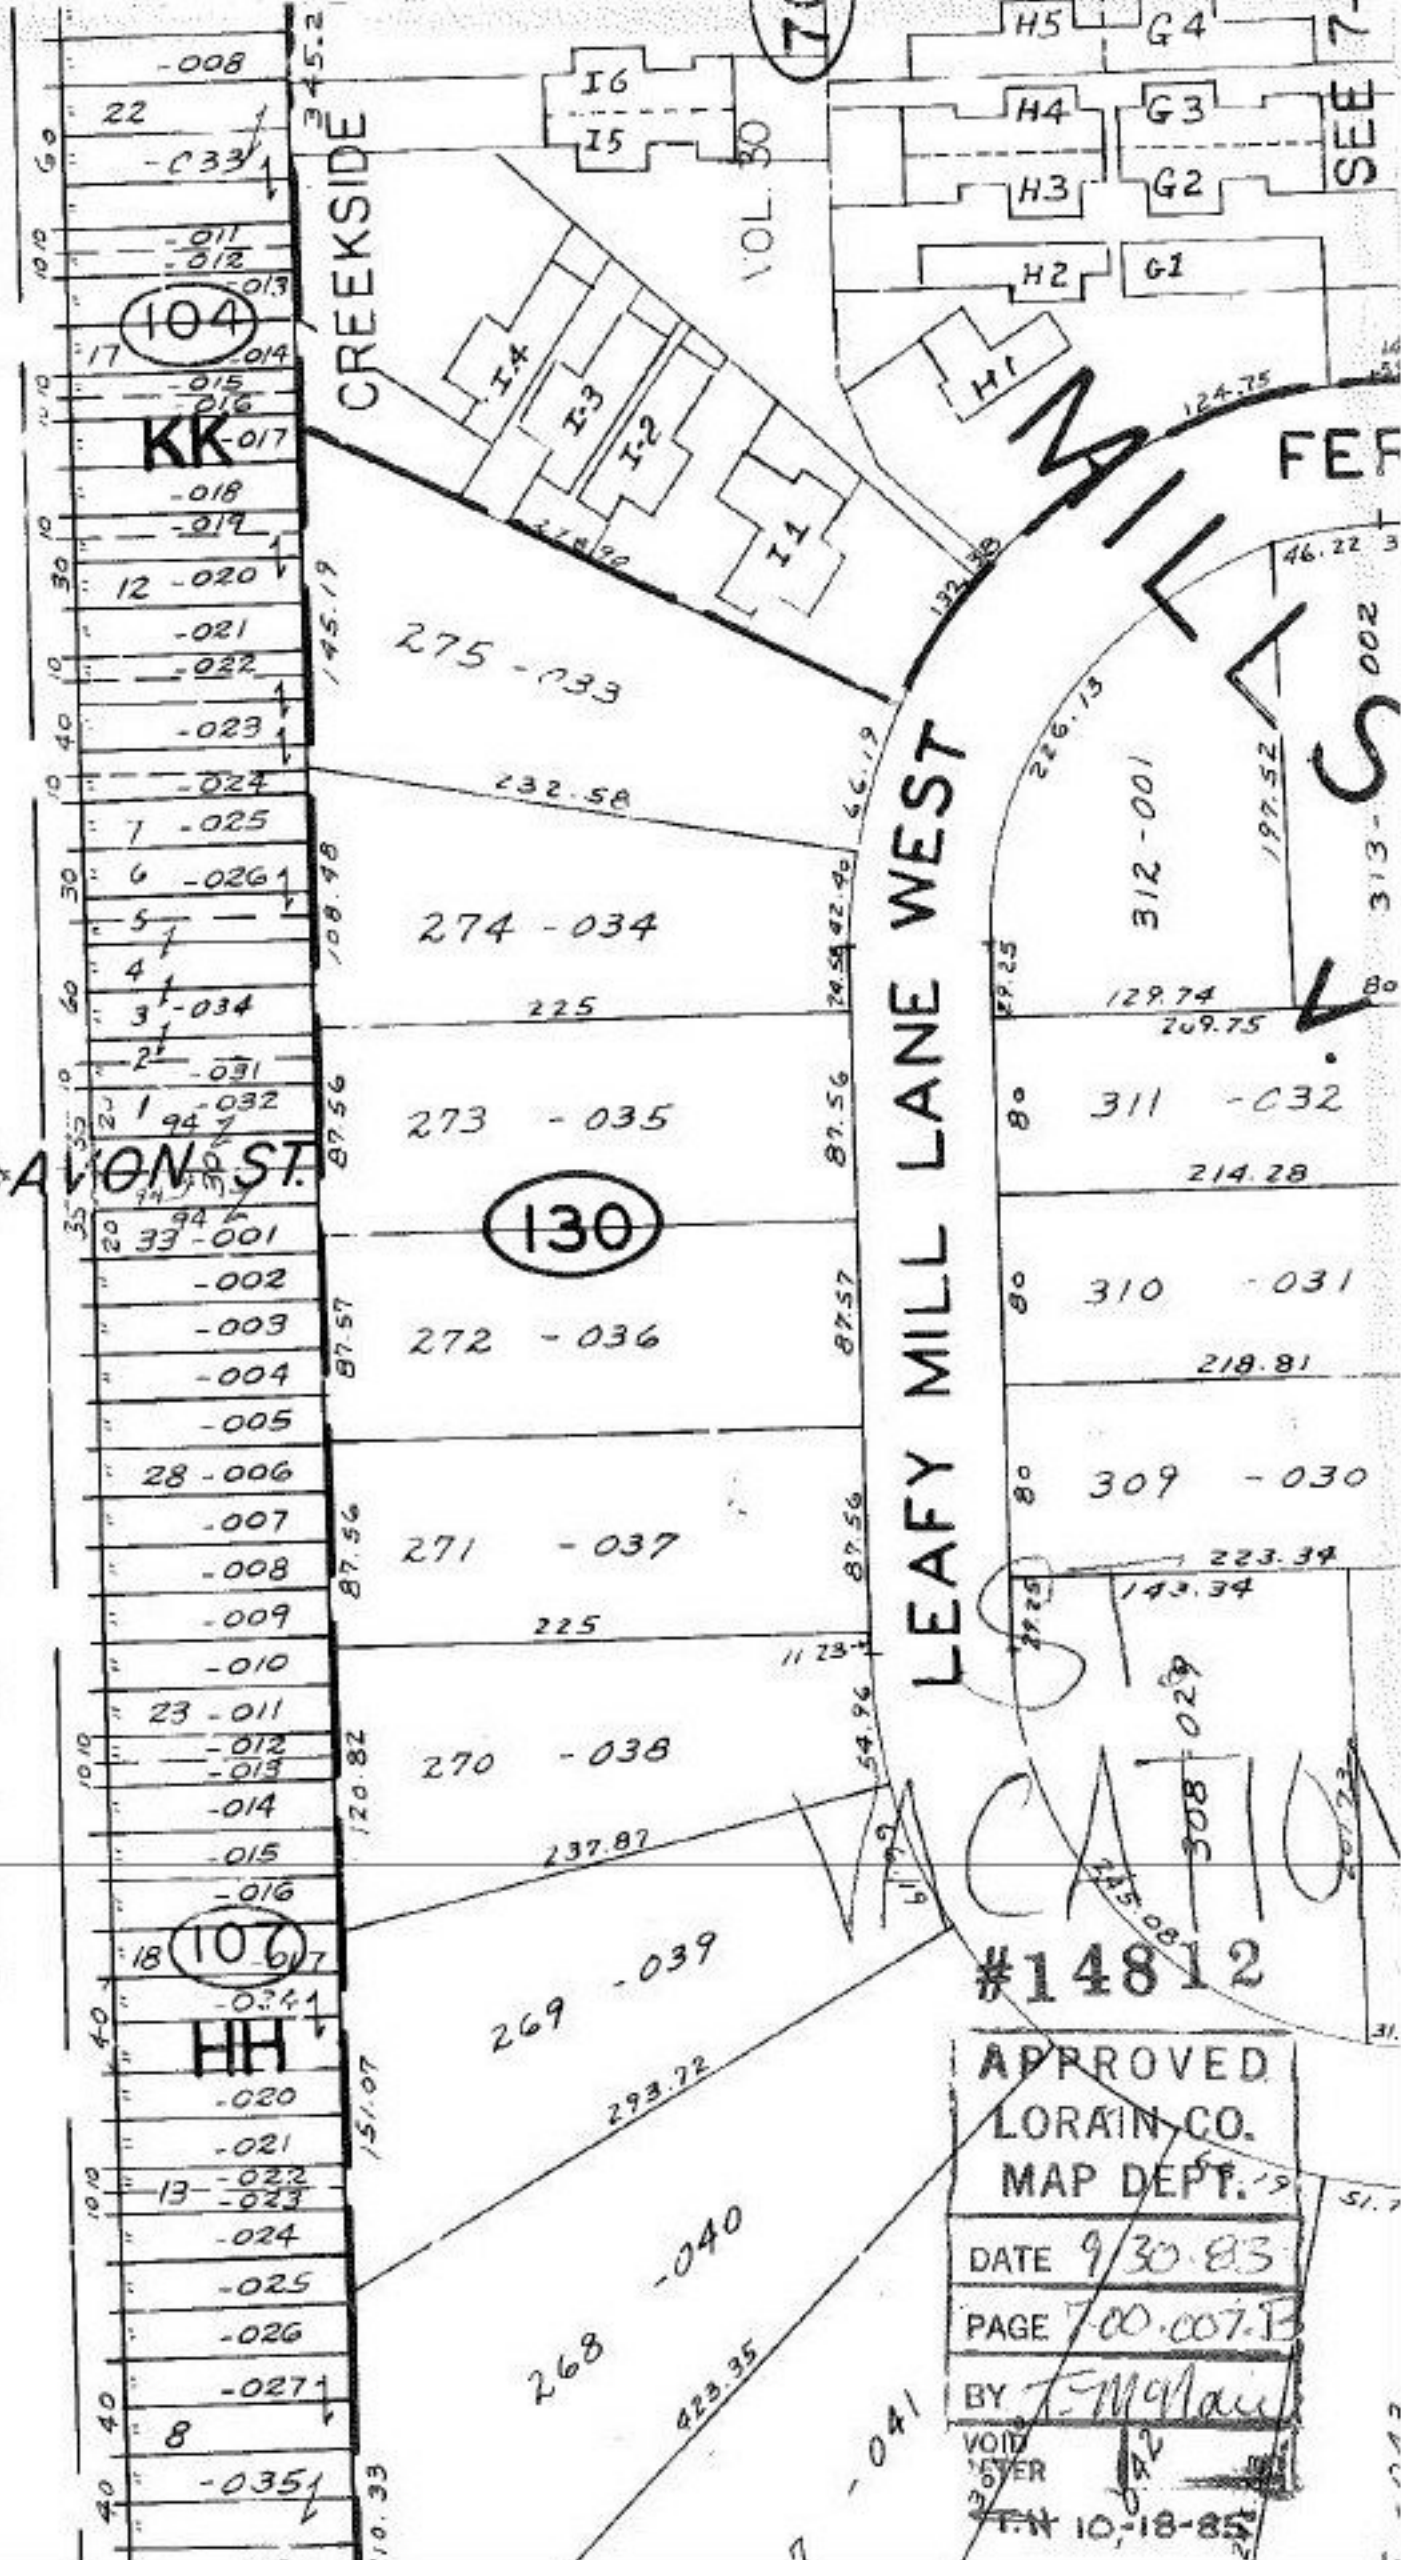

#14812

APPROVED
LORAIN CO.
MAP DEPT.

DATE 9/30/83

PAGE 7-00-007-B

BY T. McManis

VOID
IF EVER

FN 10-18-85