


093
9.94 A.

SEE SURVEY MAP
A.D. JEANCOLA

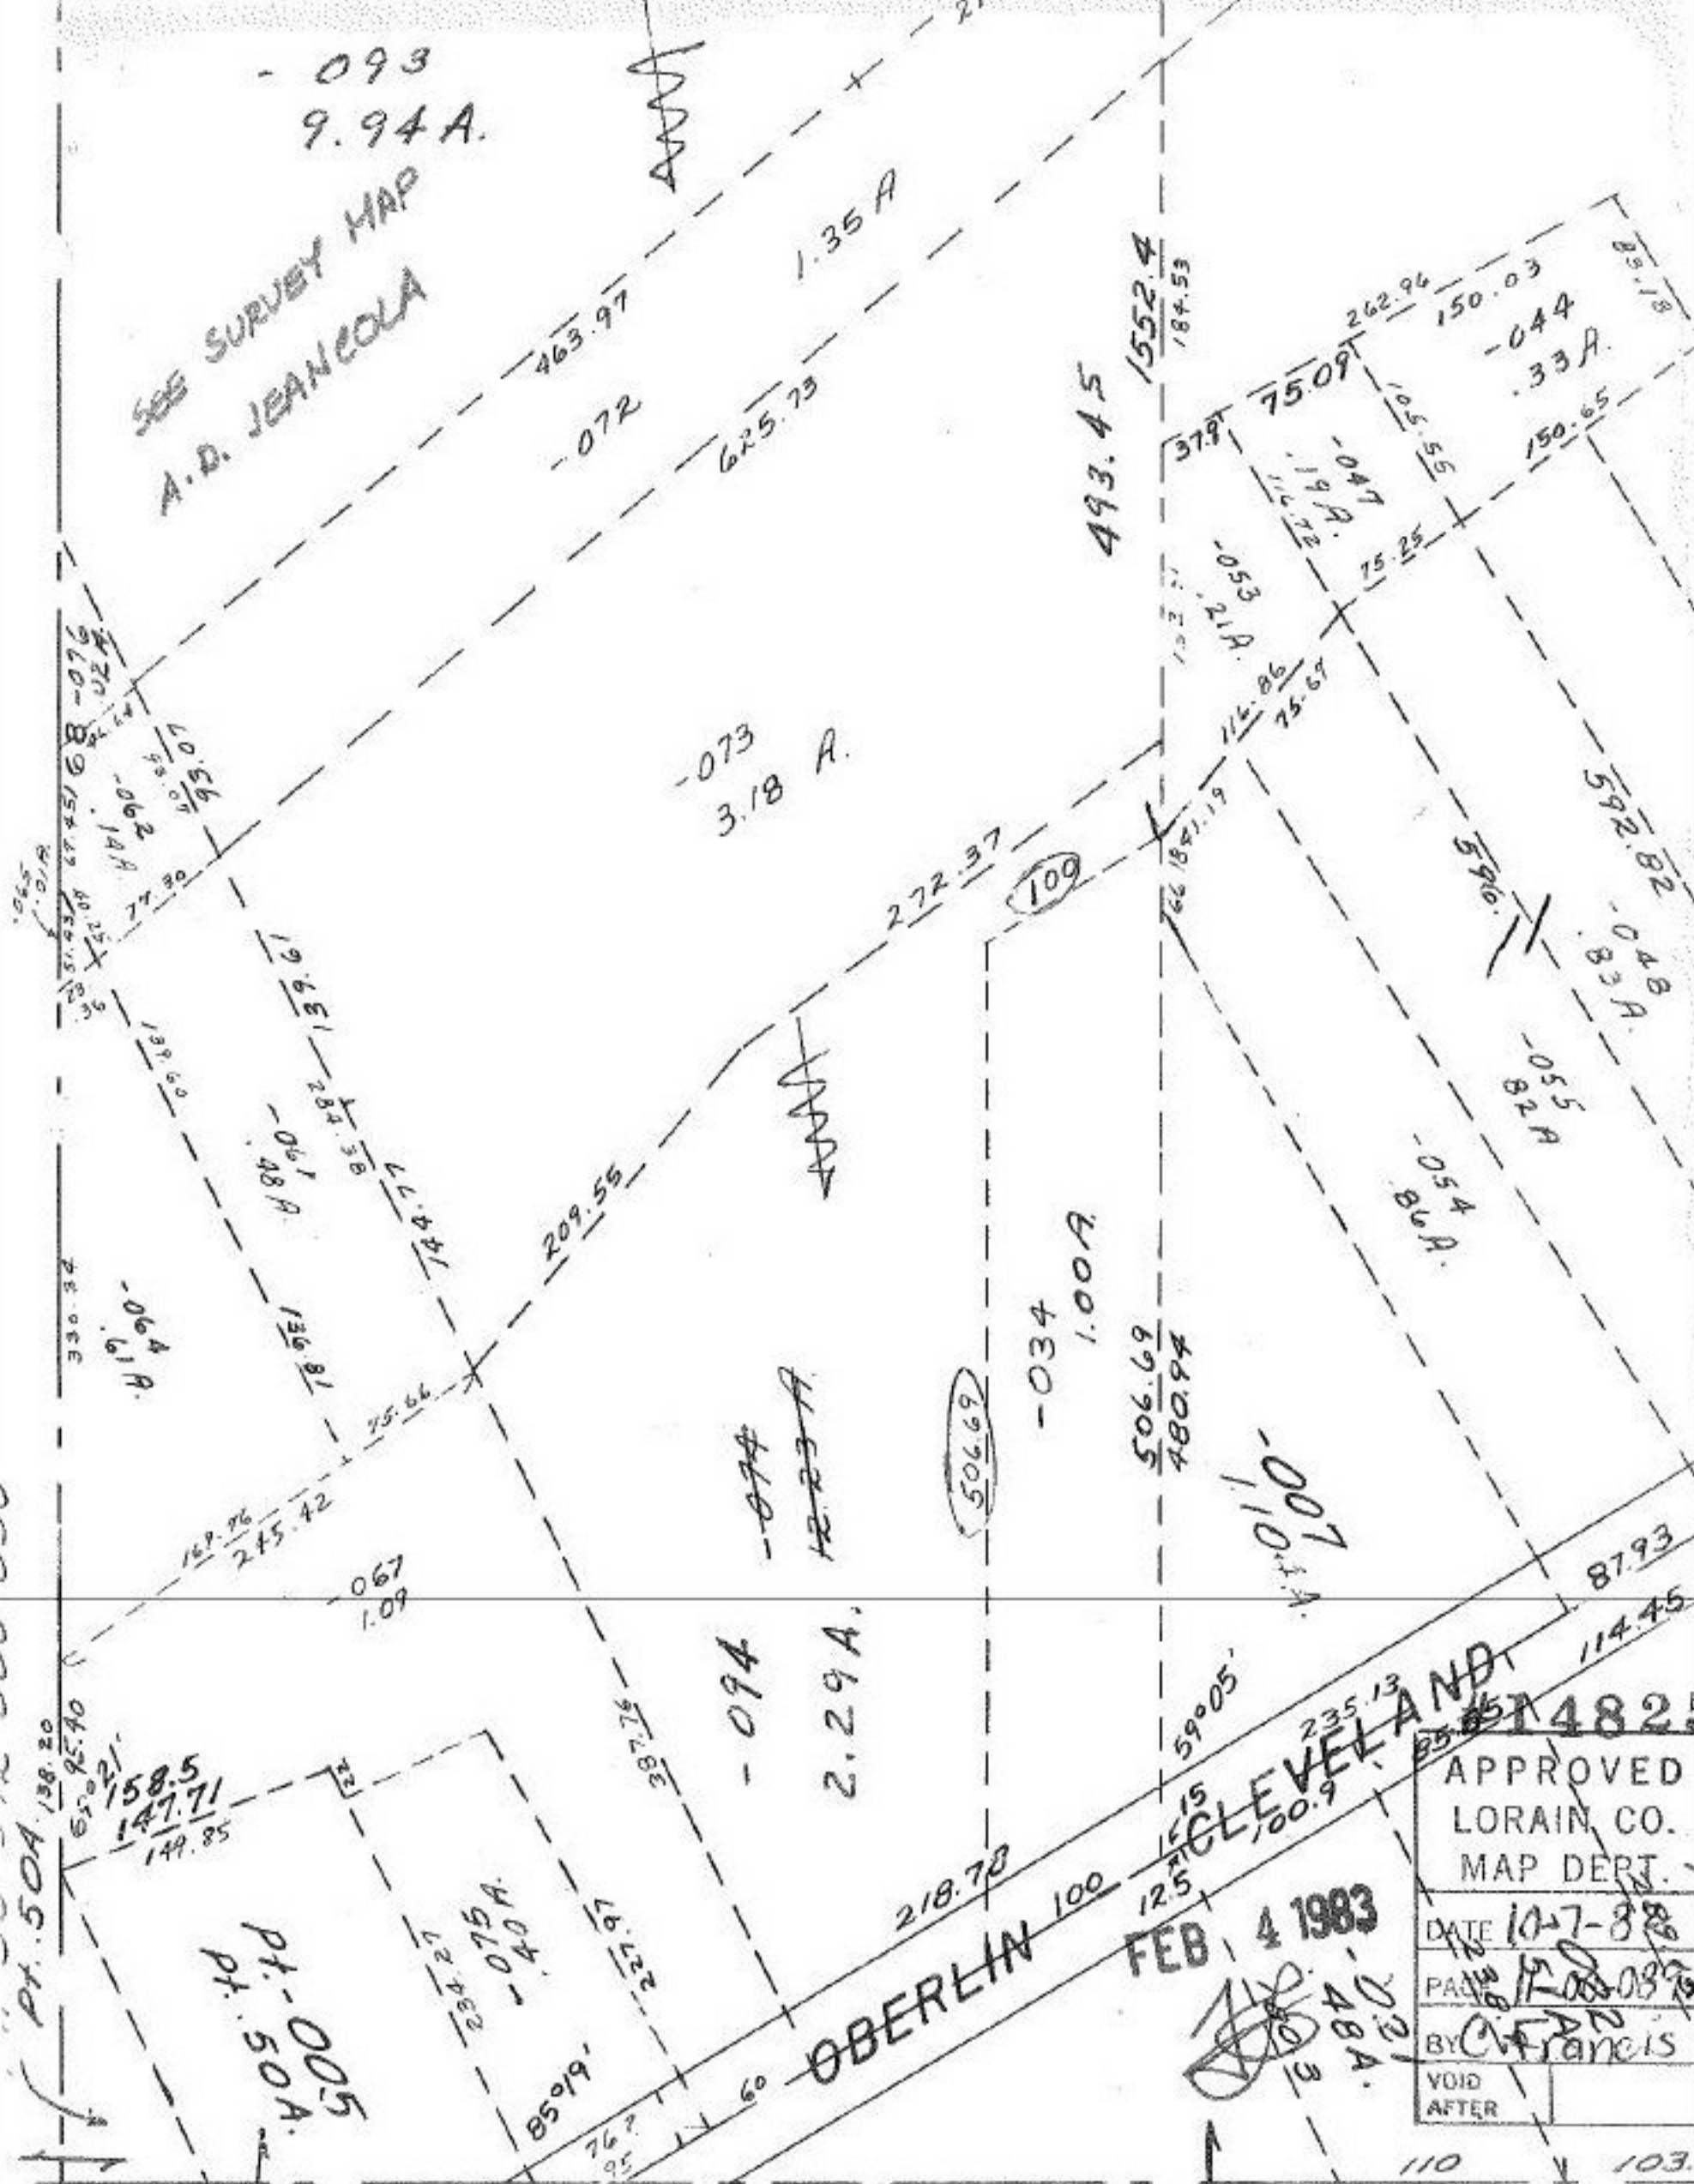

APPROVED
LORAIN CO.
MAP DEPT.

DATE 10-7-88

PAID BY [Signature]

BY [Signature]

VOID AFTER

110 103

FEB 4 1983

CLEVELAND 1482

OBERLIN 100

PT. 50A
PT. 50A
PT. 50A