

#14826

APPROVED
LORAIN CO.
MAP DEPT.


DATE 9-22-82

PAGE 3-00-037-A

BY T. McNeil

1-14-83

[Handwritten signature]

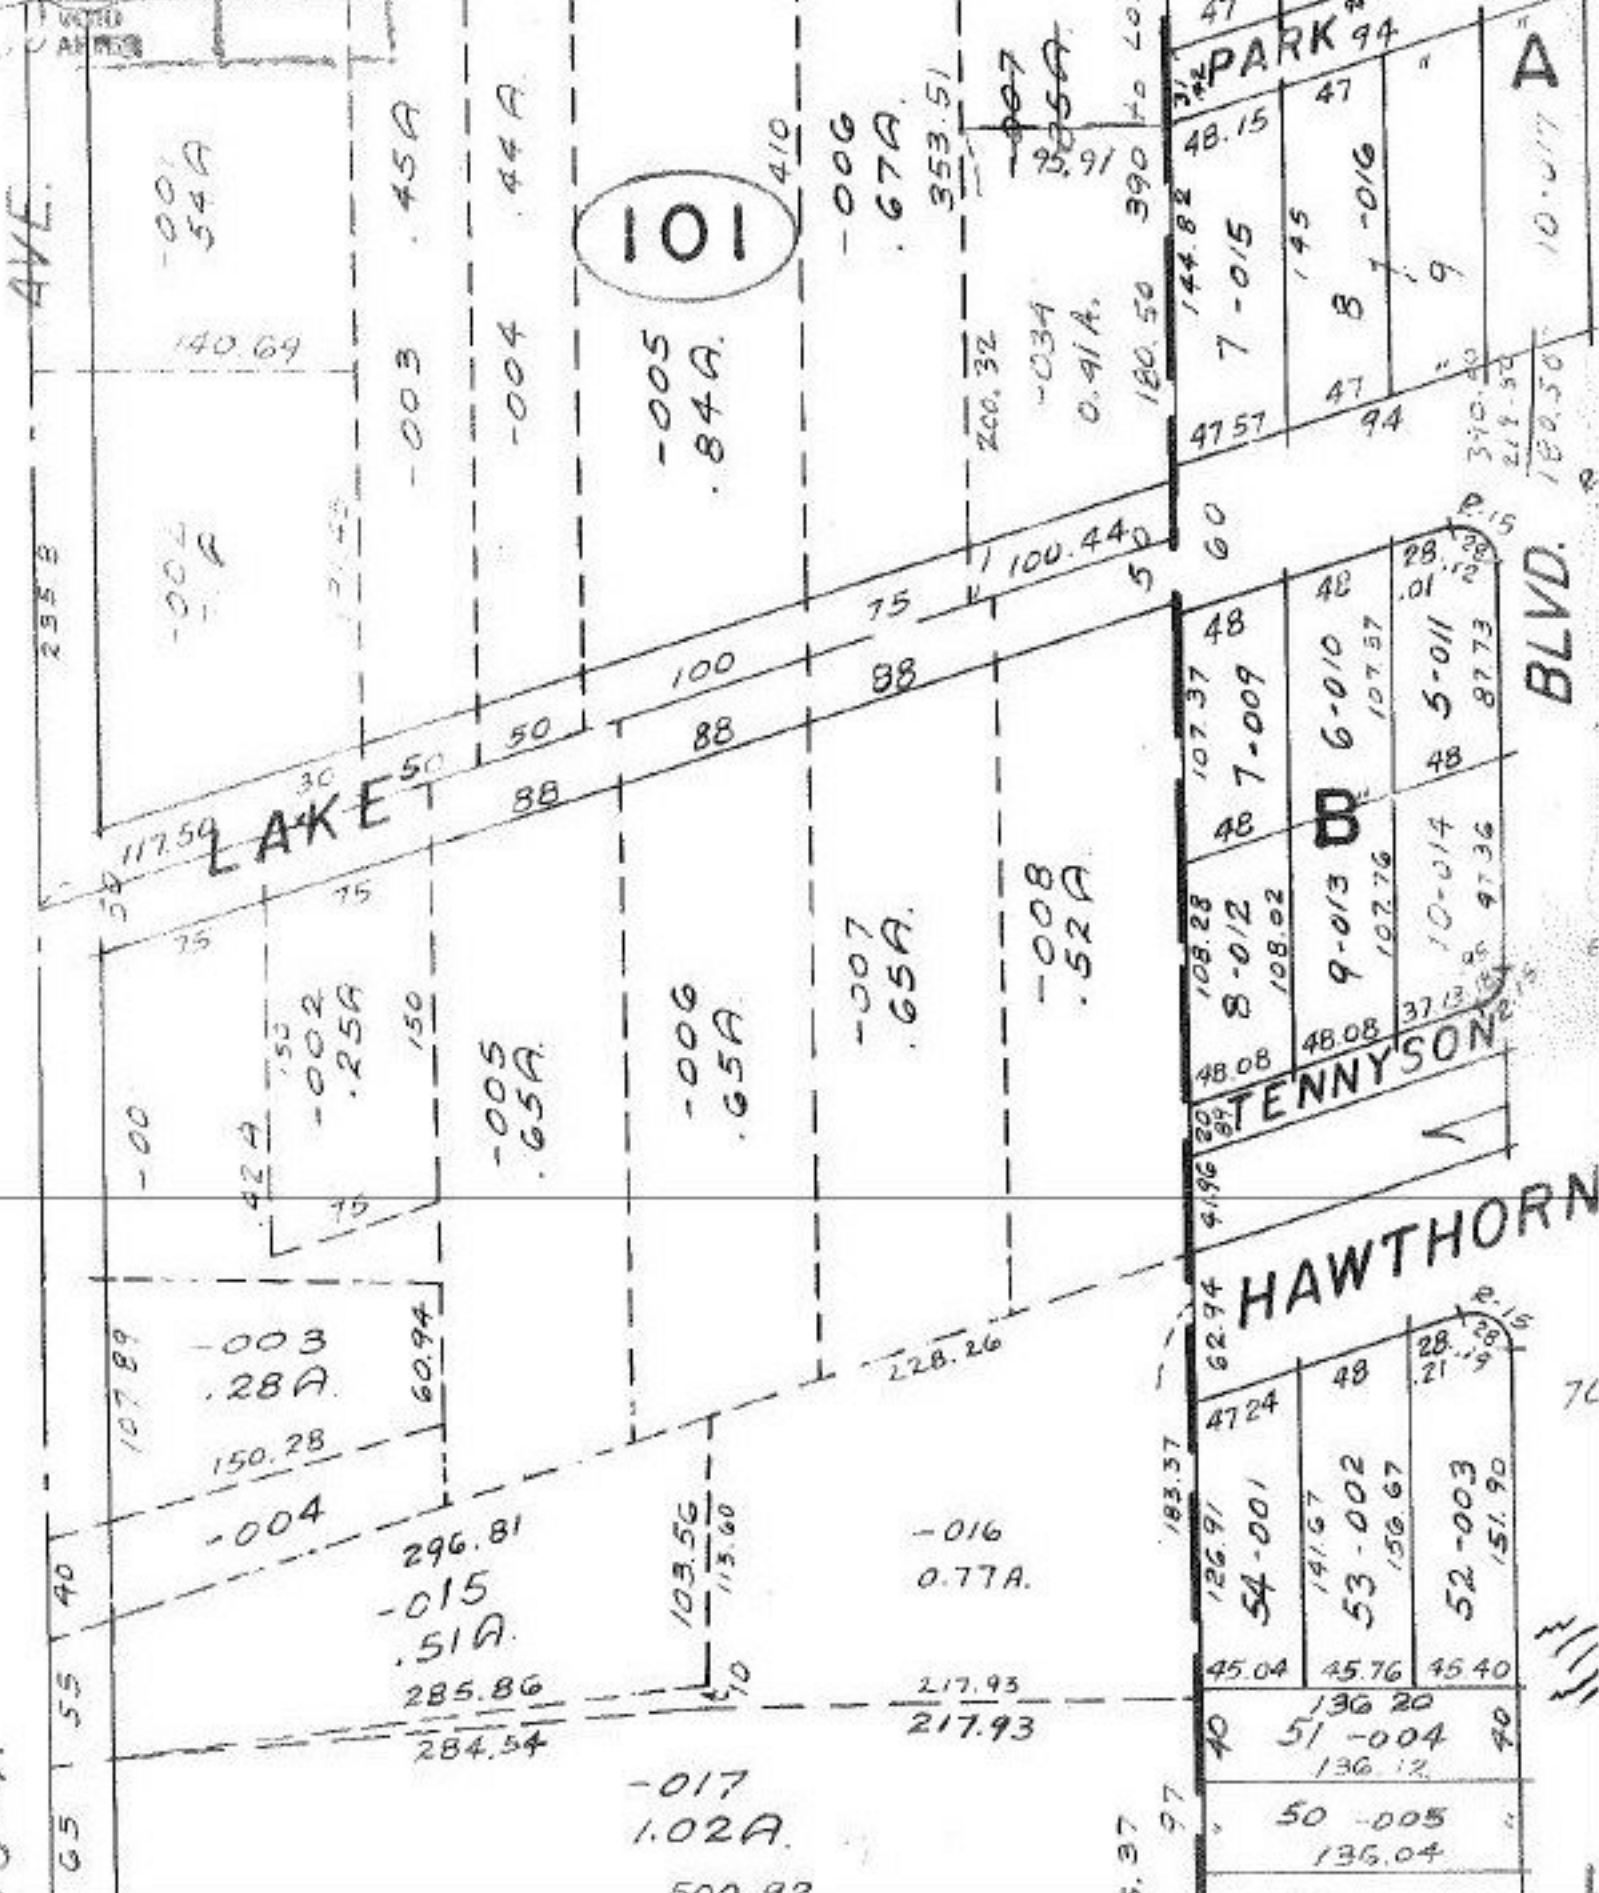

85
71

38-A

70

71