


SEE 2-01-003-N

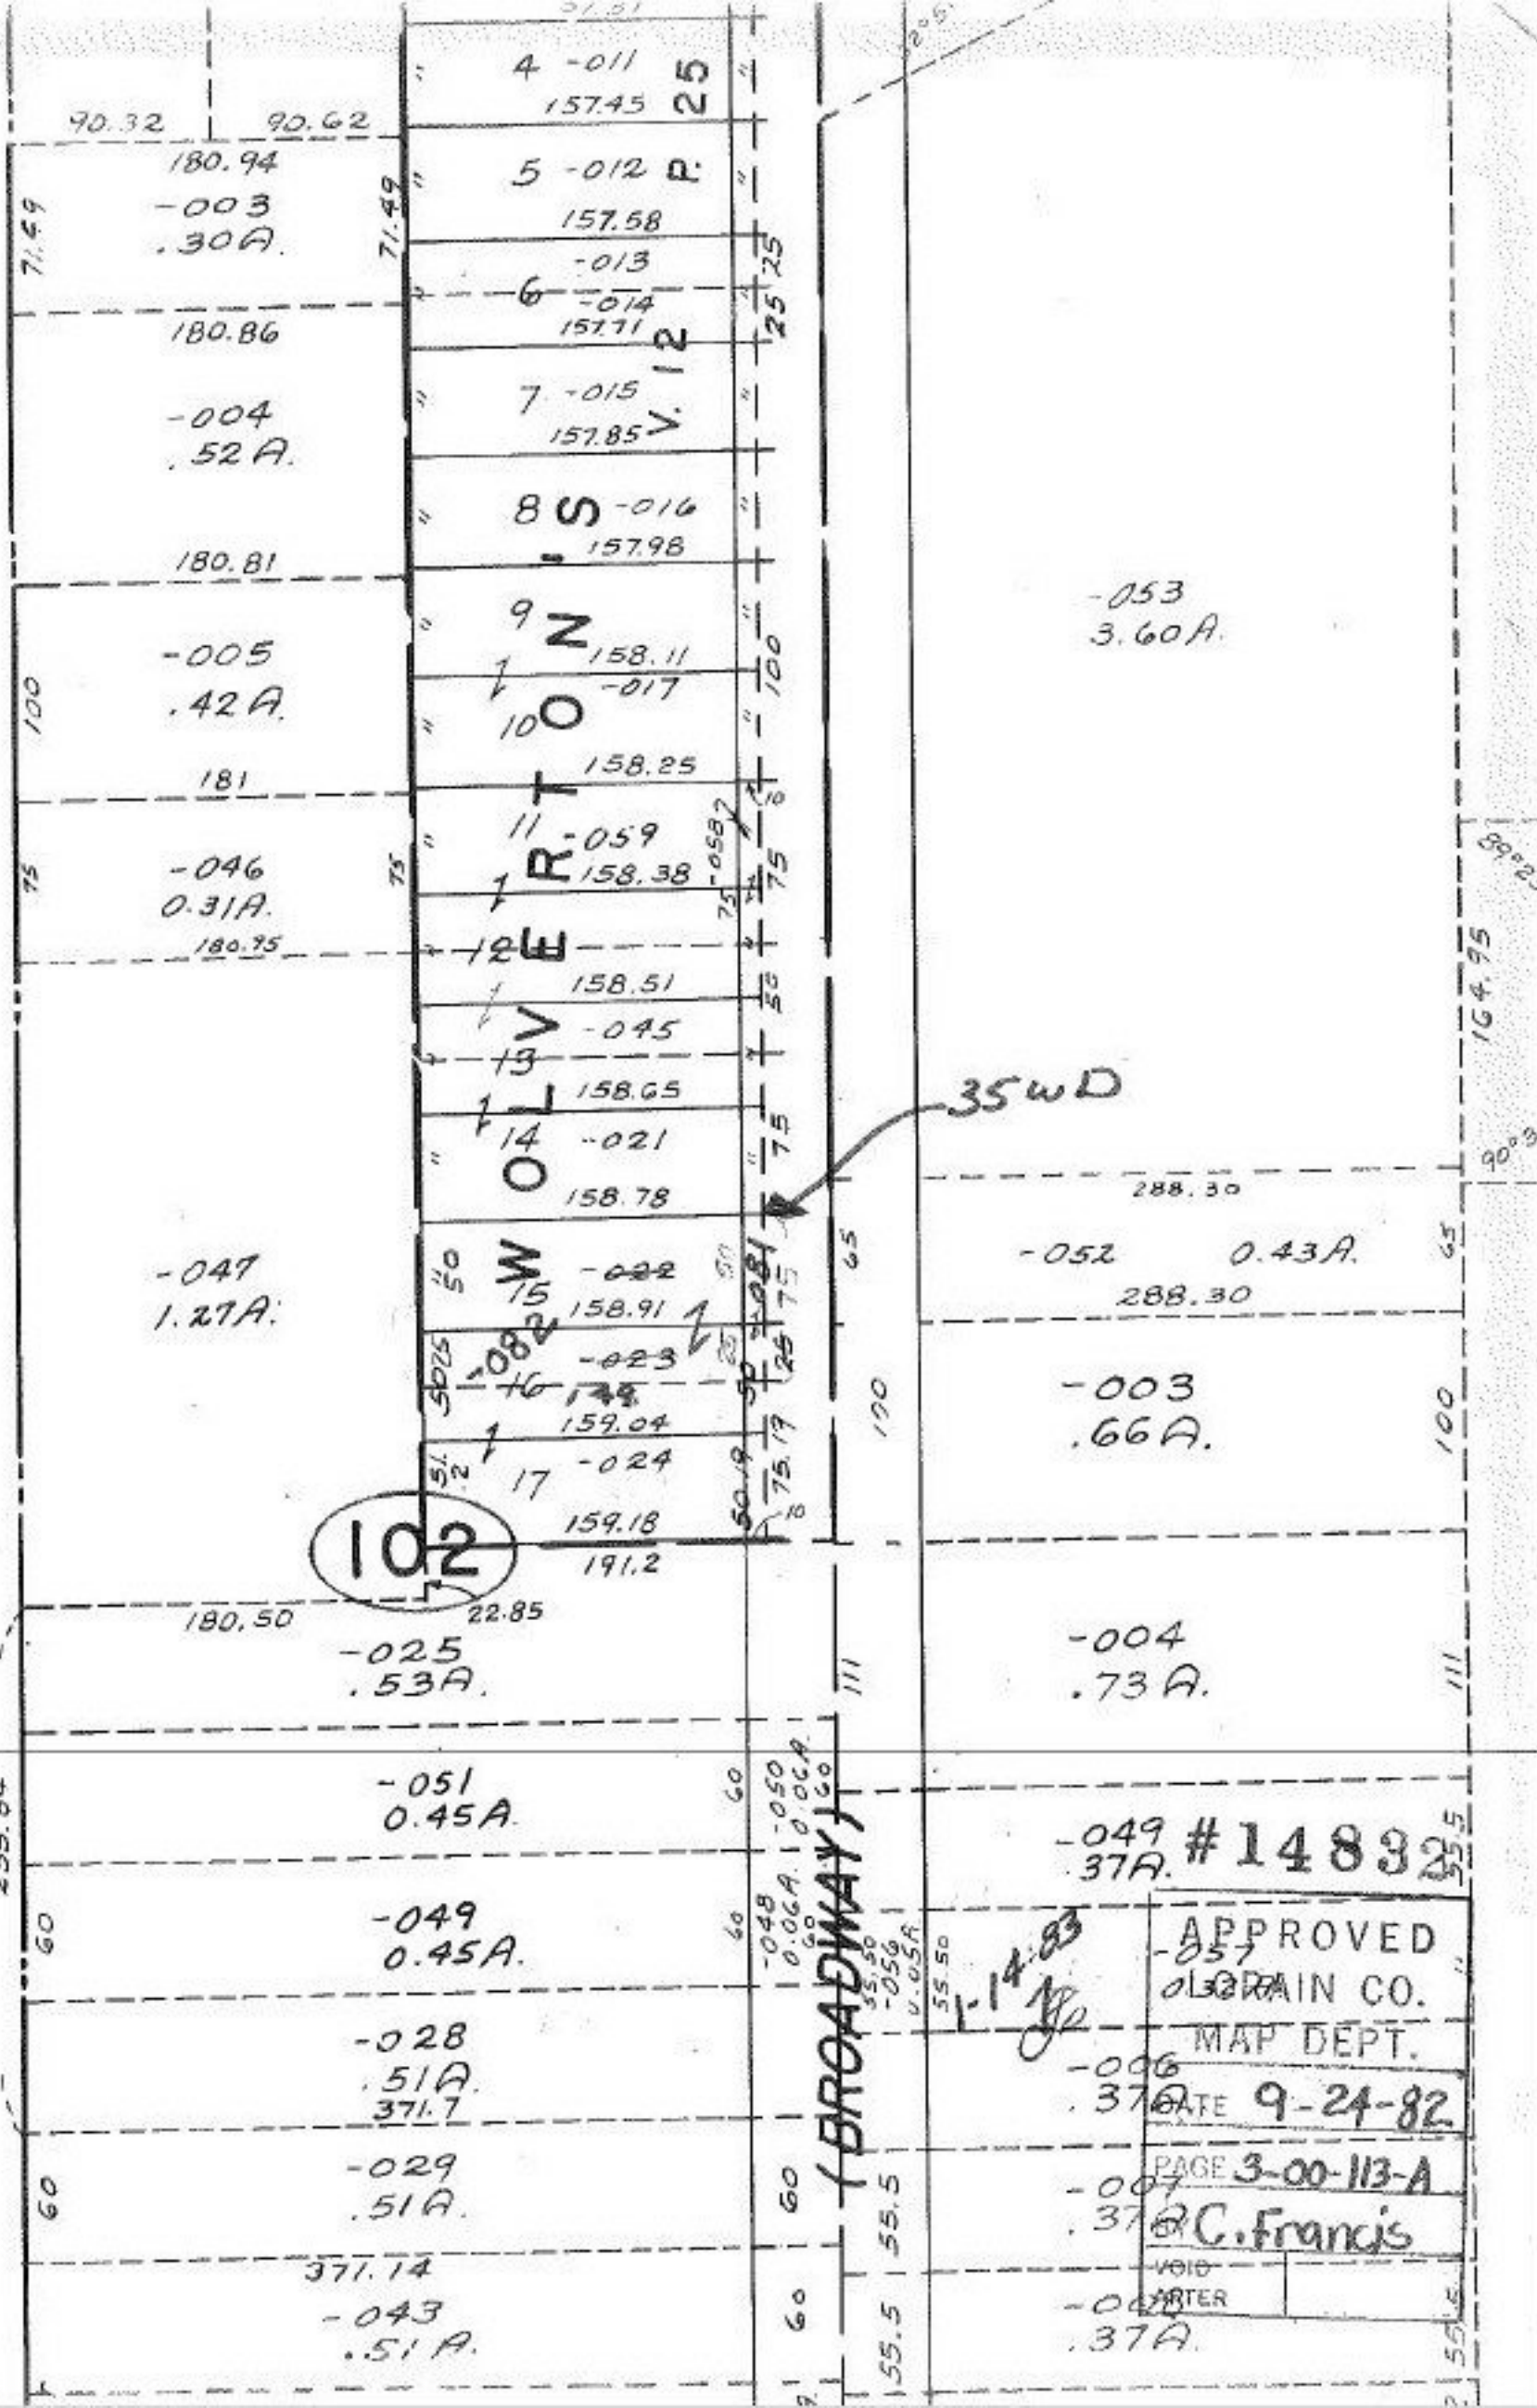

102

35WD

-049 #14832

APPROVED
OLBRAIN CO.
MAP DEPT.

DATE 9-24-82

PAGE 3-00-113-A

C. Francis

VOID
ENTER

-048
.37A

(BROADWAY)

1-14-83
JF