


SEE 1-0

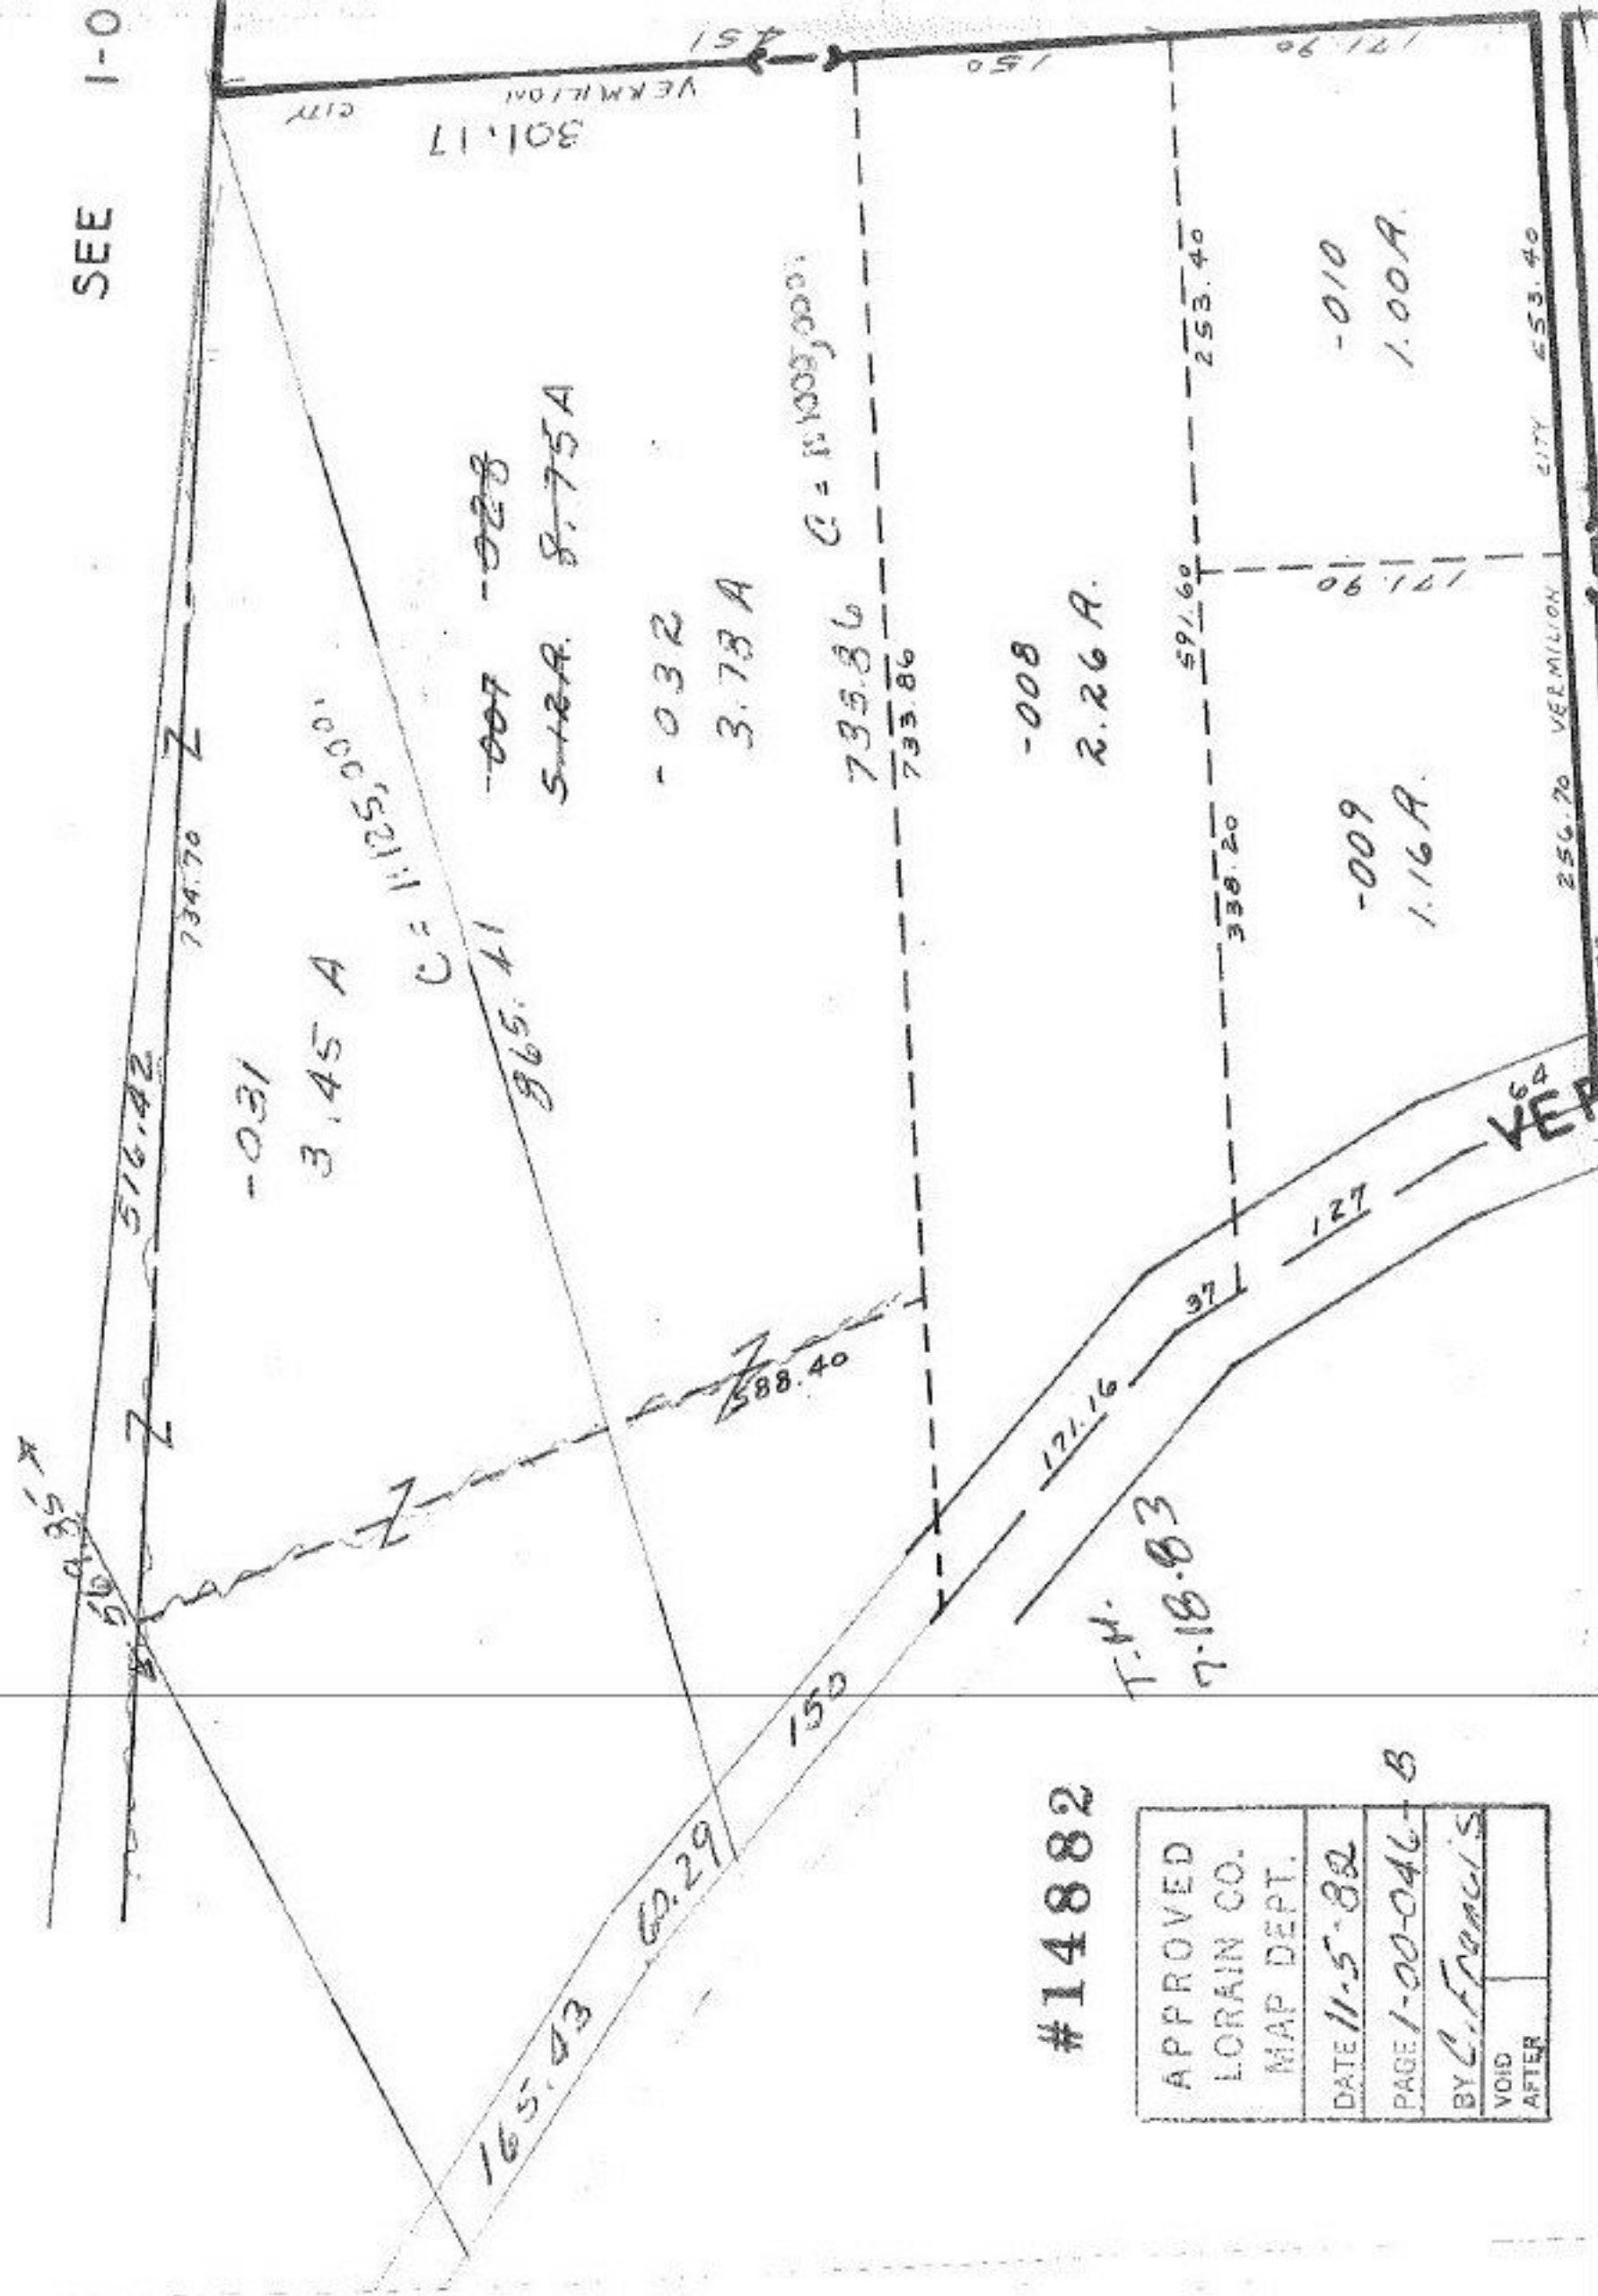

#14882

APPROVED	
LORAIN CO.	
MAP DEPT.	
DATE 11-5-82	
PAGE 1-00-046-B	
BY C. Francis	
VOID AFTER	

VERMILION CITY 256.70 VERMILION CITY 253.40