


Acres Corr. Only  
 PER Deed VOL. 1114/749 U

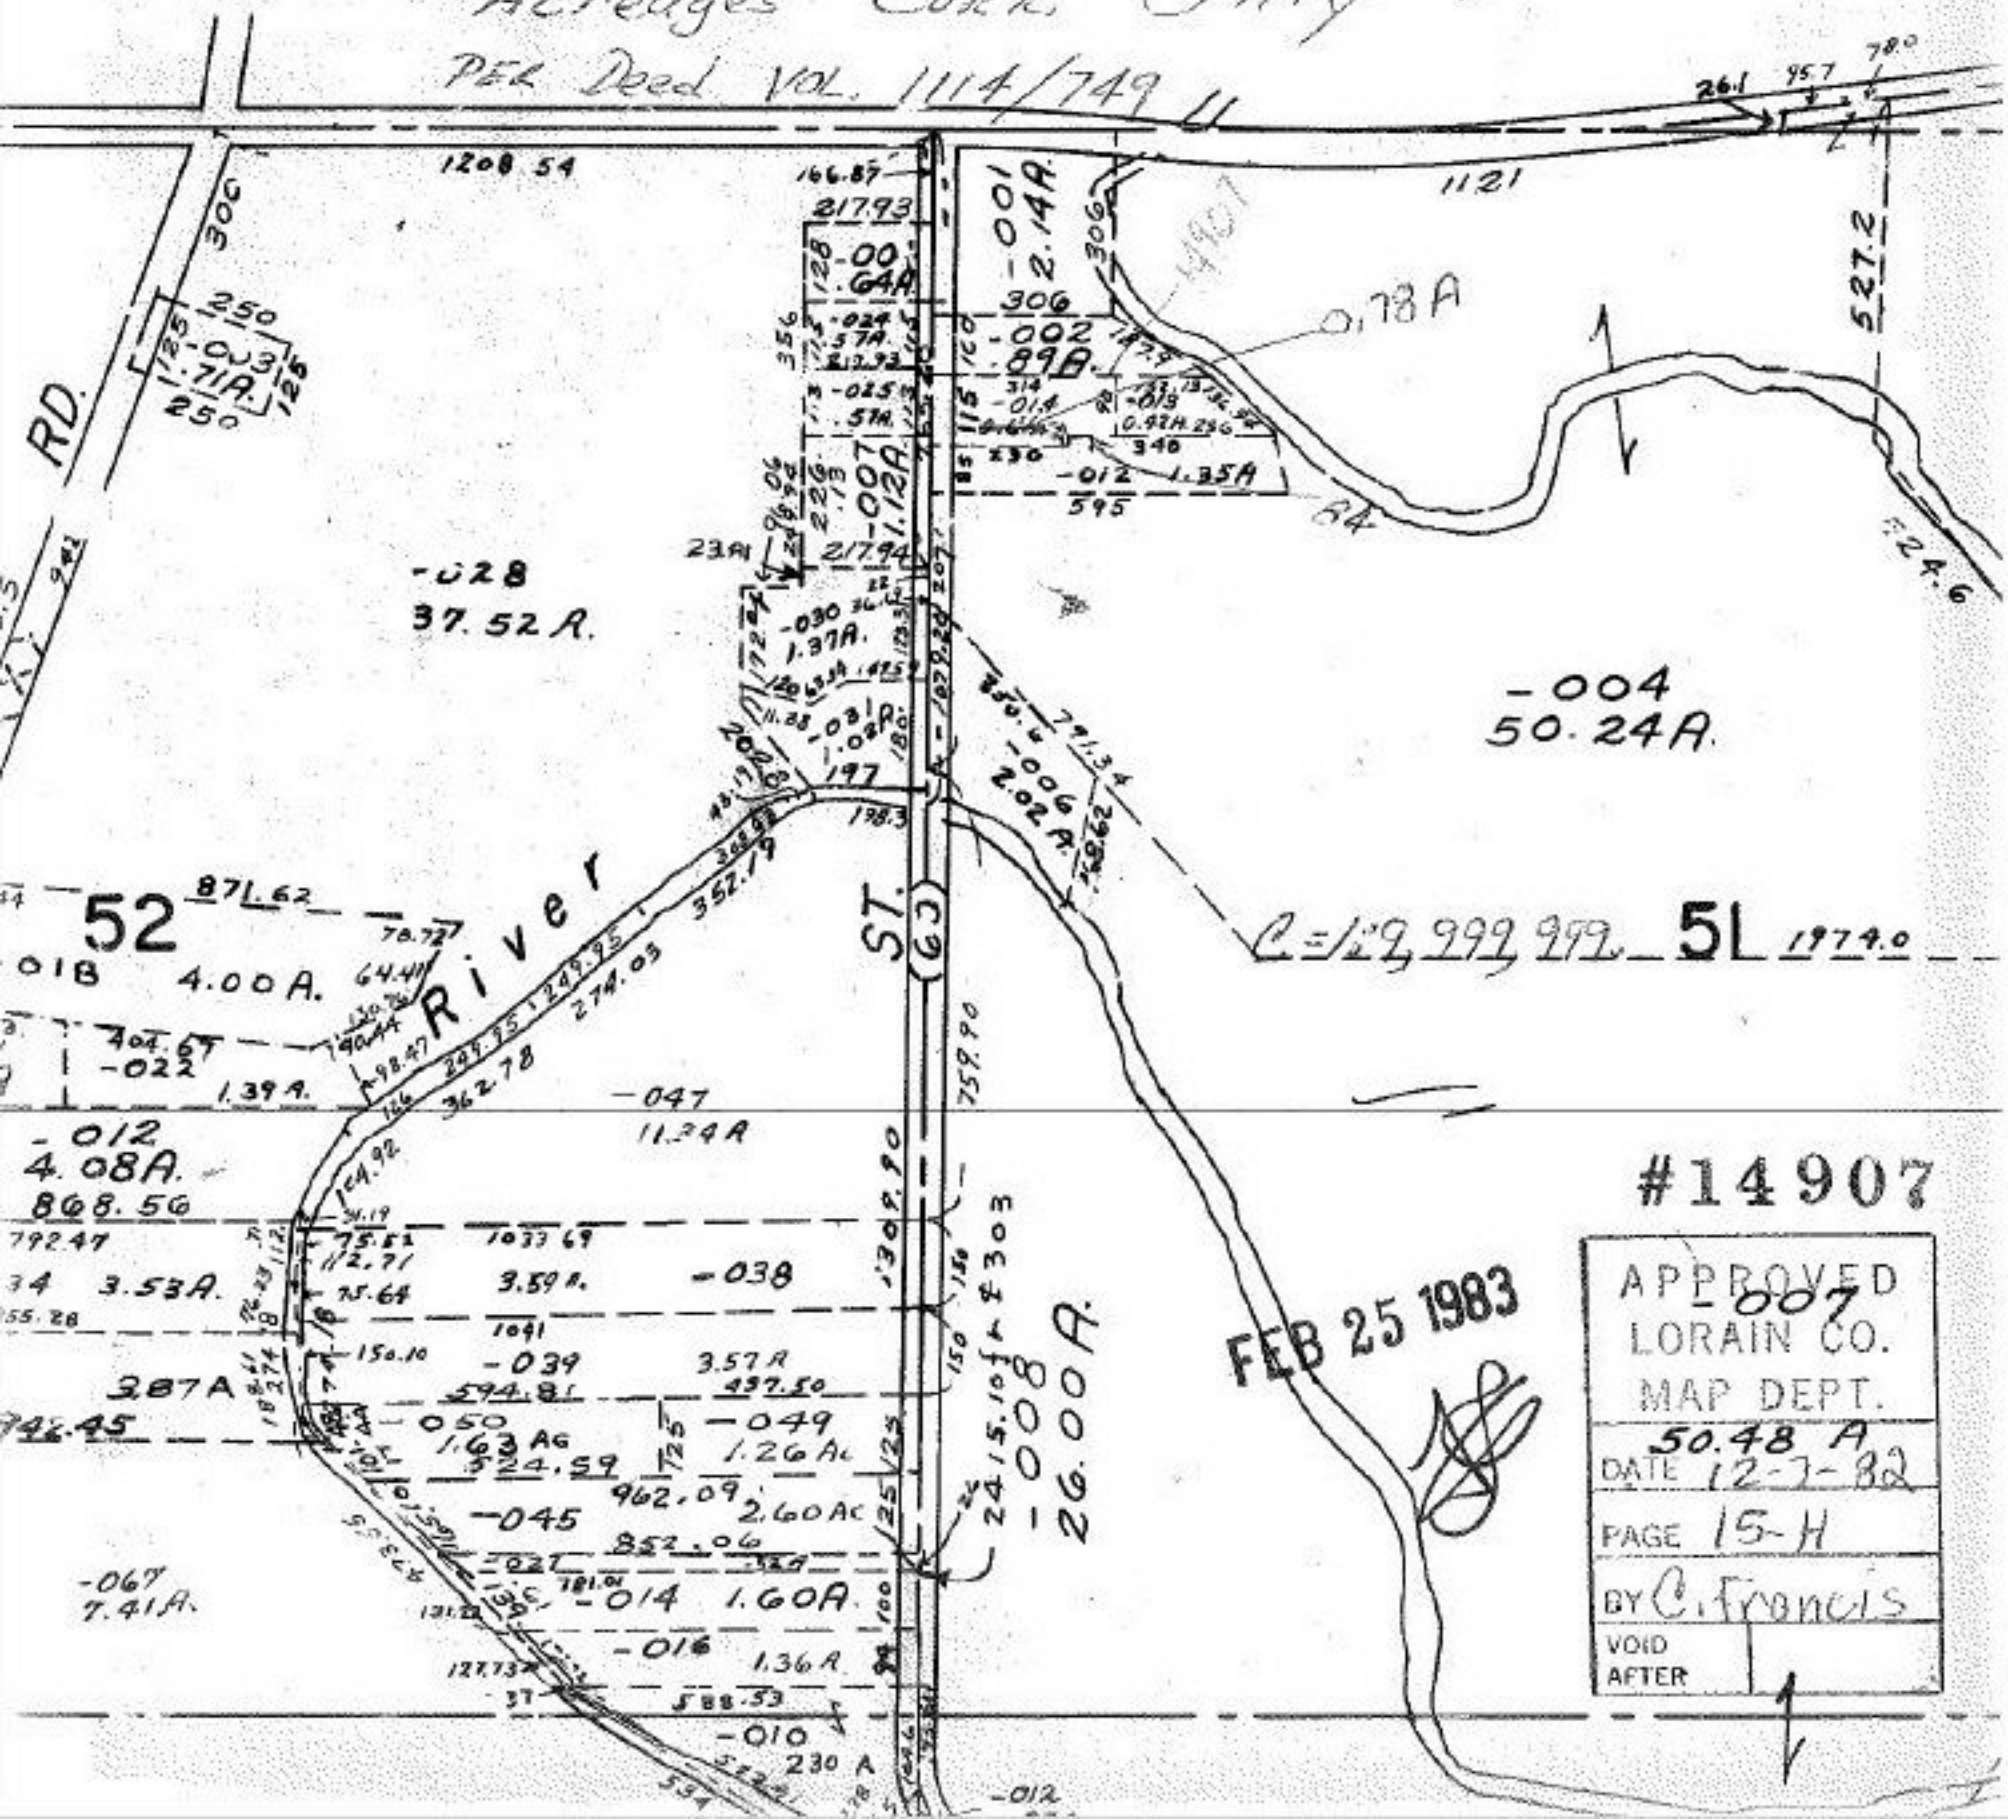

FEB 25 1983

#14907

APPROVED	007
LORAIN CO.	
MAP DEPT.	
50.48 A	
DATE	12-7-82
PAGE	15-H
BY	C. Francis
VOID AFTER	