


Pt. -109
Pt. 34.47A.

ACREAGE CORRECTION

#14918

APPROVED	
LORAIN CO.	
MAP DEPT.	
DATE	12/19/82
PAGE	4-00-011-E
BY	T. McNeil
VOID	
AFTER	

JAN 21 1983

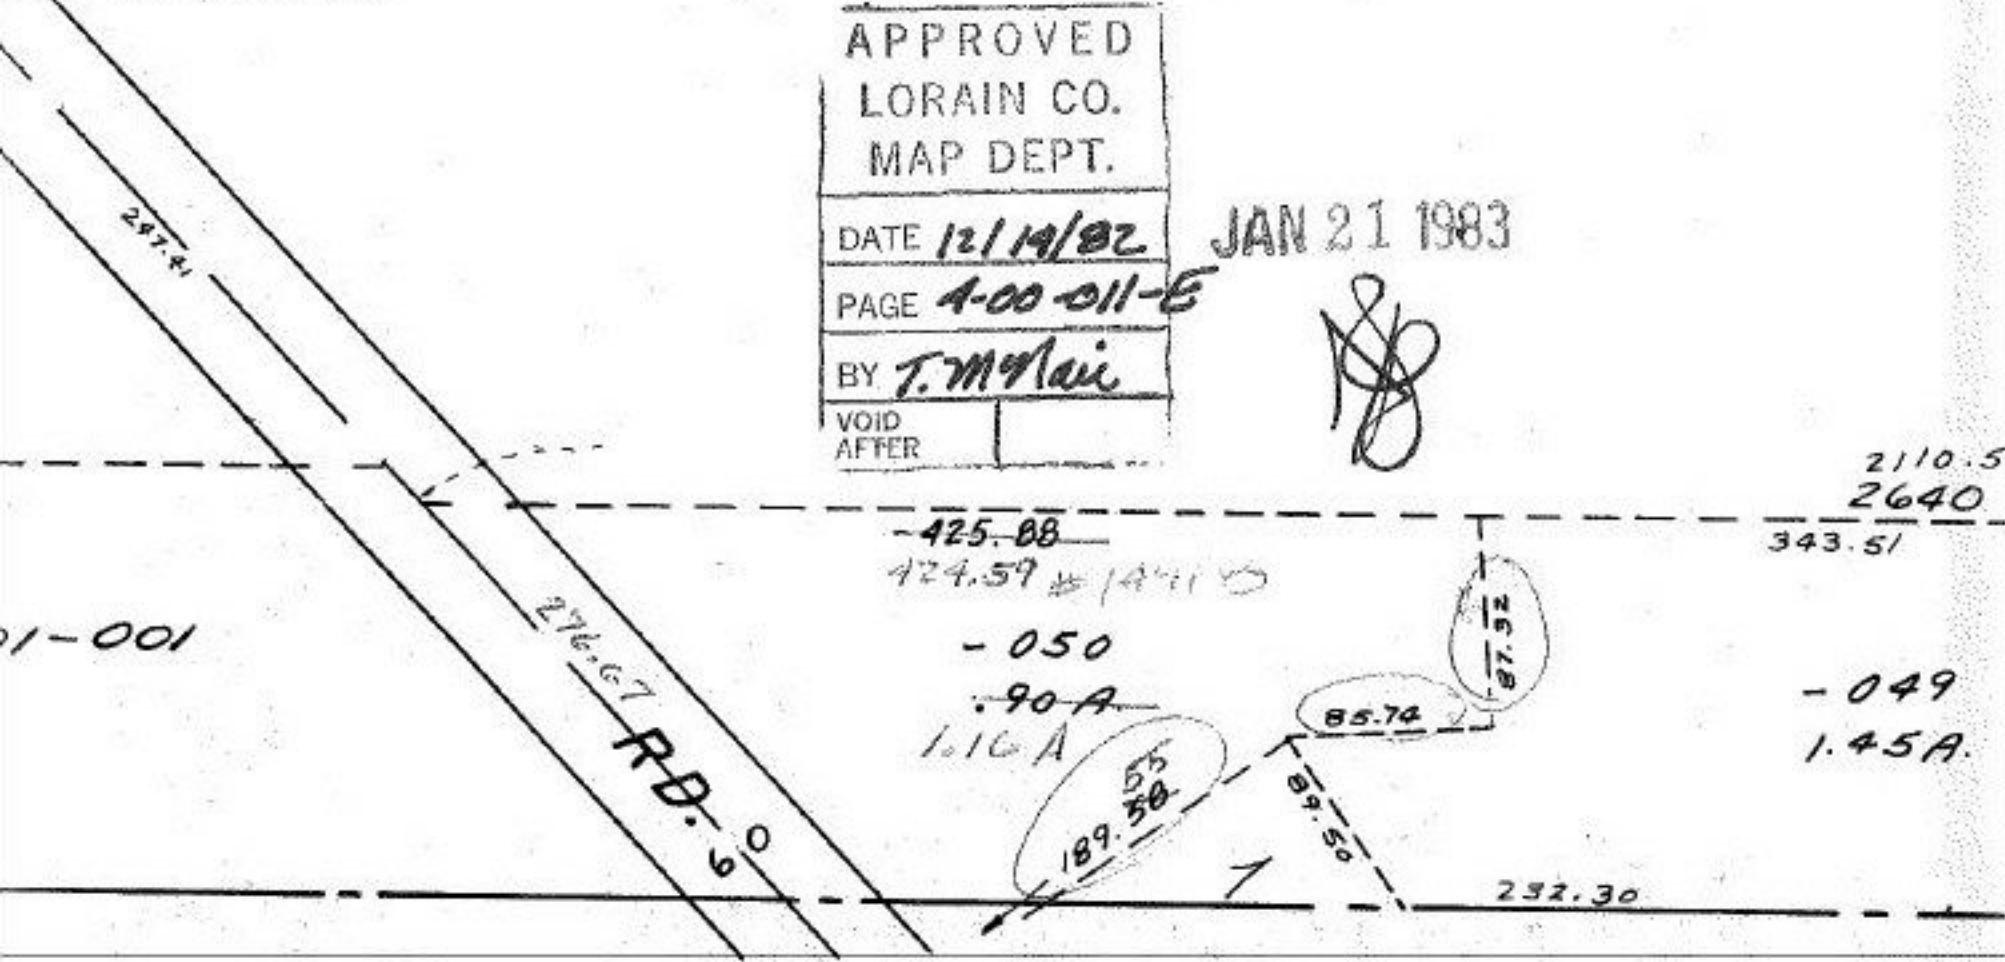

SEE 4-00-012-A

SURVEY BY WALKER & Assoc.

Y

W 1/2 SW 1/4