


SEE 4

RIEGELSBERGER

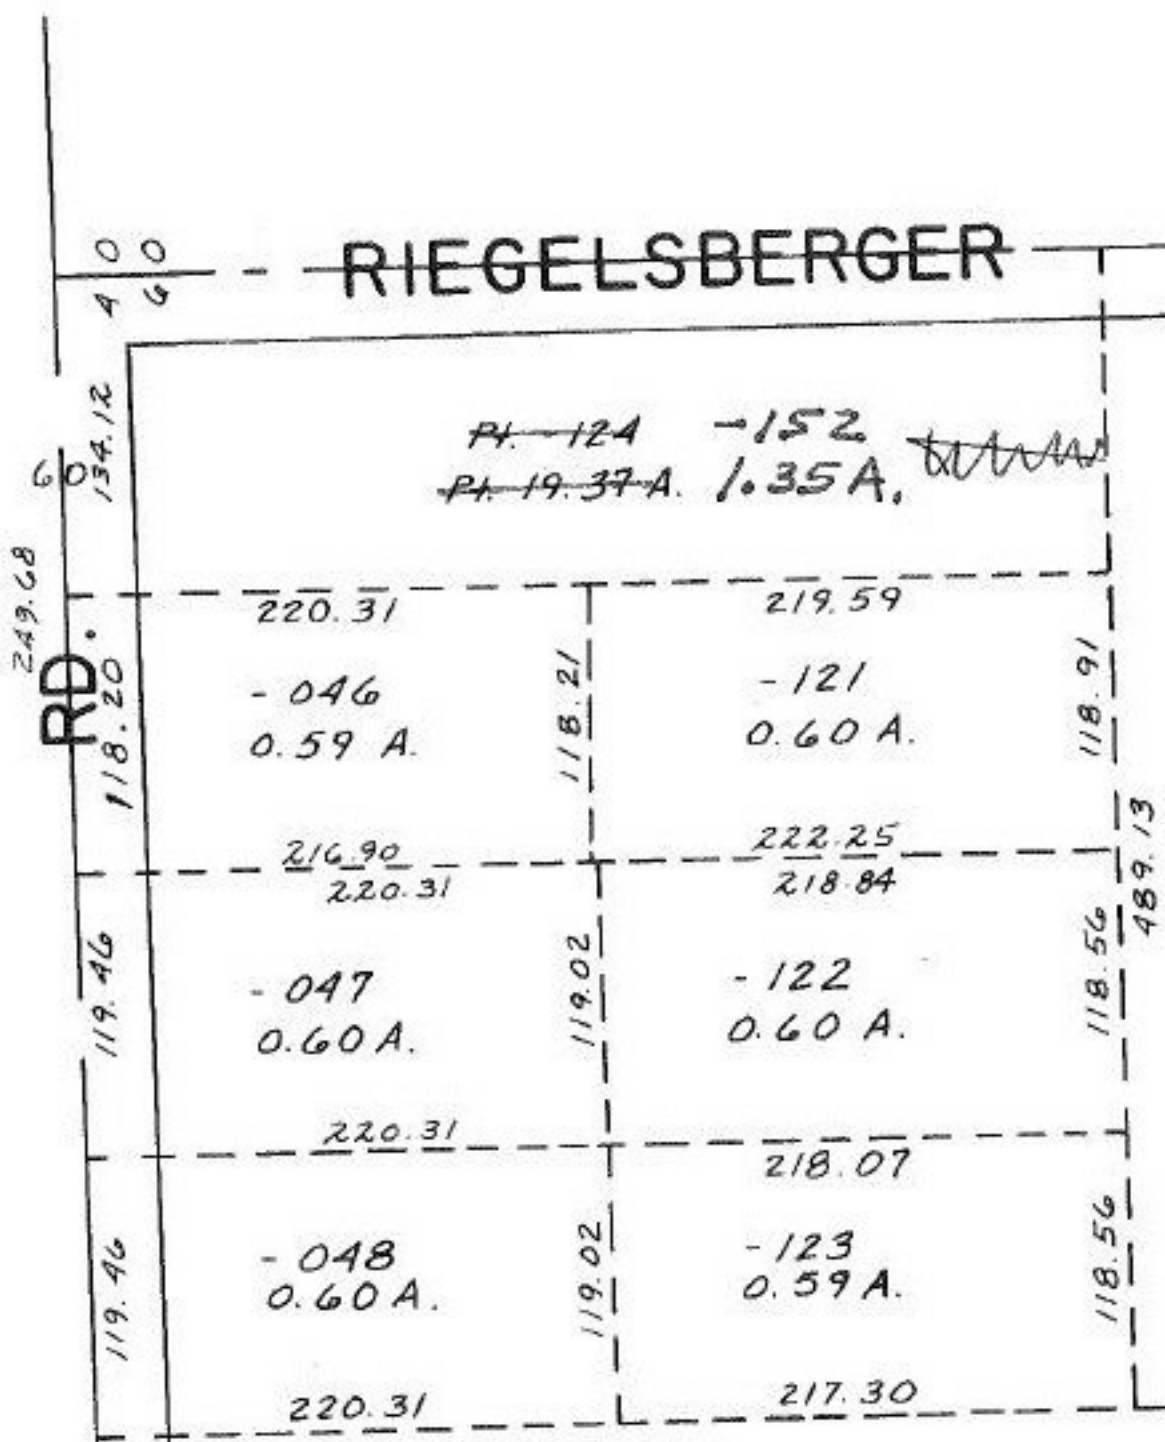

~~Pt. 124~~ -152
~~Pt. 19.37 A.~~ 1.35 A.

#14952

APR 1 1983

APPROVED	
LORAIN CO.	
MAP DEPT.	
DATE 1-13-83	
PAGE 4-00-013 C	
BY <i>[Signature]</i>	
VOID AFTER	14952

Pt. - 049
Pt. 19.93 A.