


New

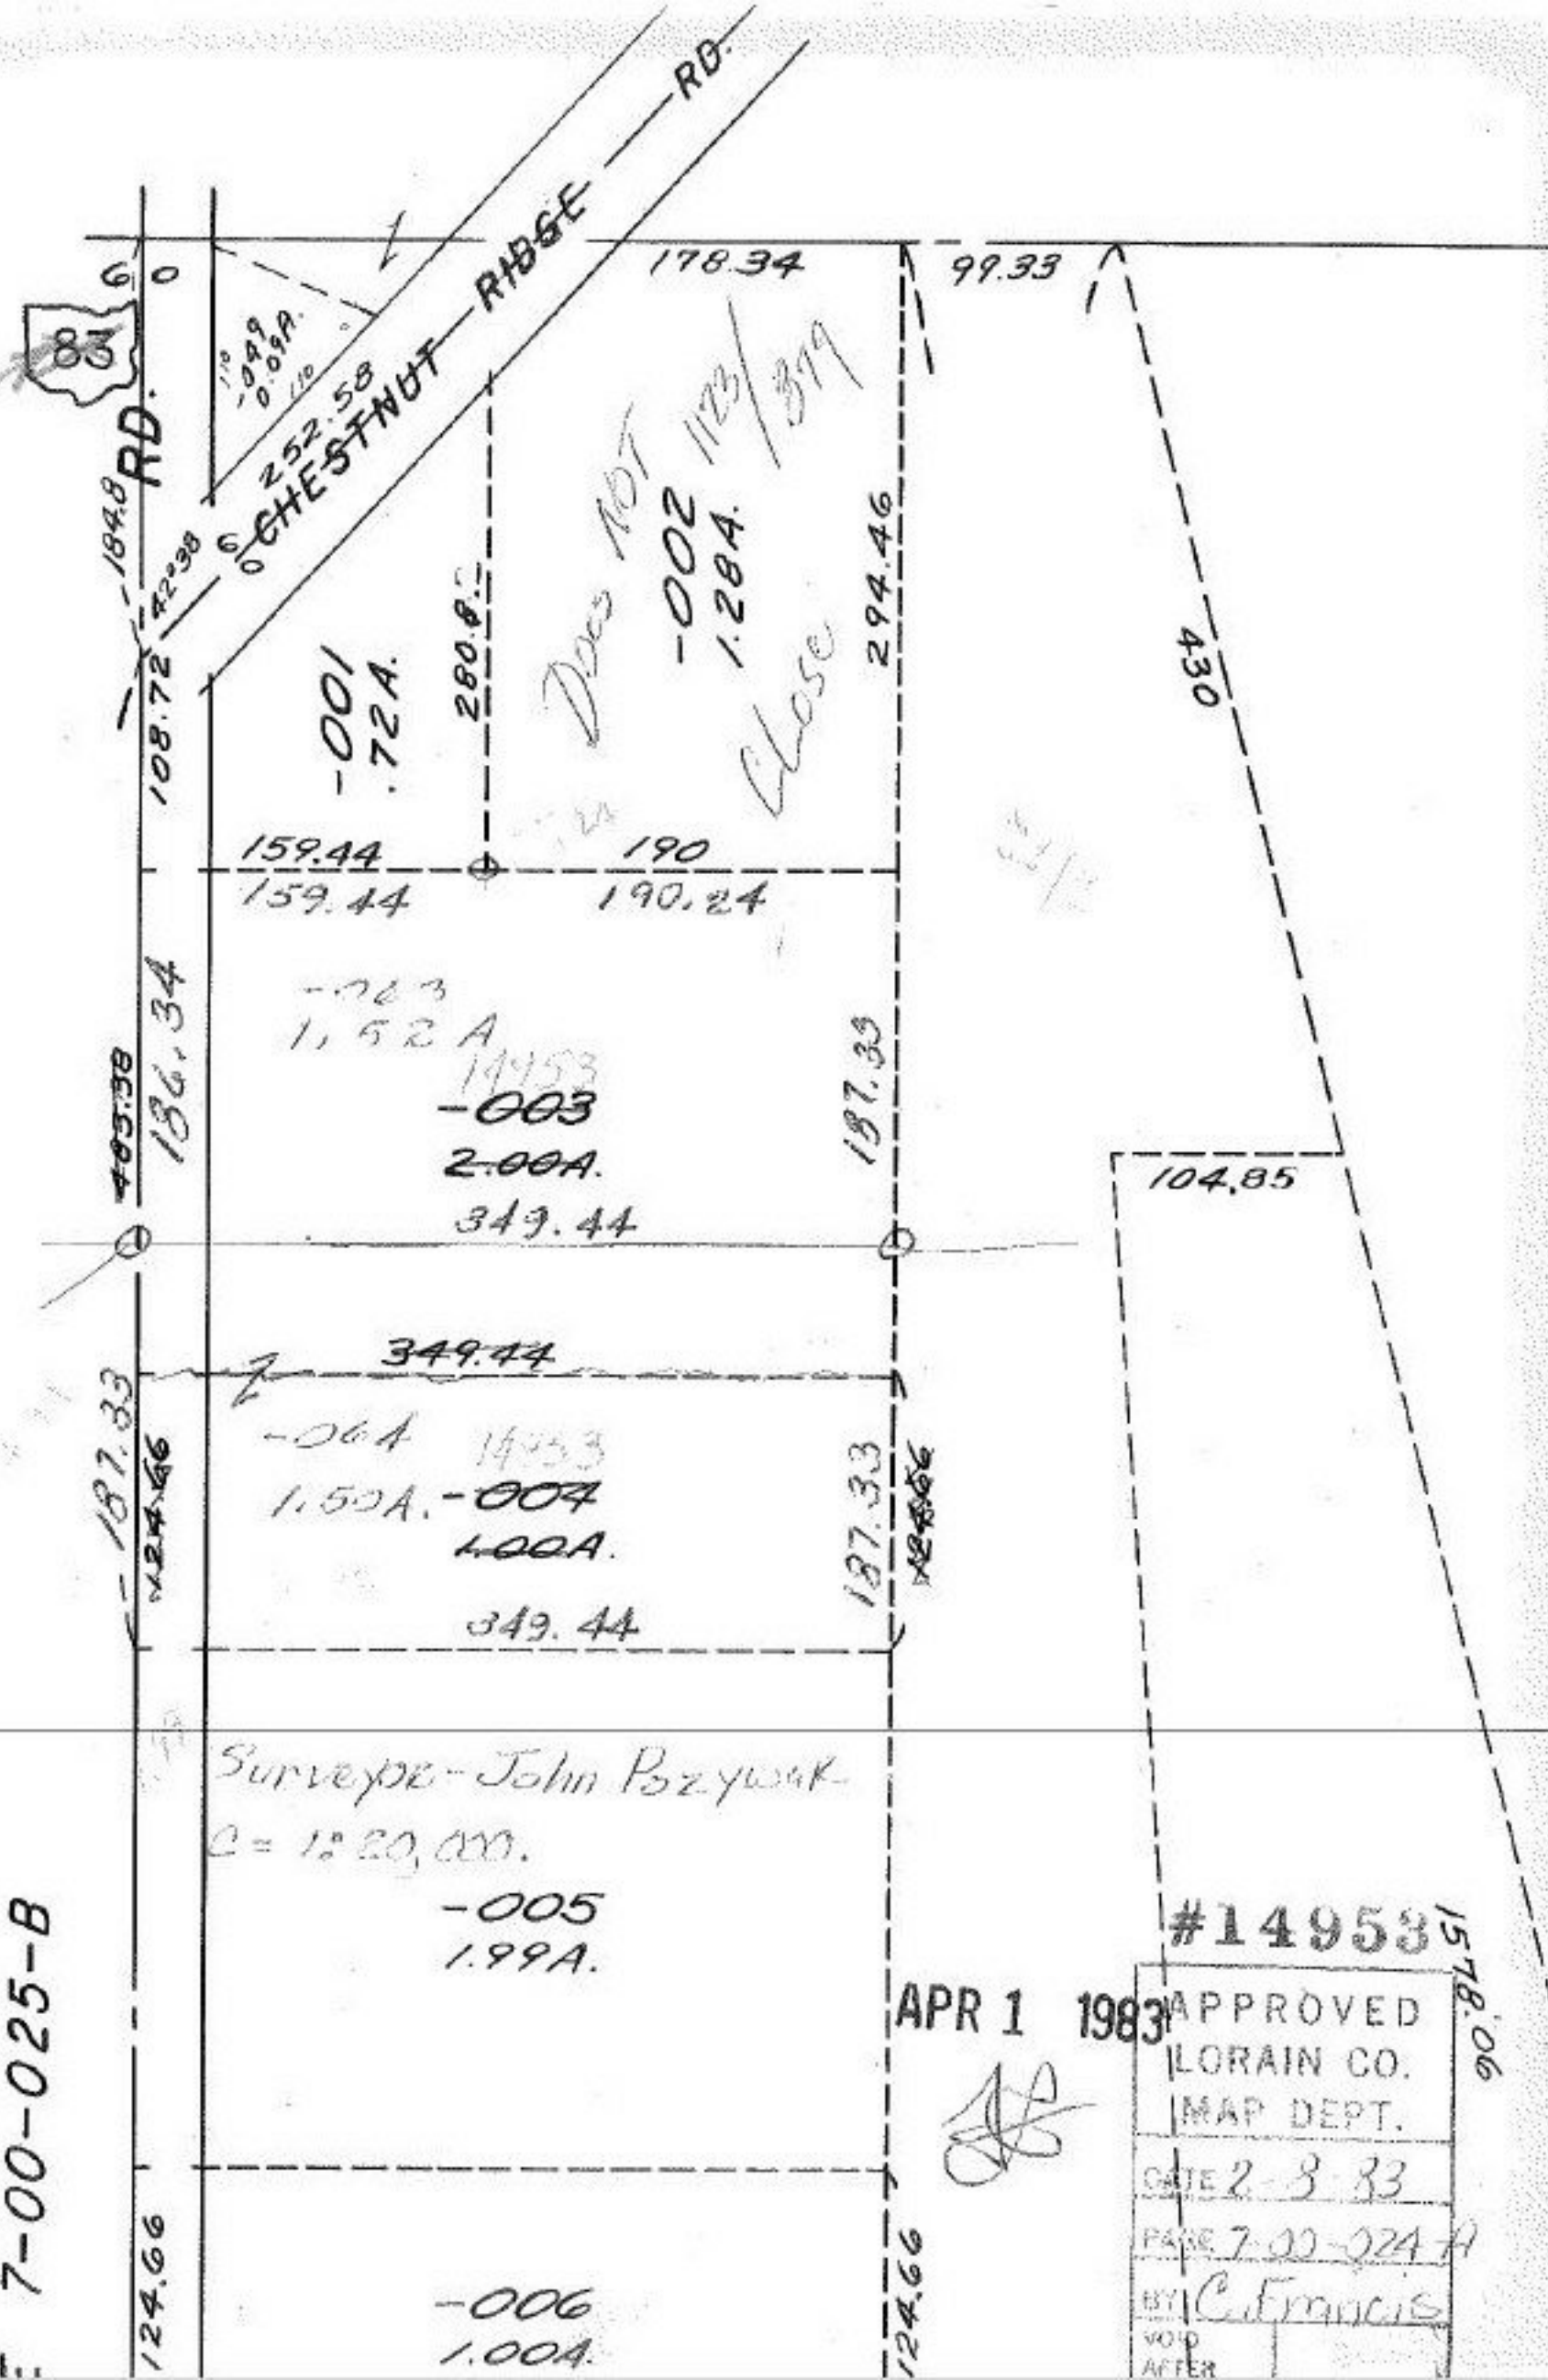

E 7-00-025-B

RD. 8

RD.

CHESTNUT RIDGE RD.

-001  
1.72A.

Does NOT  
-002 1123/379  
Close  
1.28A.

-003  
1.52A  
14953  
2.00A.  
349.44

-004  
1.50A.  
14953  
4.00A.  
349.44

Surveyor - John Pozysak  
C = 1:20,000.  
-005  
1.99A.

-006  
1.00A.

APR 1 1983

*[Signature]*

APPROVED
LORAIN CO.
MAP DEPT.
GATE 2-3-83
PARCELS 7-00-024 A
BY C. Francis
VOID AFTER

#14953

1578.06

1848

108.72

403.38  
136.34

187.33  
124.46

124.66

42.38

252.58

159.44

349.44

124.66

124.66

178.34

190

190.24

187.33

187.33

280.8

294.46

104.85

99.33

430