


#14954

44.29  
46.58  
90.87

SEE 2-01-003-L

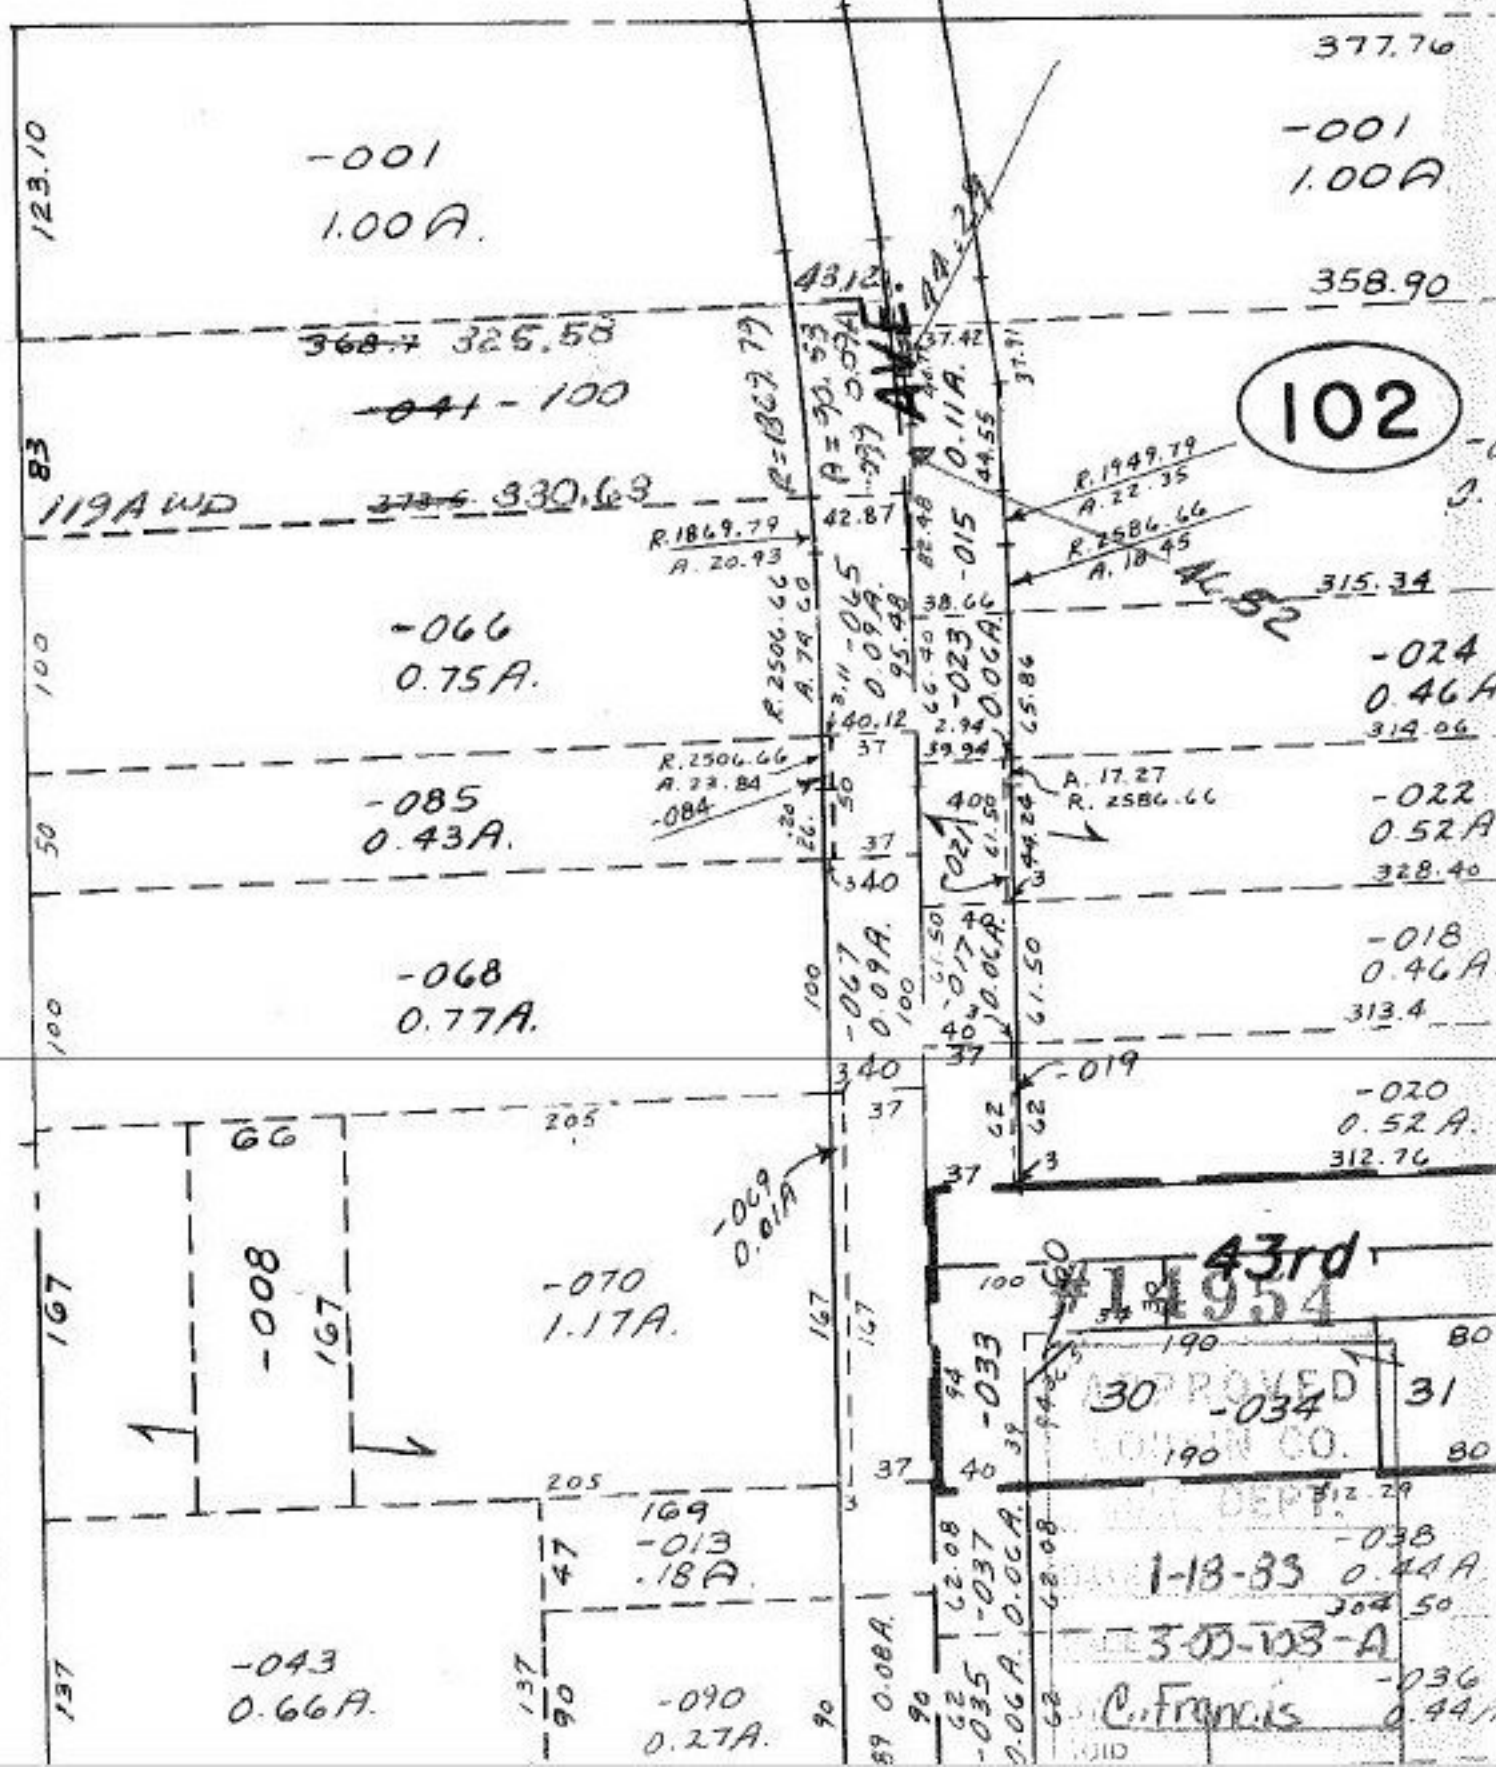

102

43rd  
#14954

APPROVED  
LOUISIANA CO.  
DEPT.

1-18-33

3-03-103-A

C. Francis