


SPRAGUE

74.51

RD. 271.55 0

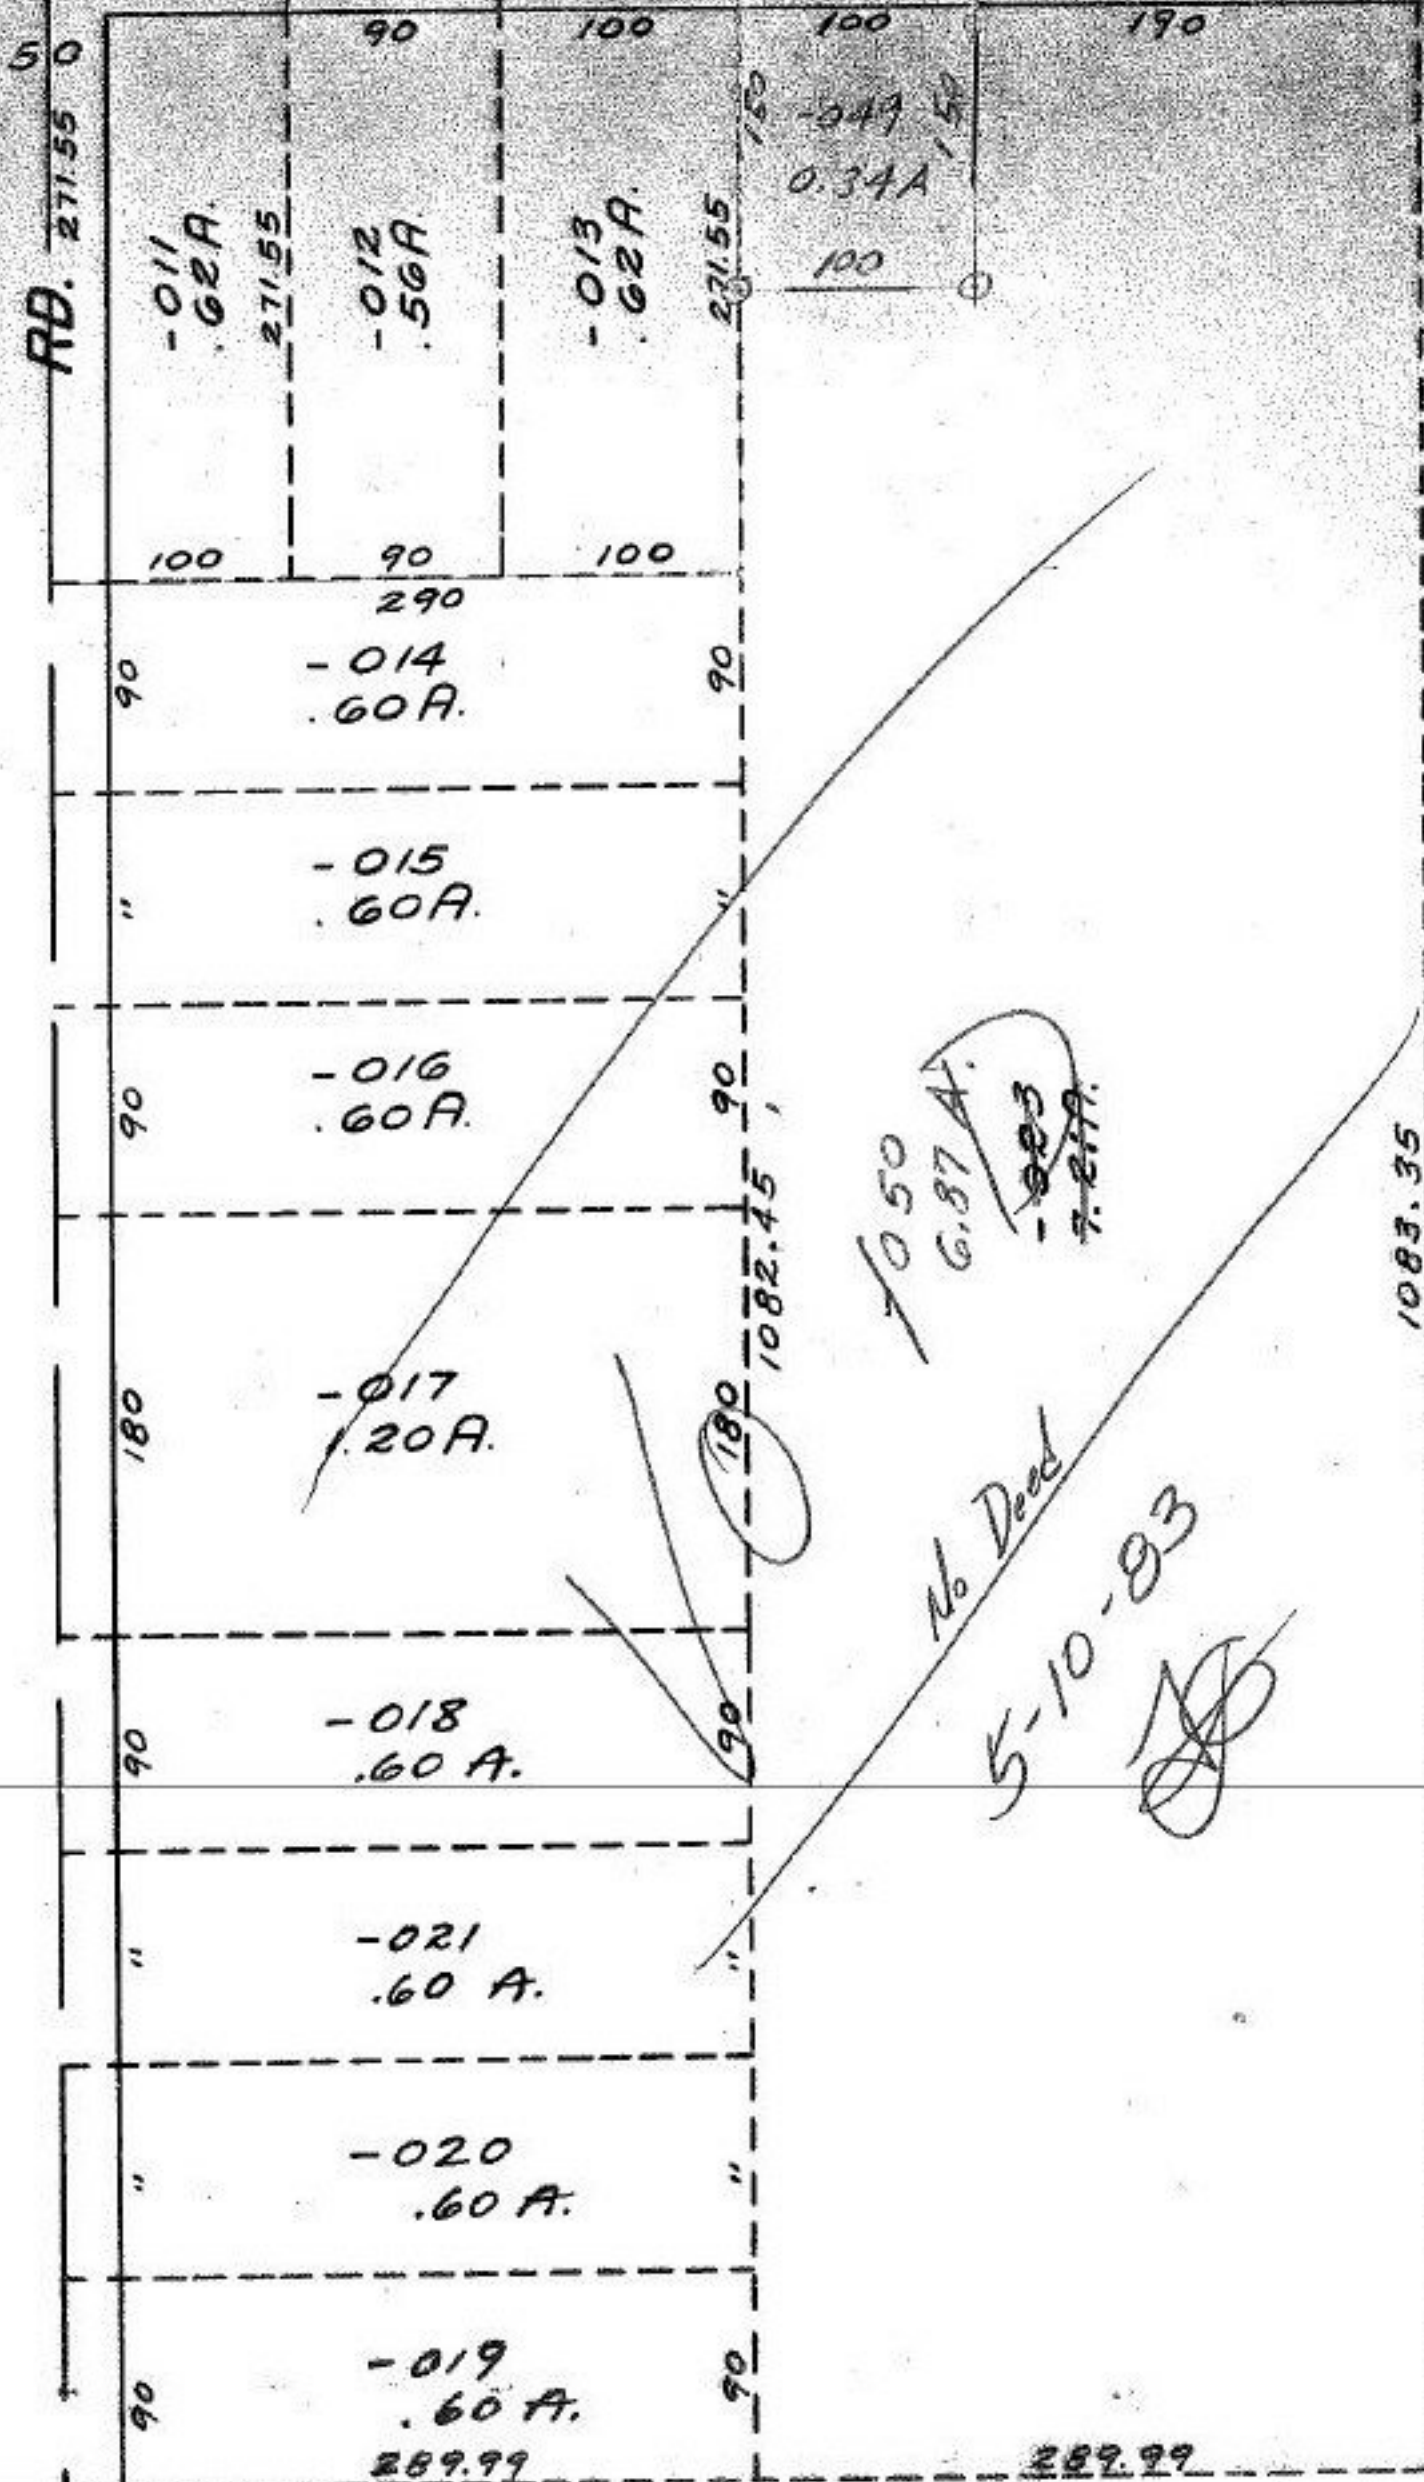

1050
 6.87 A.
~~0.883~~
 7.277 A.

No Deed
 5-10-83

-024
 3.04 A.

#14959

APPROVED
 LORAIN CO.
 MAY DEPT.

DATE 1-27-83

BY 12-00-031-B

C. Francis

VOID
 AFTER

289.99

289.99