


SEE 7-00-004-D

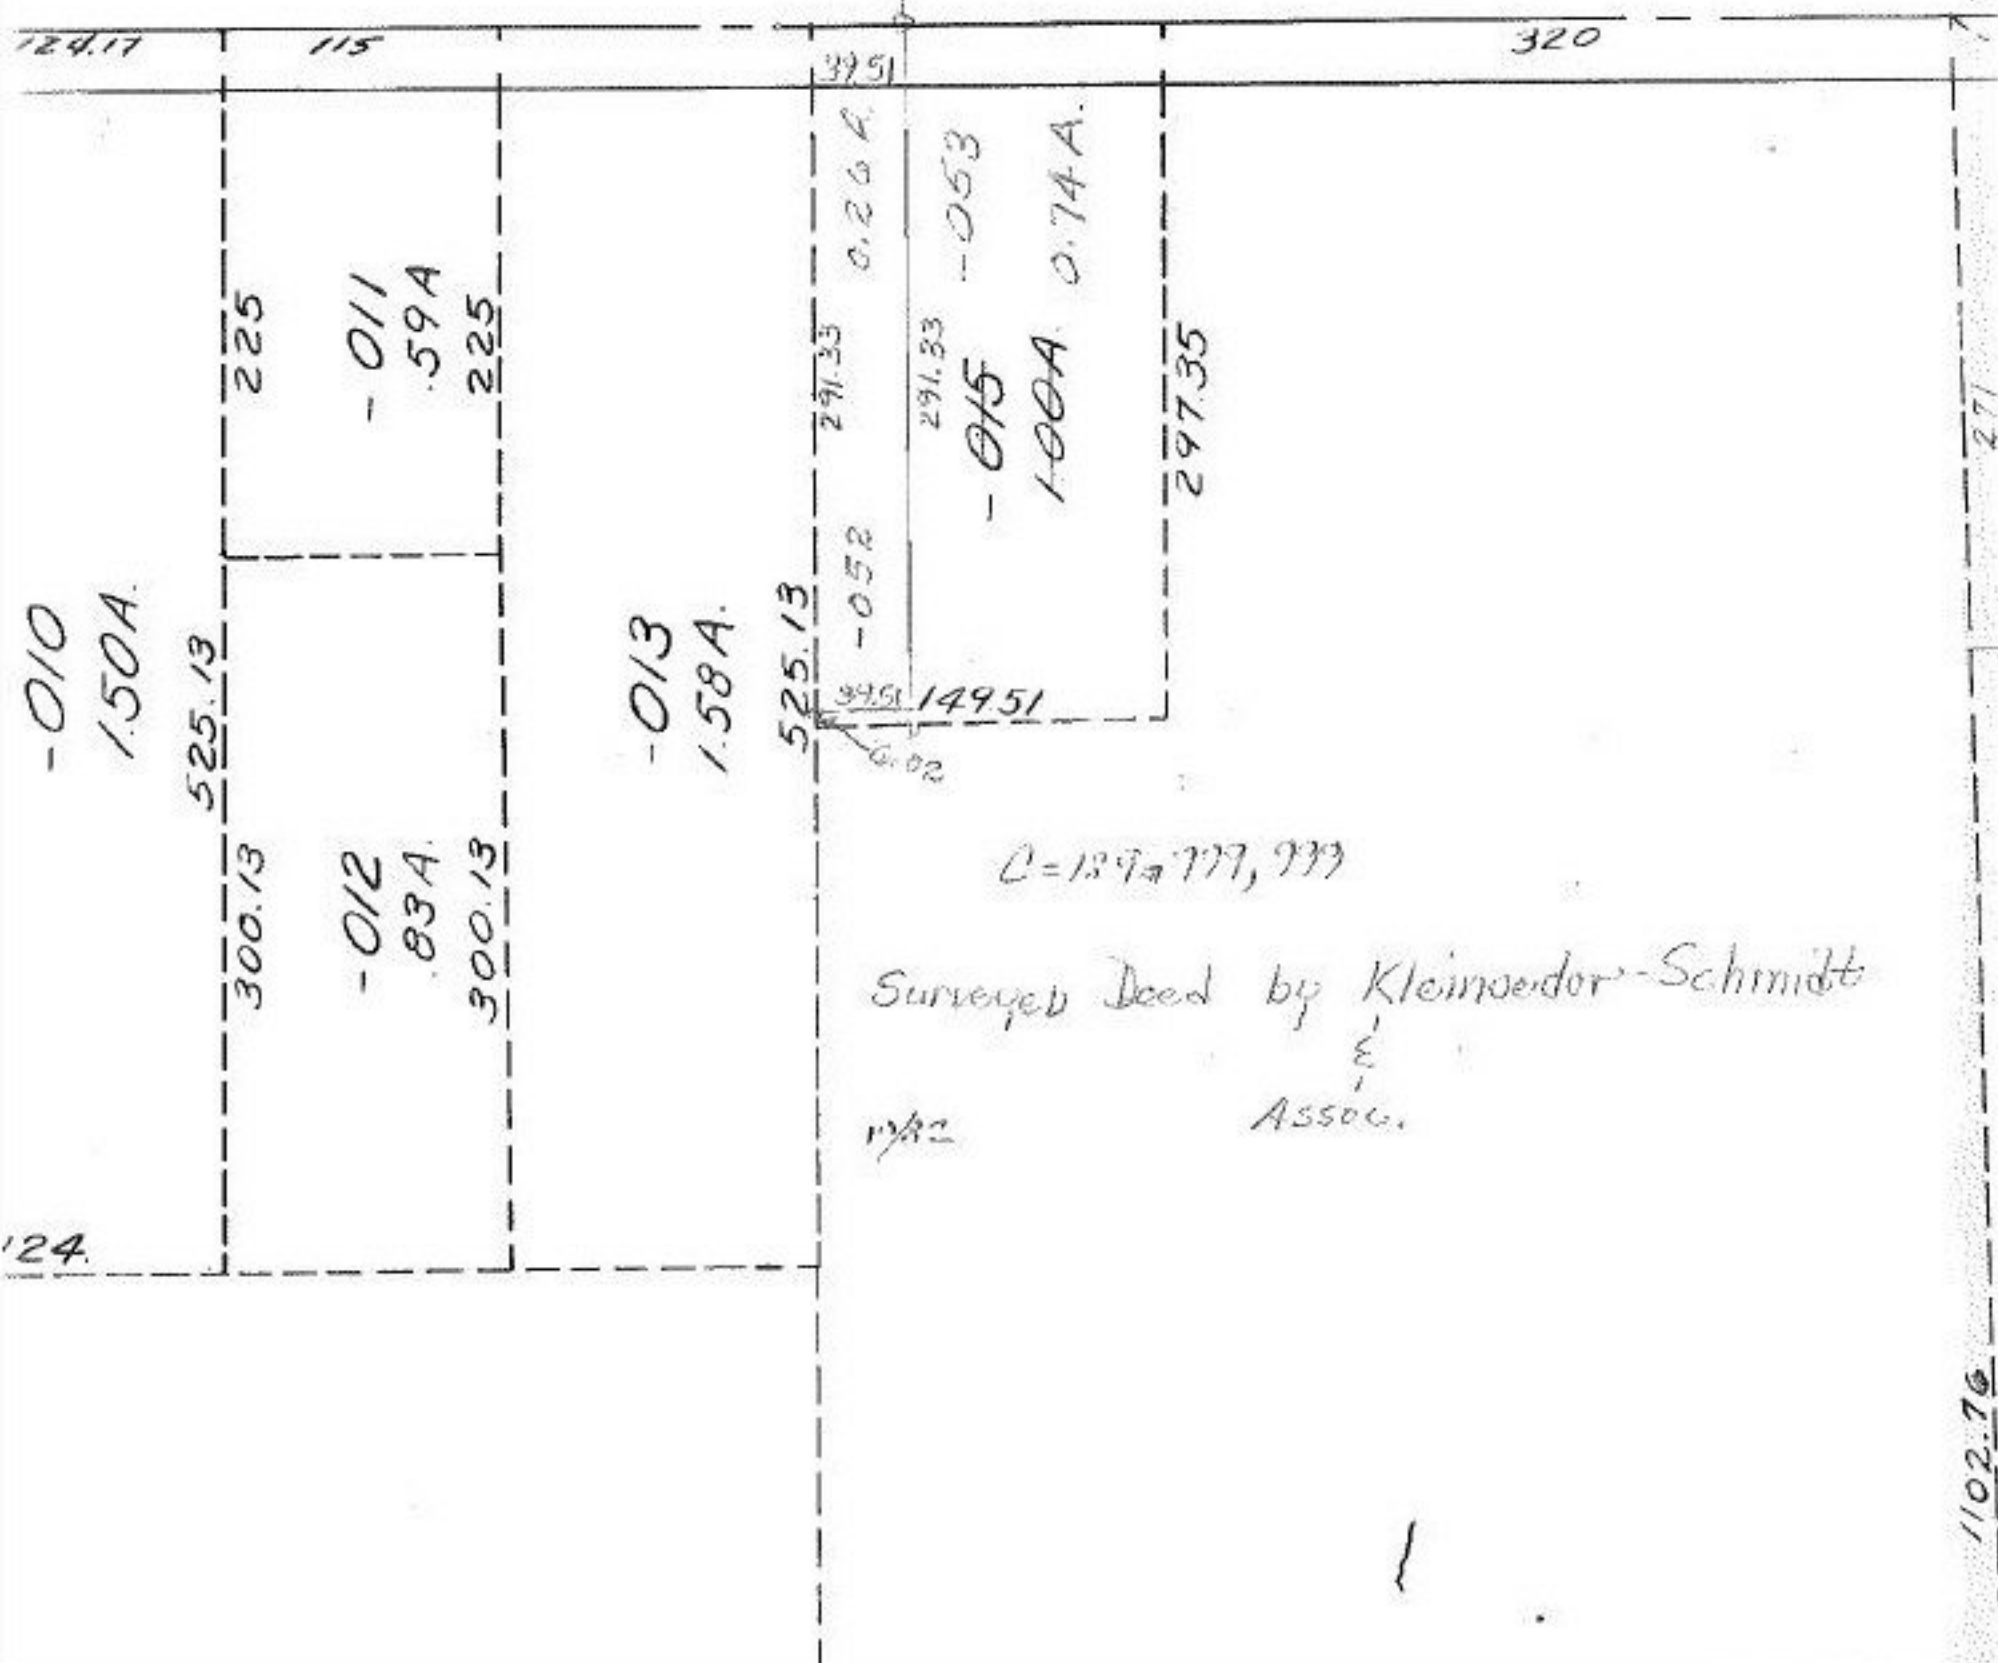

C=137.777, 777

Surveyed Deed by Kleinendorfer-Schmidt & Assoc.  
1982

#14962

# [REDACTED]

APR 1 1983

*[Handwritten Signature]*

APPROVED LORAIN CO. MAP DEPT.	
DATE 2-2-83	
PAGE 7-00-003-f	
BY C. Francis	
VOID AFTER	

1102.76  
271