


- 006
 66.25 A. Dup. #1
 1.00 A. Dup. #2
 67.25 A. Tot. **25**

Combination **R A**
T ONLY

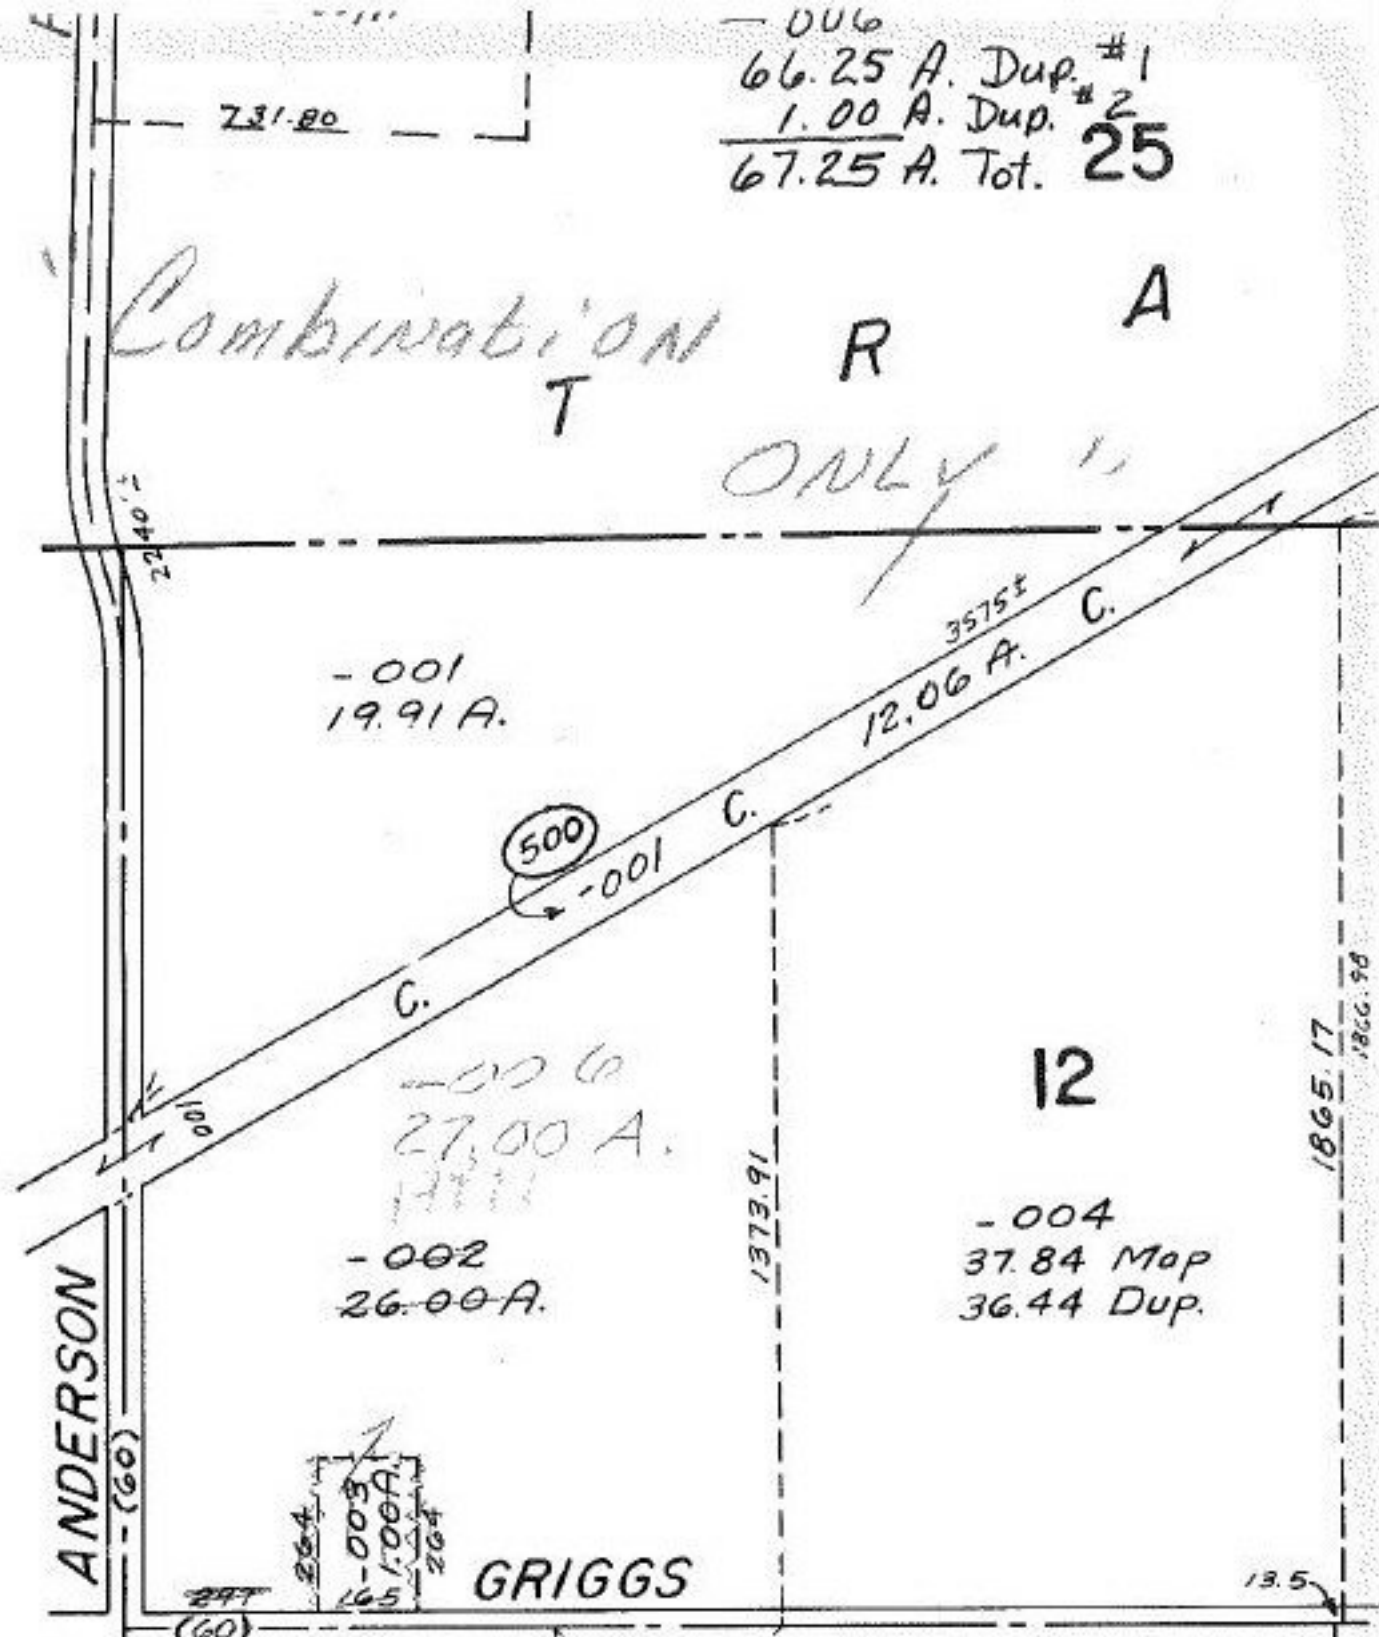

- 002 #14681
 58.00 A. Map
 53.56 A. Dup
 53.6 A. Pl.

APPROVED
 PLAIN CO.
 MAP DEPT.
 DATE 2-23-83
 BY 27-D
 C. Francis
 WORD
 AS TER

APR 1 1983