



PARENT PARCEL: 03-00-113-106-029  
CHILD PARCEL: 03-00-108-111-078, 03-00-113-106-060  
STARTING POINT: NORTHEAST CORNER OF S/L 46 IN HILL'S ALLOTMENT (VOL.19 PG.7)


**15-00708**

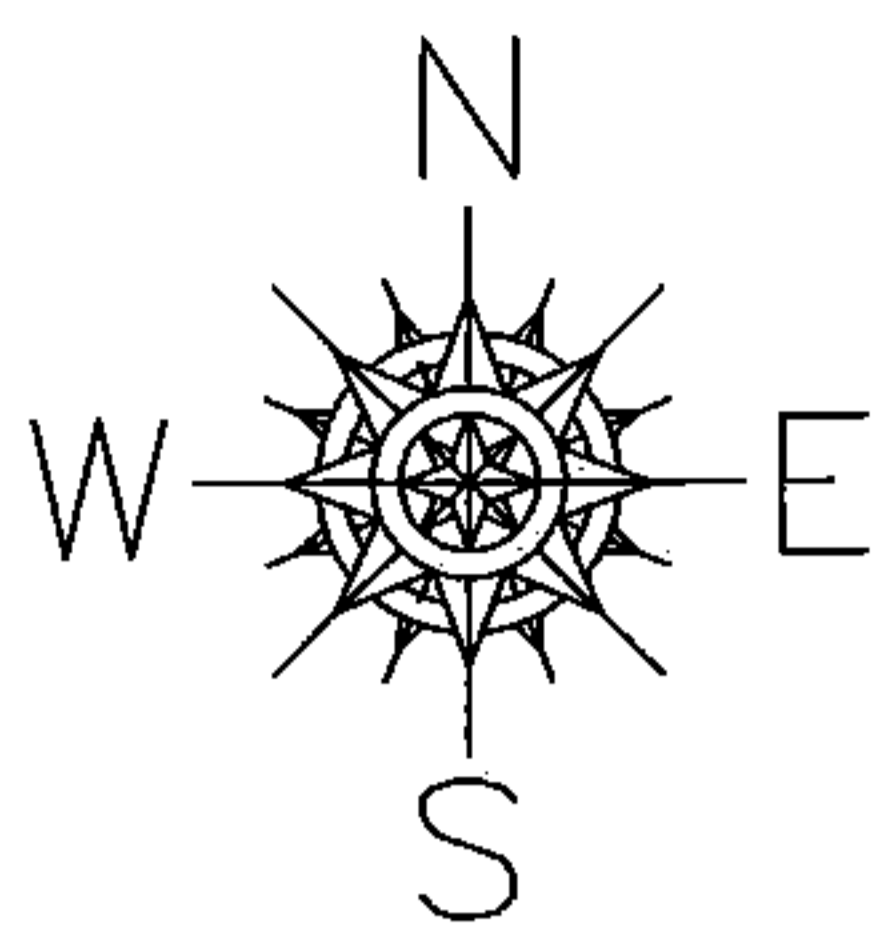

LOR-SHEFFIELD TWP. SRTS  
8-WDV

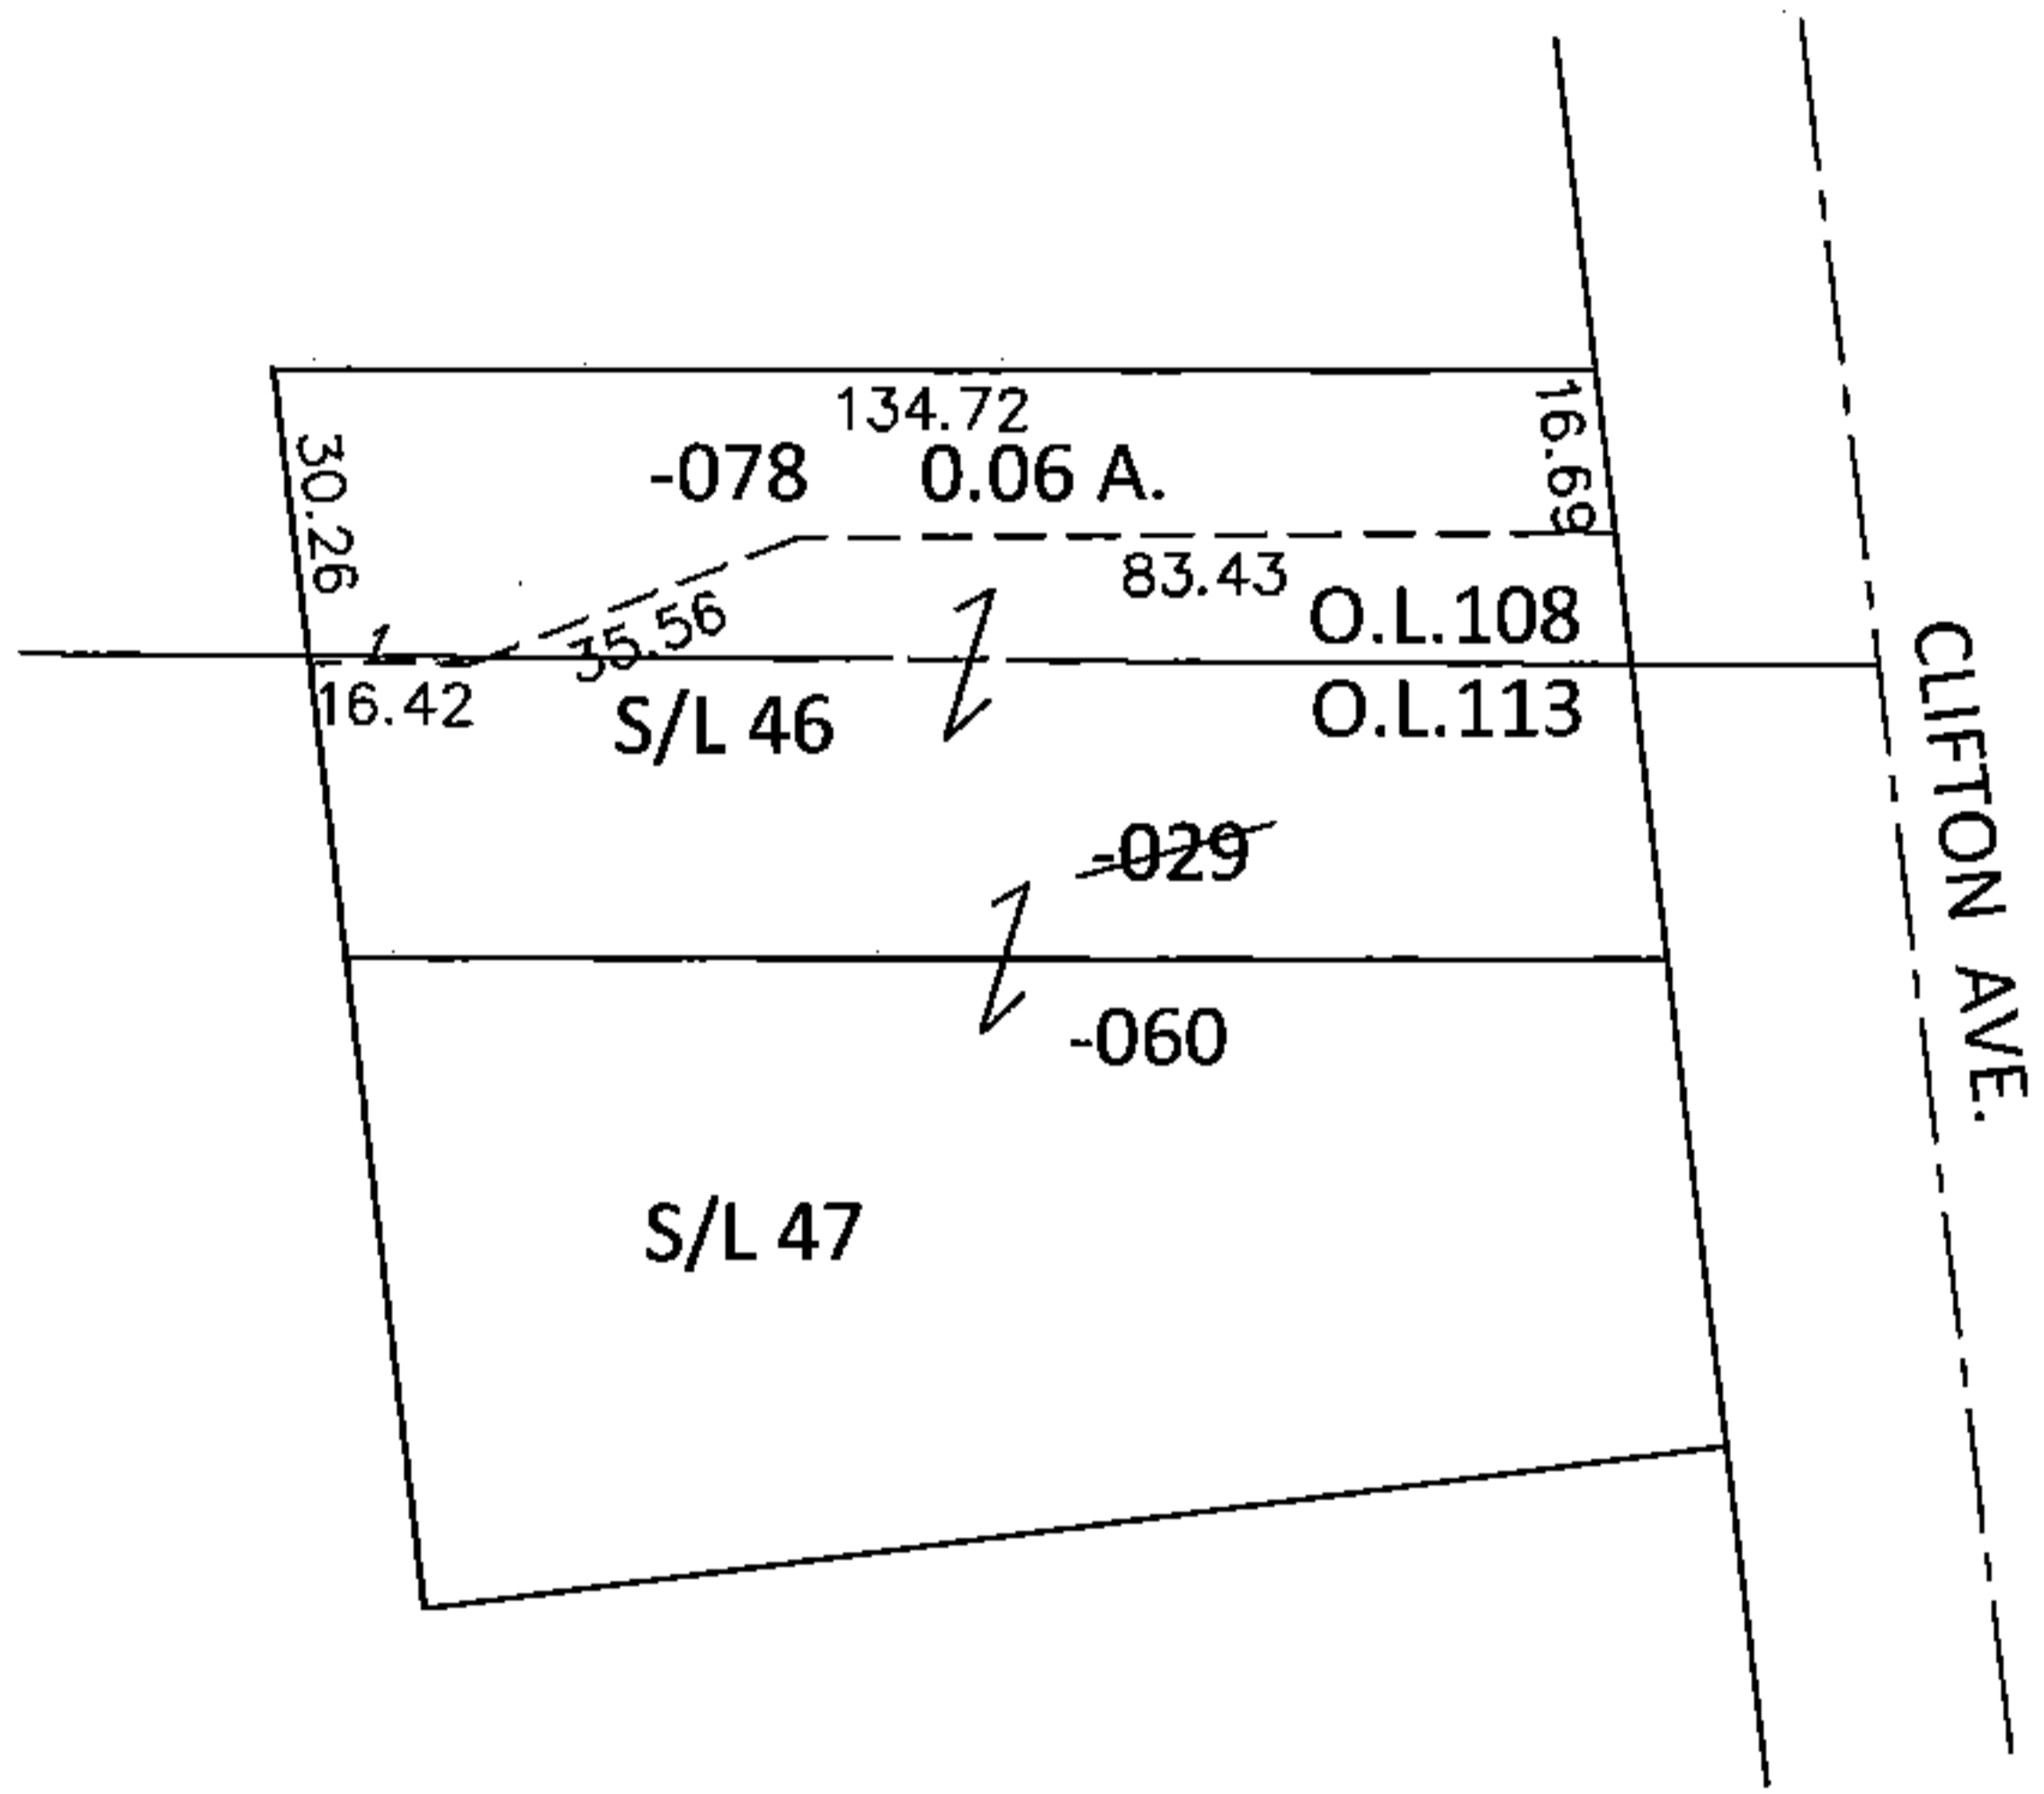

~~03-00-113-106-029~~  
~~110.47 X 134~~  
03-00-108-111-078      03-00-113-106-060  
0.06 A.                      93.78 X 135.41

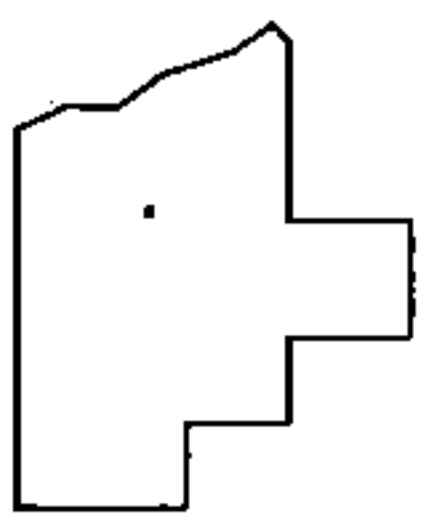

**SPLITS/DEEDS PROCESSED**  
LORAIN COUNTY TAX MAP DEPARTMENT  
226 MIDDLE AVE. ELYRIA, OHIO

SURVEYED BY: AMY BERNICKEN  
CLOSURE: .00:10,000  
MAP PAGE(S): 3-00-113-B  
APPROVED BY: RRM      DATE: 2-26-15  
SCALE: 1"= 50'      PRIOR INST.: 20070233114