
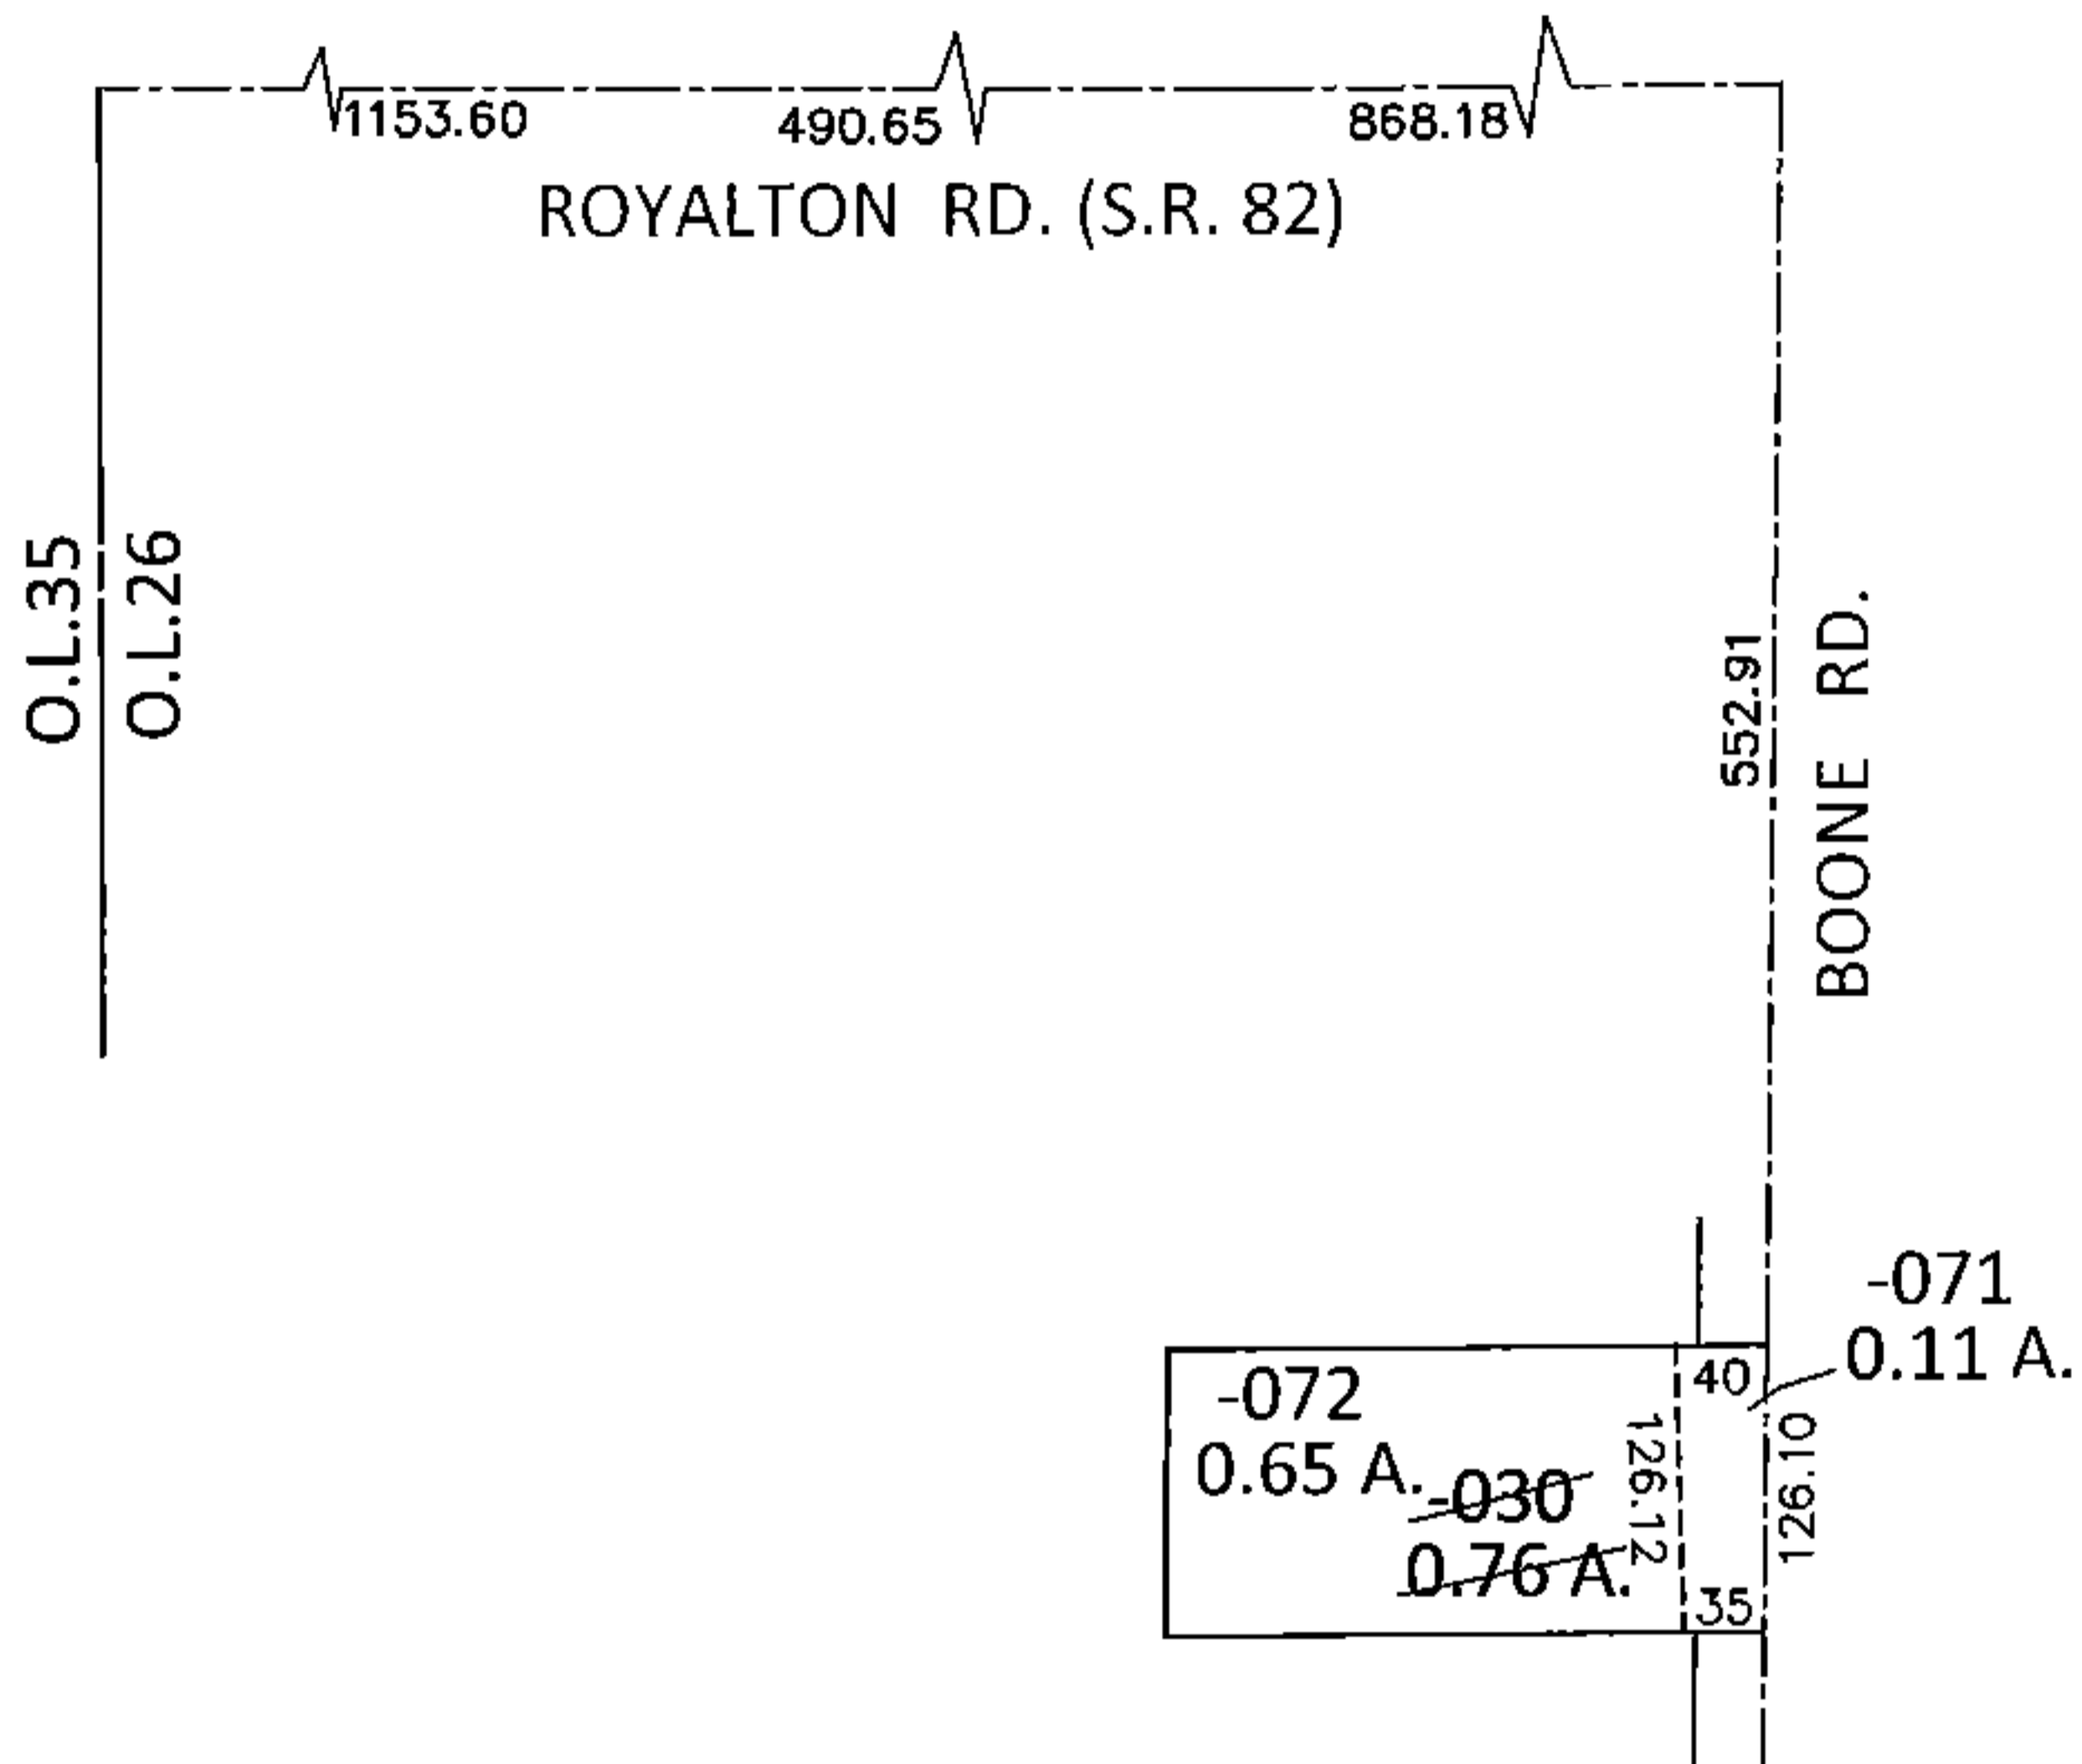


PARENT PARCEL: 12-00-026-000-030

CHILD PARCEL: 12-00-026-000-071, -072


STARTING POINT: INTERSECTION OF C/L OF S.R. 82 AND WEST LINE OF O.L.26

15-00720

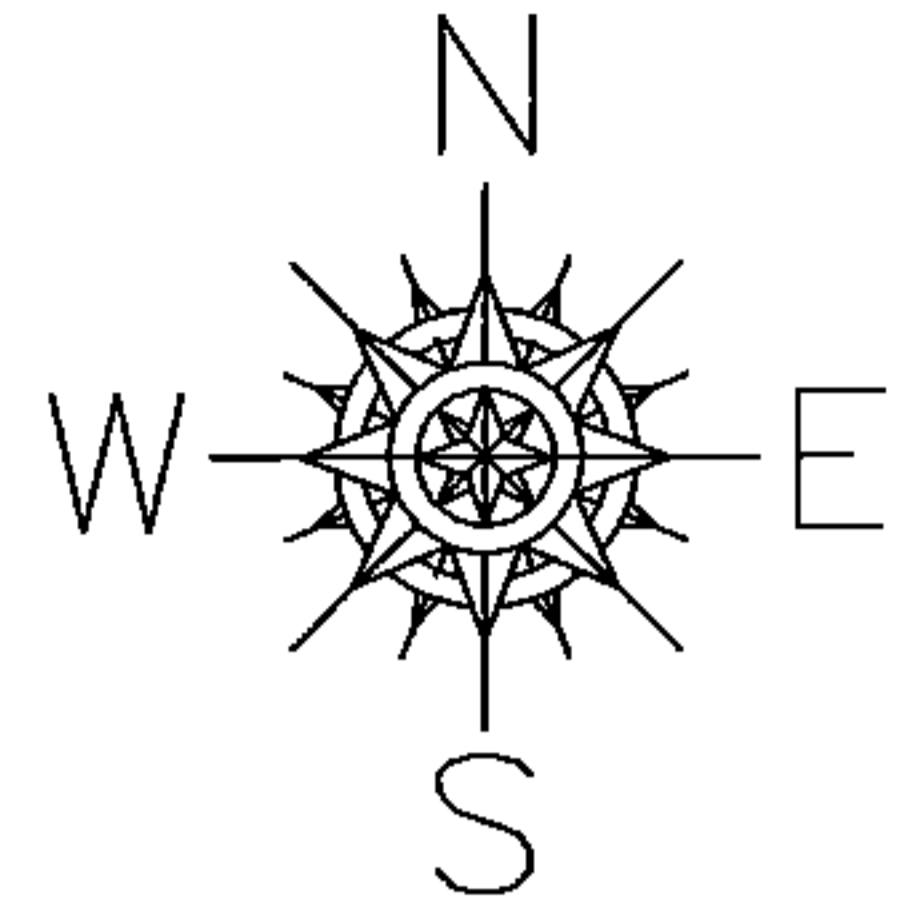

LOR-82-8.98

73-WD1

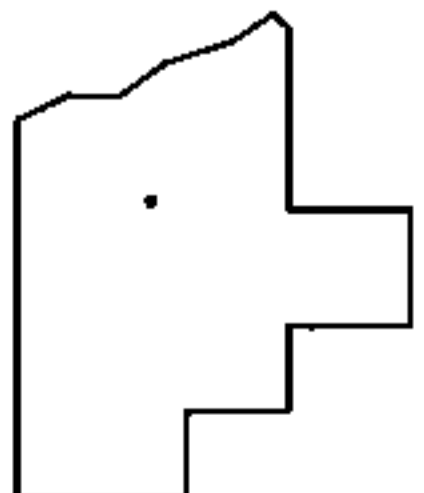

SPLITS/DEEDS PROCESSED

LORAIN COUNTY TAX MAP DEPARTMENT
226 MIDDLE AVE. ELYRIA, OHIO

SURVEYED BY: AMY M. KELLY

CLOSURE: .01:10,000

MAP PAGE(S): 12-00-026-B

APPROVED BY: RRM DATE: 4-2-15

SCALE: 1"=200 PRIOR INST.: 20120428287