
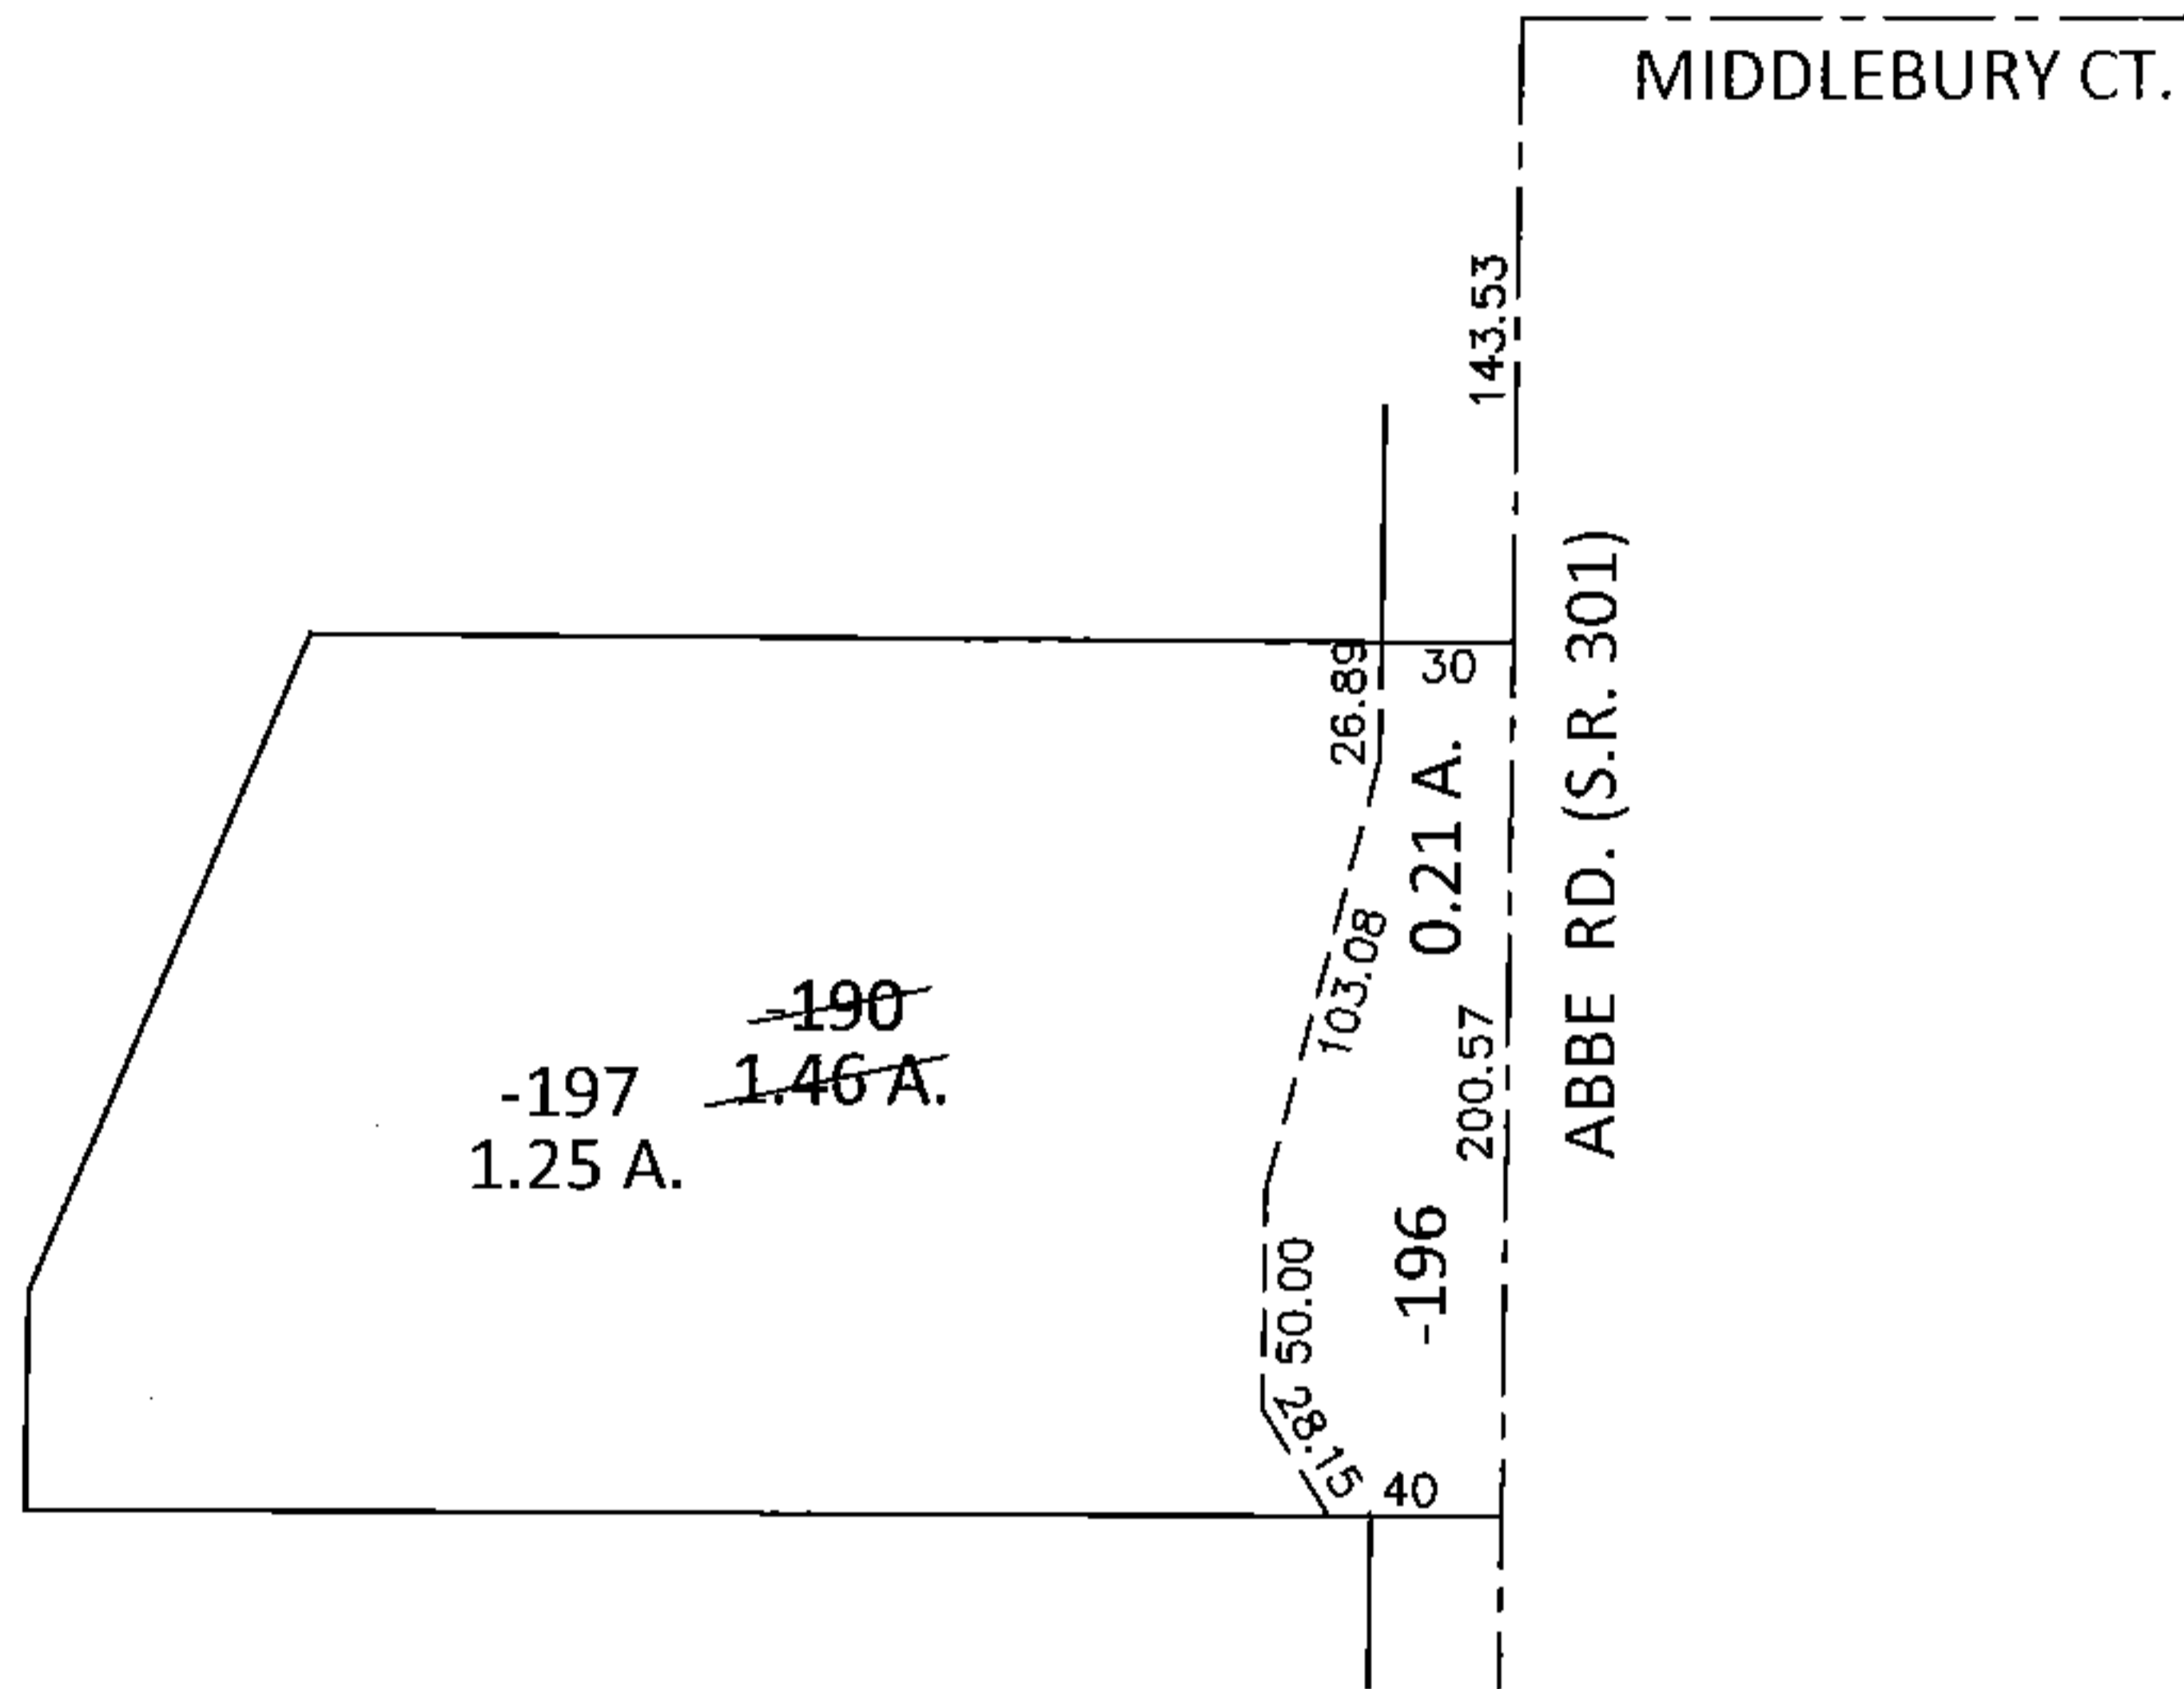


PARENT PARCEL: 03-00-012-000-190


CHILD PARCEL: 03-00-012-000-196, -197

STARTING POINT: INTERSECTION OF C/L OF S.R.301 AND C/L OF MIDDLEBURY CT.

15-00729

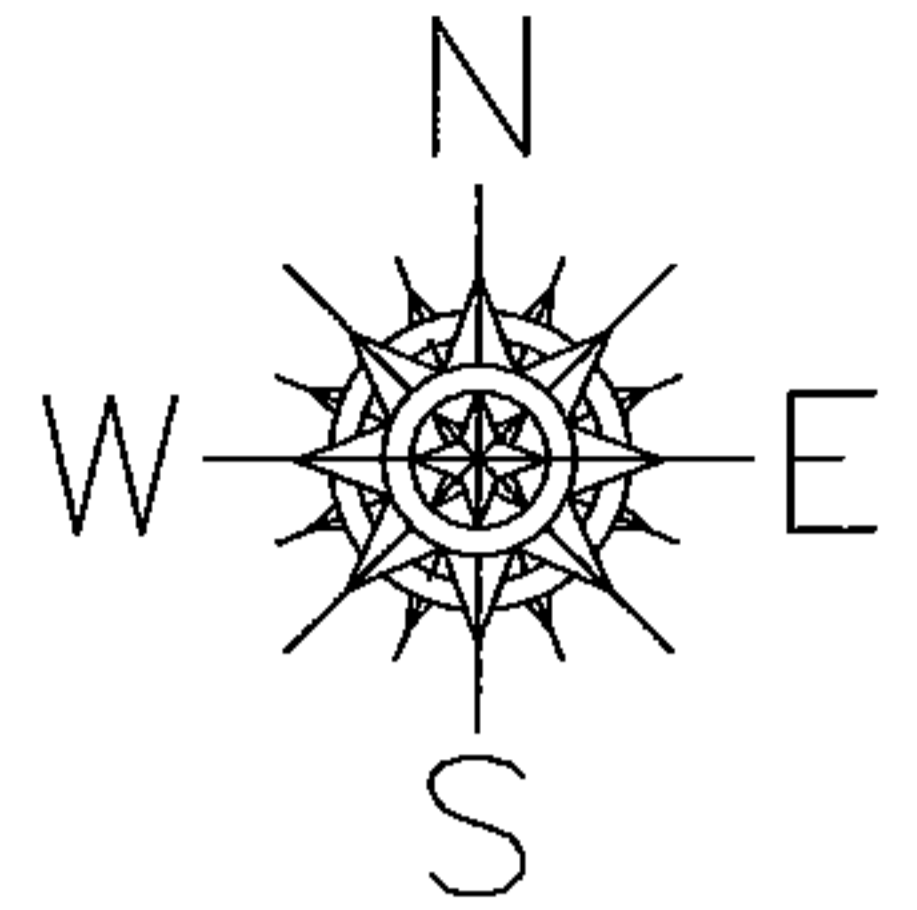

LOR-301-22.56
14-WD

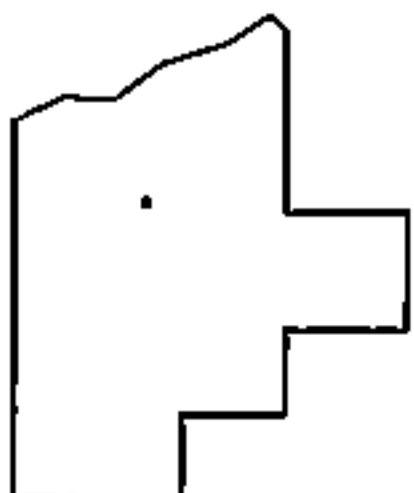

SPLITS/DEEDS PROCESSED

LORAIN COUNTY TAX MAP DEPARTMENT
226 MIDDLE AVE. ELYRIA, OHIO

SURVEYED BY: ROBERT J. MCAULEY

CLOSURE: .01:10,000

MAP PAGE(S): 3-00-012-B

APPROVED BY: RRM DATE: 7-21-15

SCALE: 1"= 100 PRIOR INST.: 20060152892