



1920

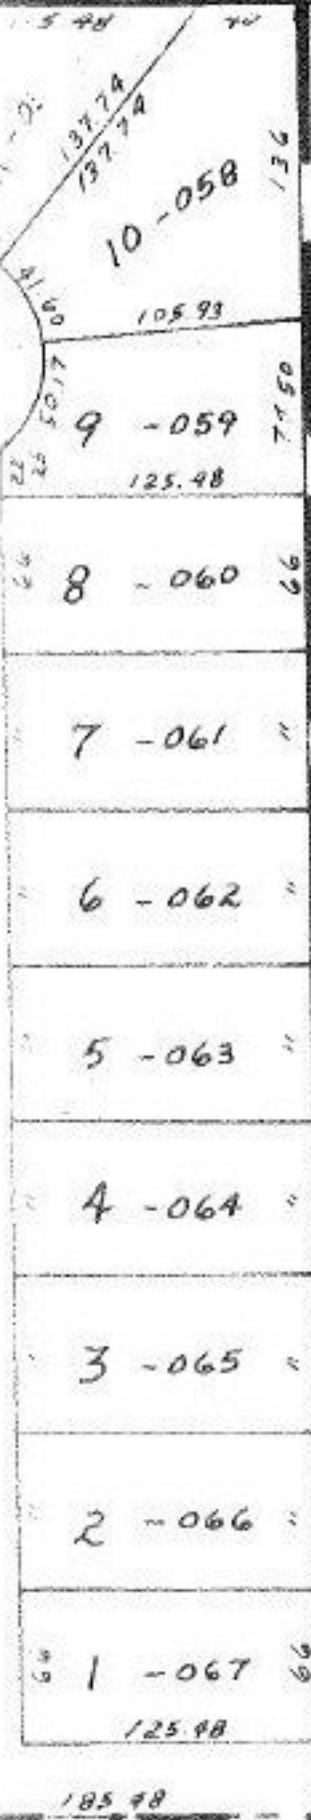

-117
10.65A

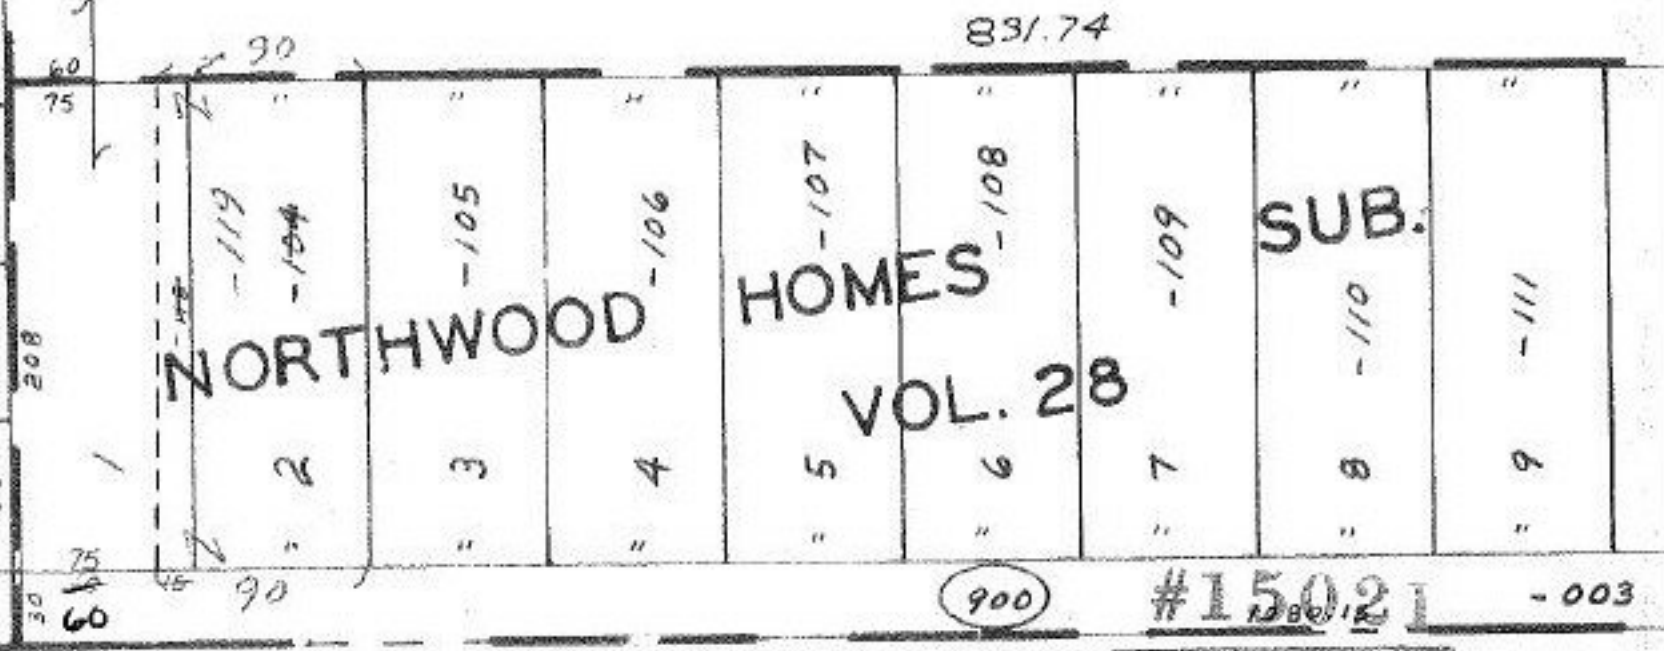

NORTHWOOD HOMES VOL. 28 SUB.

900 #15021 -003

SEE 11-00-081

JUN 10 1983



APPROVED
LORAIN CO.
MAP DEPT.
DATE 3-17-83
PAGE 11-00-082
BY C. Francis
VOID
OFFICE