


SEE 3-00-095-L

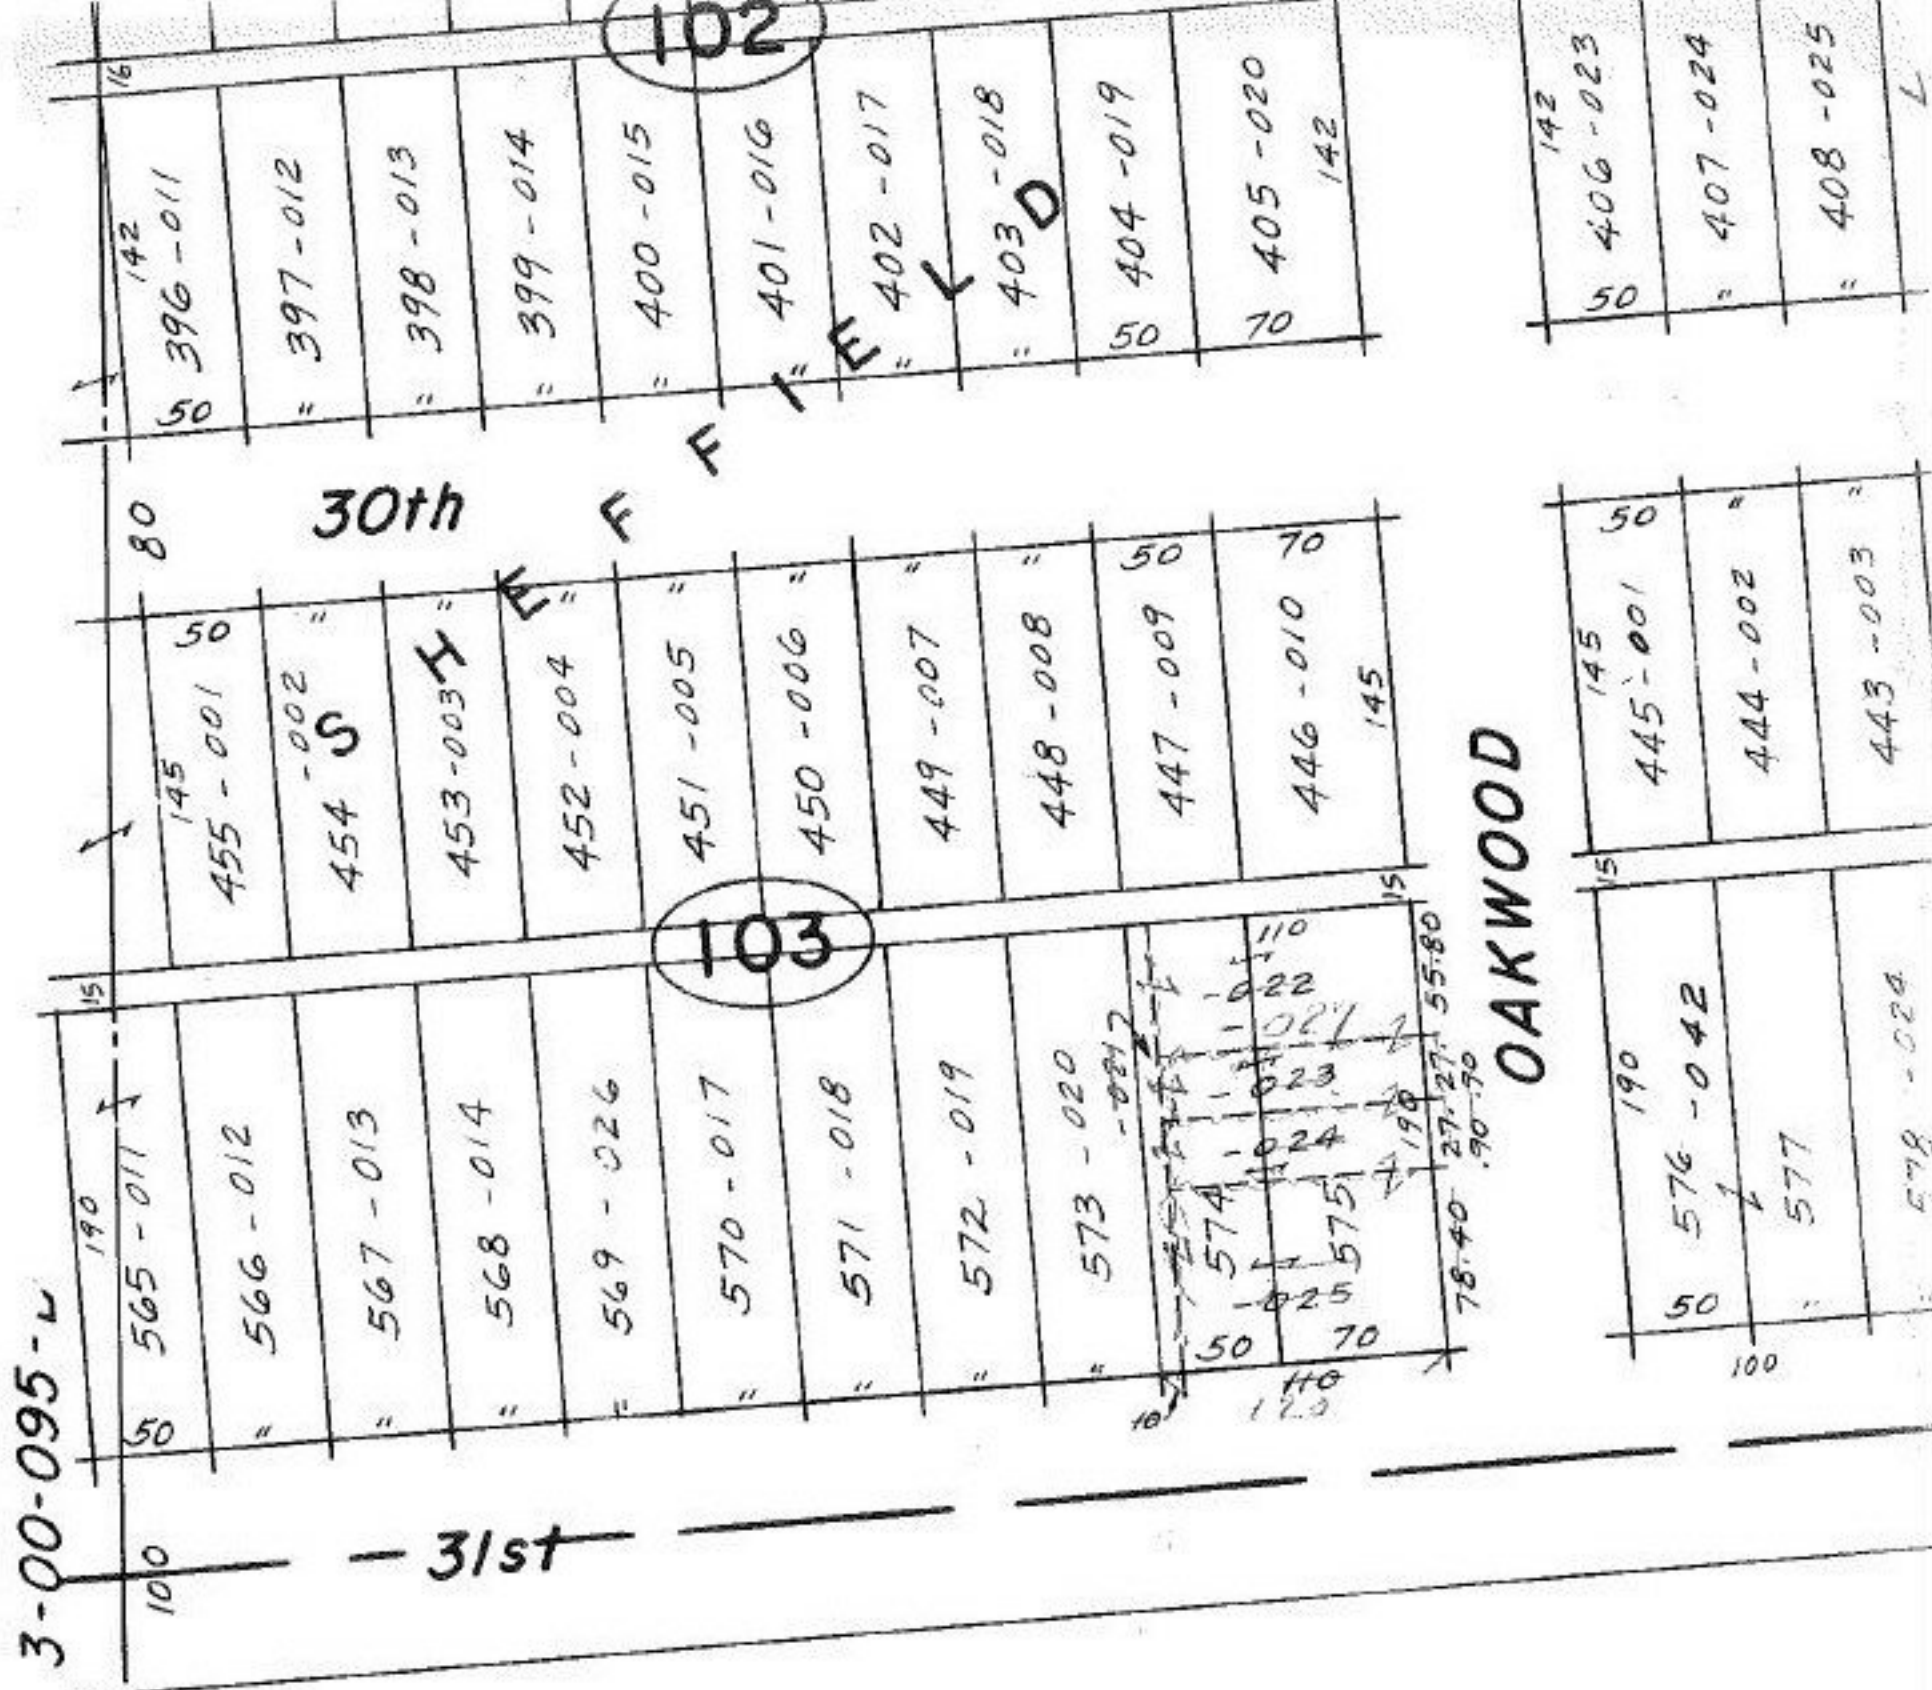

"Combination Only"

#15024

T.M.
5.12.83

APPROVED LORAIN CO. MAP DEPT.	
DATE 3-21-83	
PAGE 3-00-094-A	
BY C. FRANKS	
VOID AFTER	