

382 34

- 014
28 40A

SQUIRES

840 84
739.12

1419
1387.78

~~840 84~~
~~27.13A~~
- 008
24.26 A

1386.43

- 005
29 00A

739.12
840 84
885 72

1373.48
1320

942.56
27
840 84
1683

~~840 84~~
~~27.13A~~
- 007
30.00 A

840 84
942.56

1386.43

- 006
51.00A

- 004
17.00A

- 003
9.77A


840 84

RD

1387.78
1321.98 D

1320

Boone & Co. P6-12-G

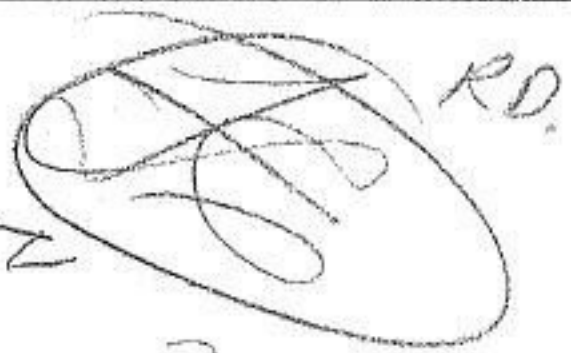

DONE 6/16/68 W. L. ...
12-00-027-00C

APPROVE
LORAIN CO.
MAP DEPT.
DATE 1-20-68
BY [Signature]