


83

RD.

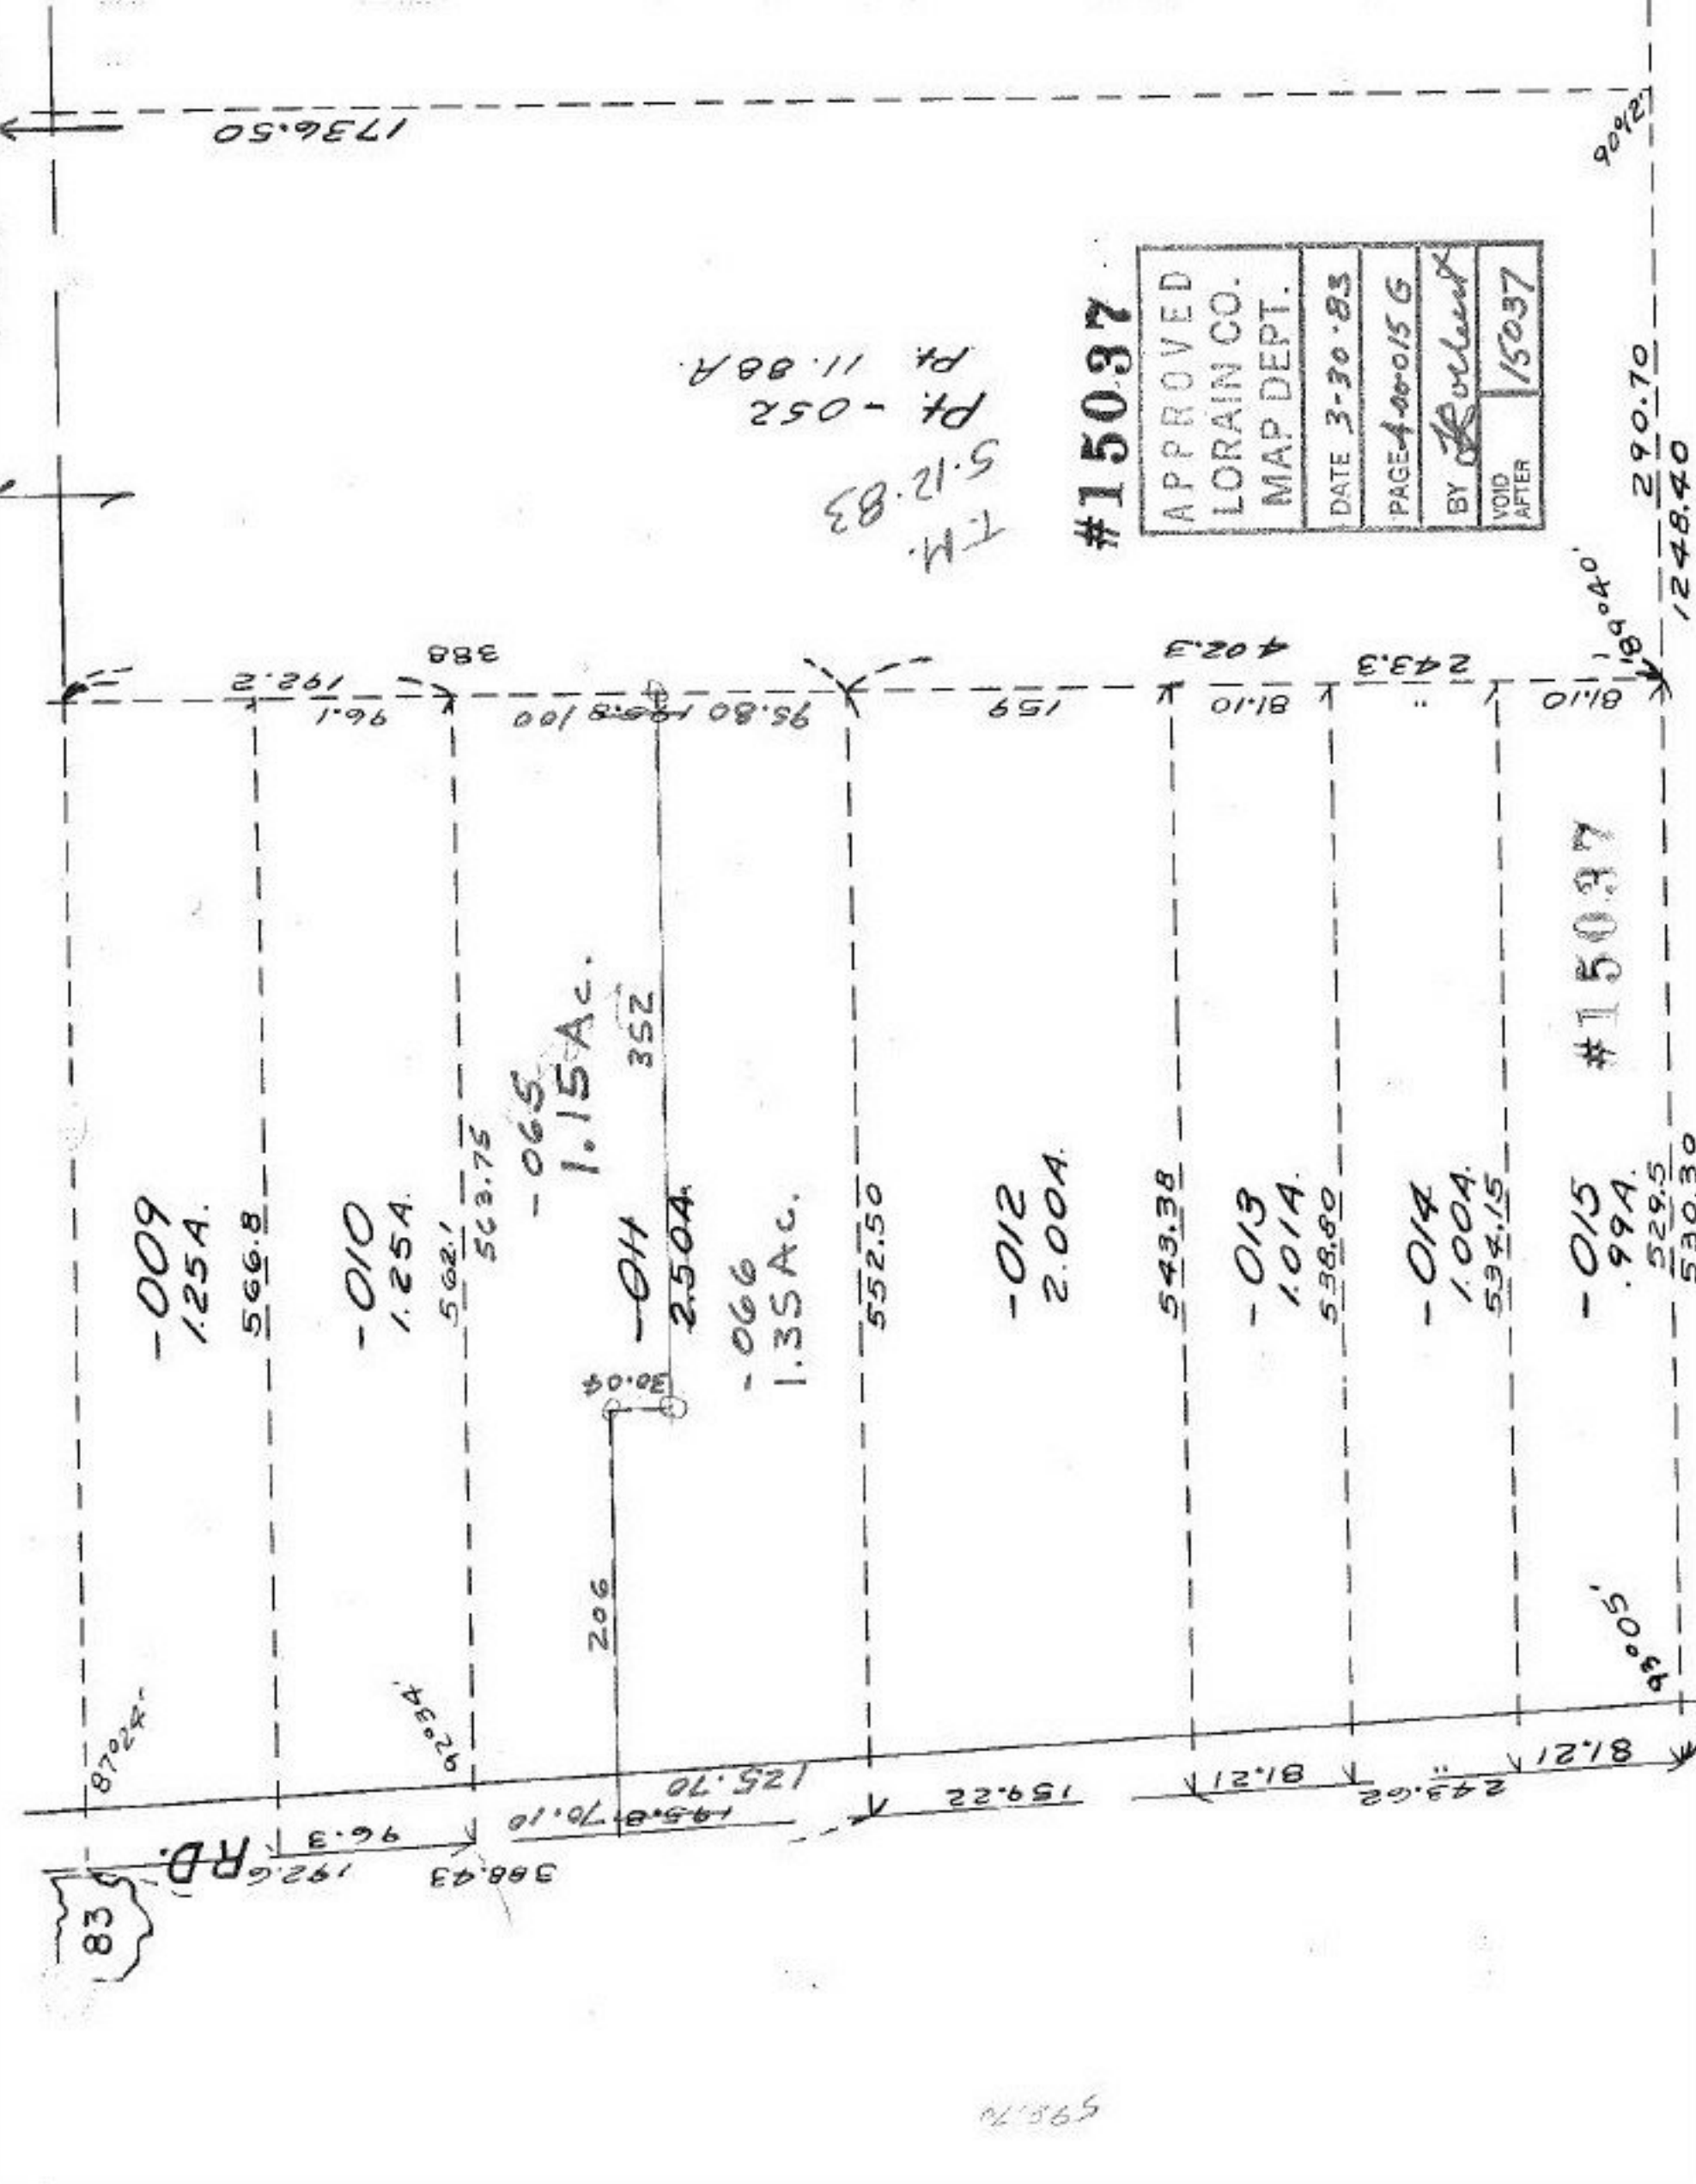

T.M. 83
 5.12.83
 Pt - 052
 Pt 11.88A

#15037

APPROVED	
LORAIN CO.	
MAP DEPT.	
DATE	3-30-83
PAGE	4000156
BY	<i>[Signature]</i>
VOID AFTER	15037

598.70