


75 55 -004
 73 56 -002
 75 57 -001
 75 58 -001
 155
 VALLEY -001
 75 33 VALLEY'S
 34 009
 155
 35 -010
 158.6
 36 -011
 174.1
 75 37 -01
 192.1
 38 -0
 119.77

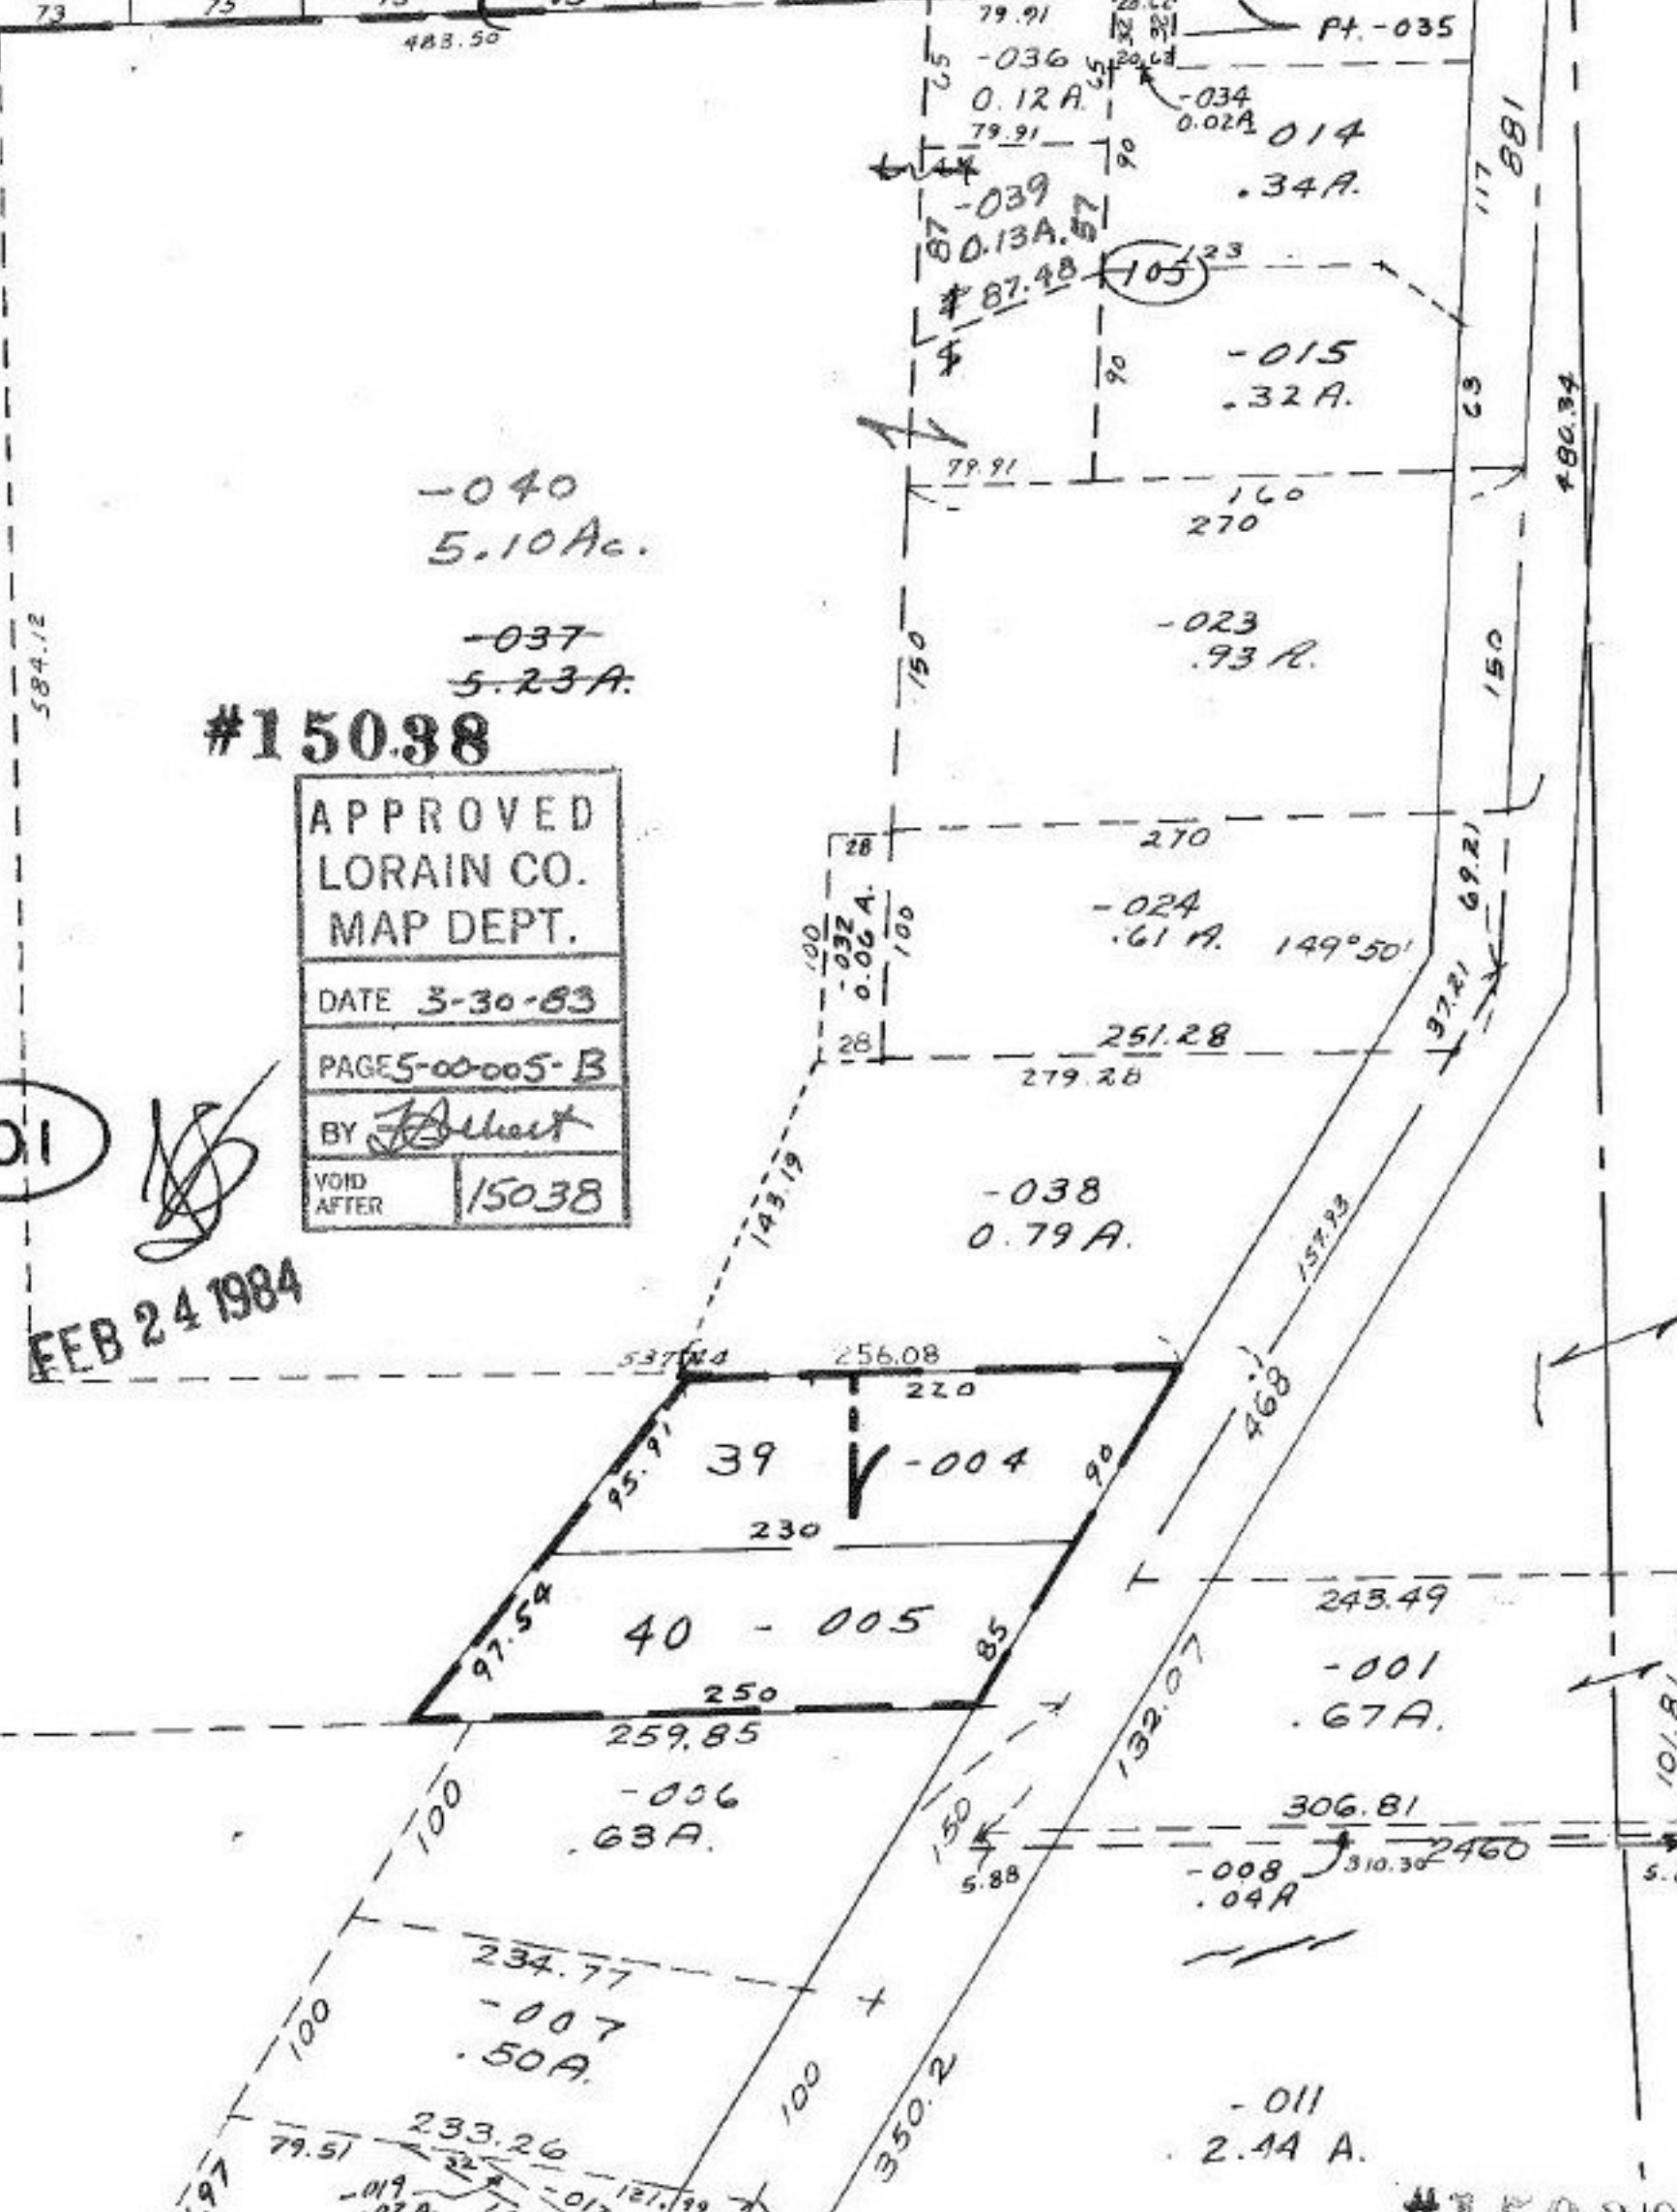

#150.38

APPROVED
 LORAIN CO.
 MAP DEPT.
 DATE 3-30-83
 PAGE 5-00-005-B
 BY *J. Albert*
 VOID AFTER 15038

101

FEB 24 1984

#150.38