


APPROVED
 LORAIN CO.
 MAP DEPT.
 DATE 1-20-68
 5051H
 [Signature]

7-29-86
 J.W.

16. 10-00-016-F
 #1504

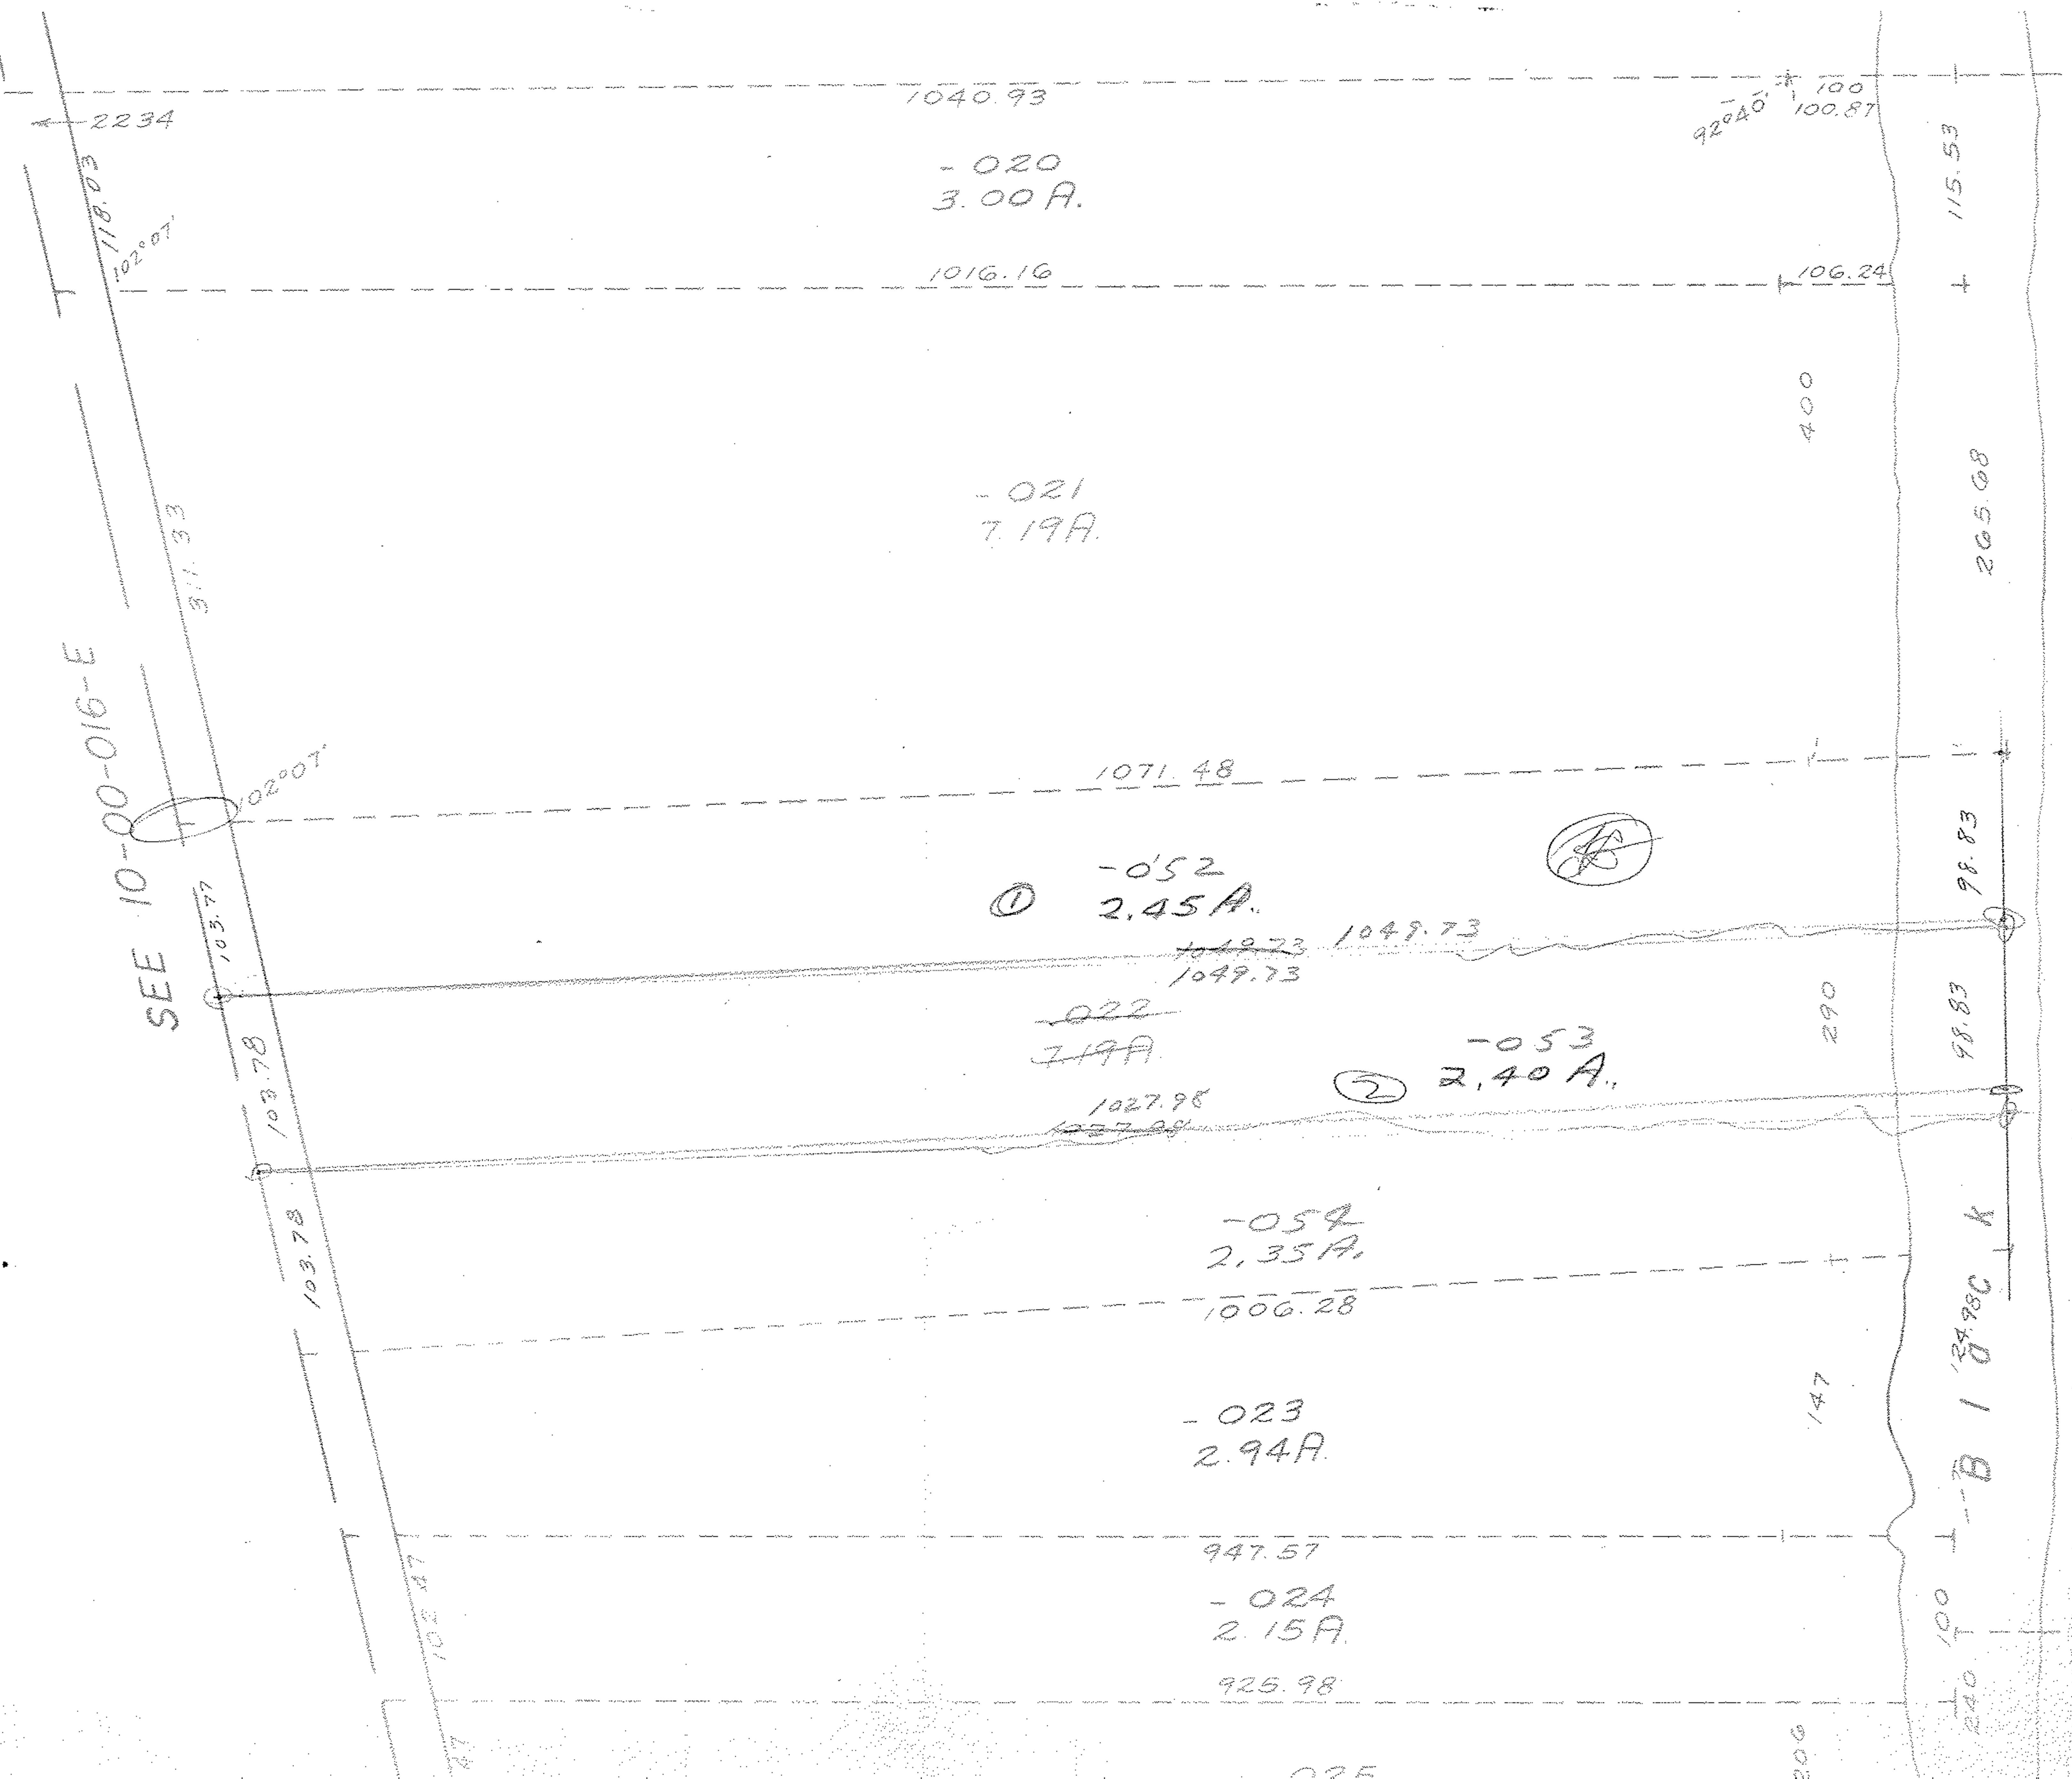

SEE 10-00-016-E

100 240
 124980 K