
437.83

-038

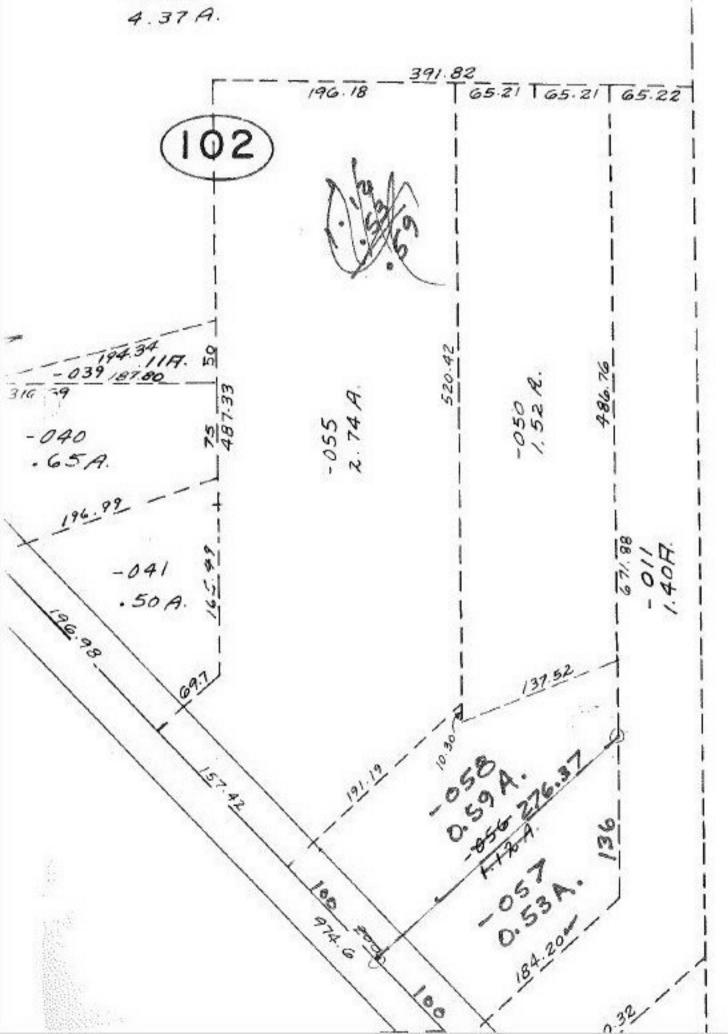

T.M. 83

#15052

APPRO	V CO.
MAP D	V. 115 - CO. W. C. V. C. V
PAGE 4-00-012 A BY FE allest	
-	5052